

Revised copy (not to scale)

SE1/4 SEC.22 T7S R2W WM, MARION COUNTY

7 2W 22D

30

LEGEND


- LINE TYPES**
- TAX LOT BOUNDARY OLD PROPERTY LINE
 - ROAD RIGHT-OF-WAY VACATED RIGHT-OF-WAY
 - RAILROAD RAILROAD RIGHT-OF-WAY
 - STREAM, LAKE, ETC. TAX LOT BOUNDARY STREAM, LAKE, ETC. NON-BOUNDARY
 - SUBDIVISION BOUNDARY PARTITION PLAT BOY.
 - TAX CODE BOUNDARY EASEMENT

- SYMBOL TYPES**
- D.L.C.
 - CONTROL POINTS
 - SURVEY MONUMENTS
 - G.L.O. CORNERS
- SECTION 1/4 SEC 1/8 SEC
1/4 COR 1/8 COR

NUMBERS
TAX CODE NO.
000 00 00 0

ACREAGE - ALL ACREAGES EXCLUDE ANY PORTION THAT MAY LIE WITHIN THE INDICATED PUBLIC RIGHT OF WAYS

TICK MARKS - WHEN A TICK MARK IS INDICATED ON THE EXTENSION OF A LINE, THEN THE DIMENSION GOES TO THE TICK MARK. GENERALLY THIS IS USED WHEN DIMENSIONS GO INTO PUBLIC RIGHT OF WAYS.

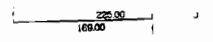

ARROWS ARE USED WITH DIMENSIONS IN AREAS OF GREATER COMPLEXITY.

NOTICE: This map was created for Assessor's Office use ONLY.




Map No. 16793



SCALE 1" = 200'
OF 1:2400

Plot file created: November 20, 2006

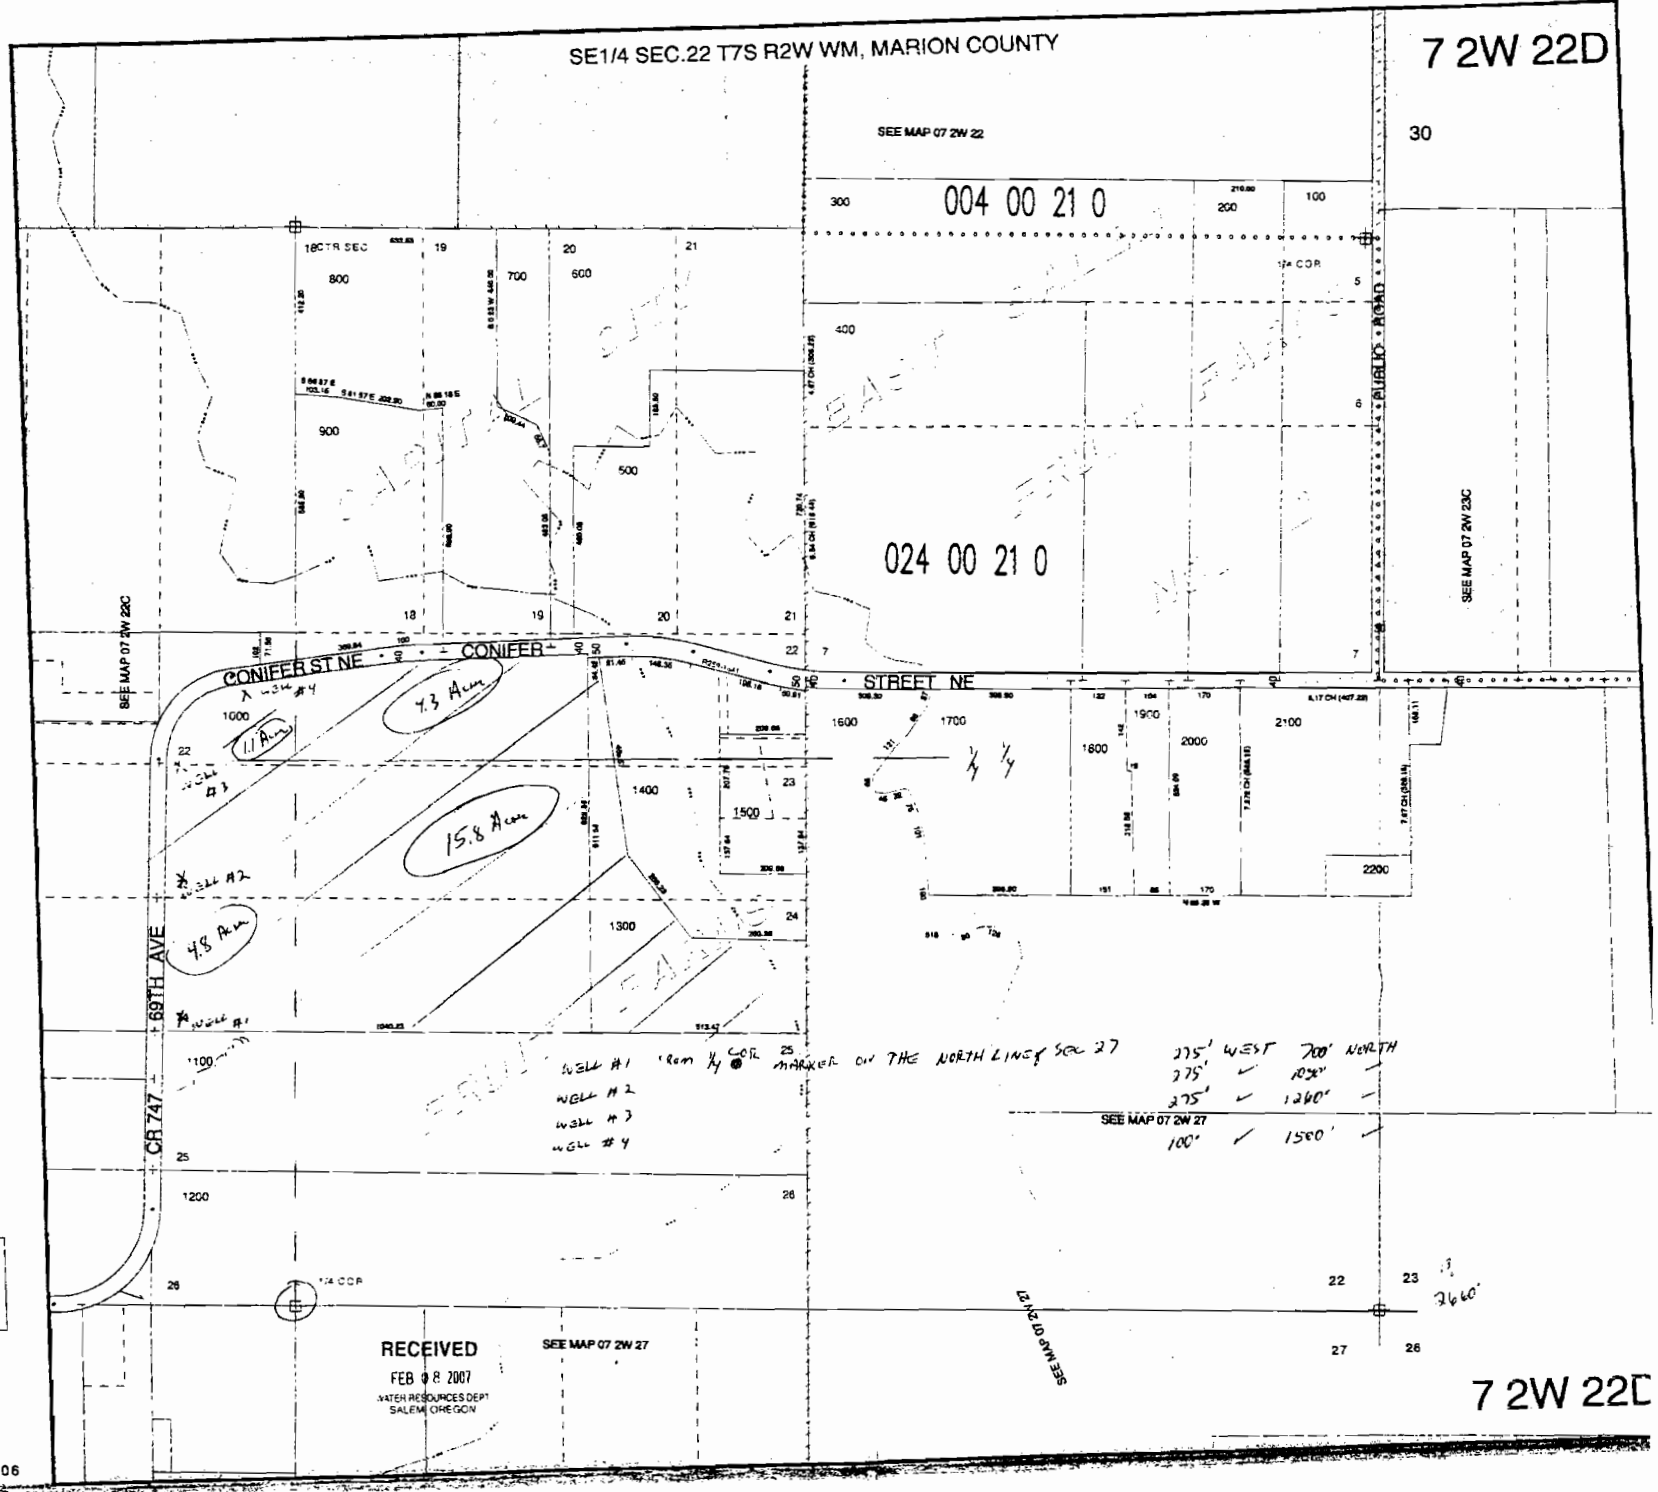

RECEIVED
FEB 08 2007
WATER RESOURCES DEPT
SALEM, OREGON

SEE MAP 07 2W 27

