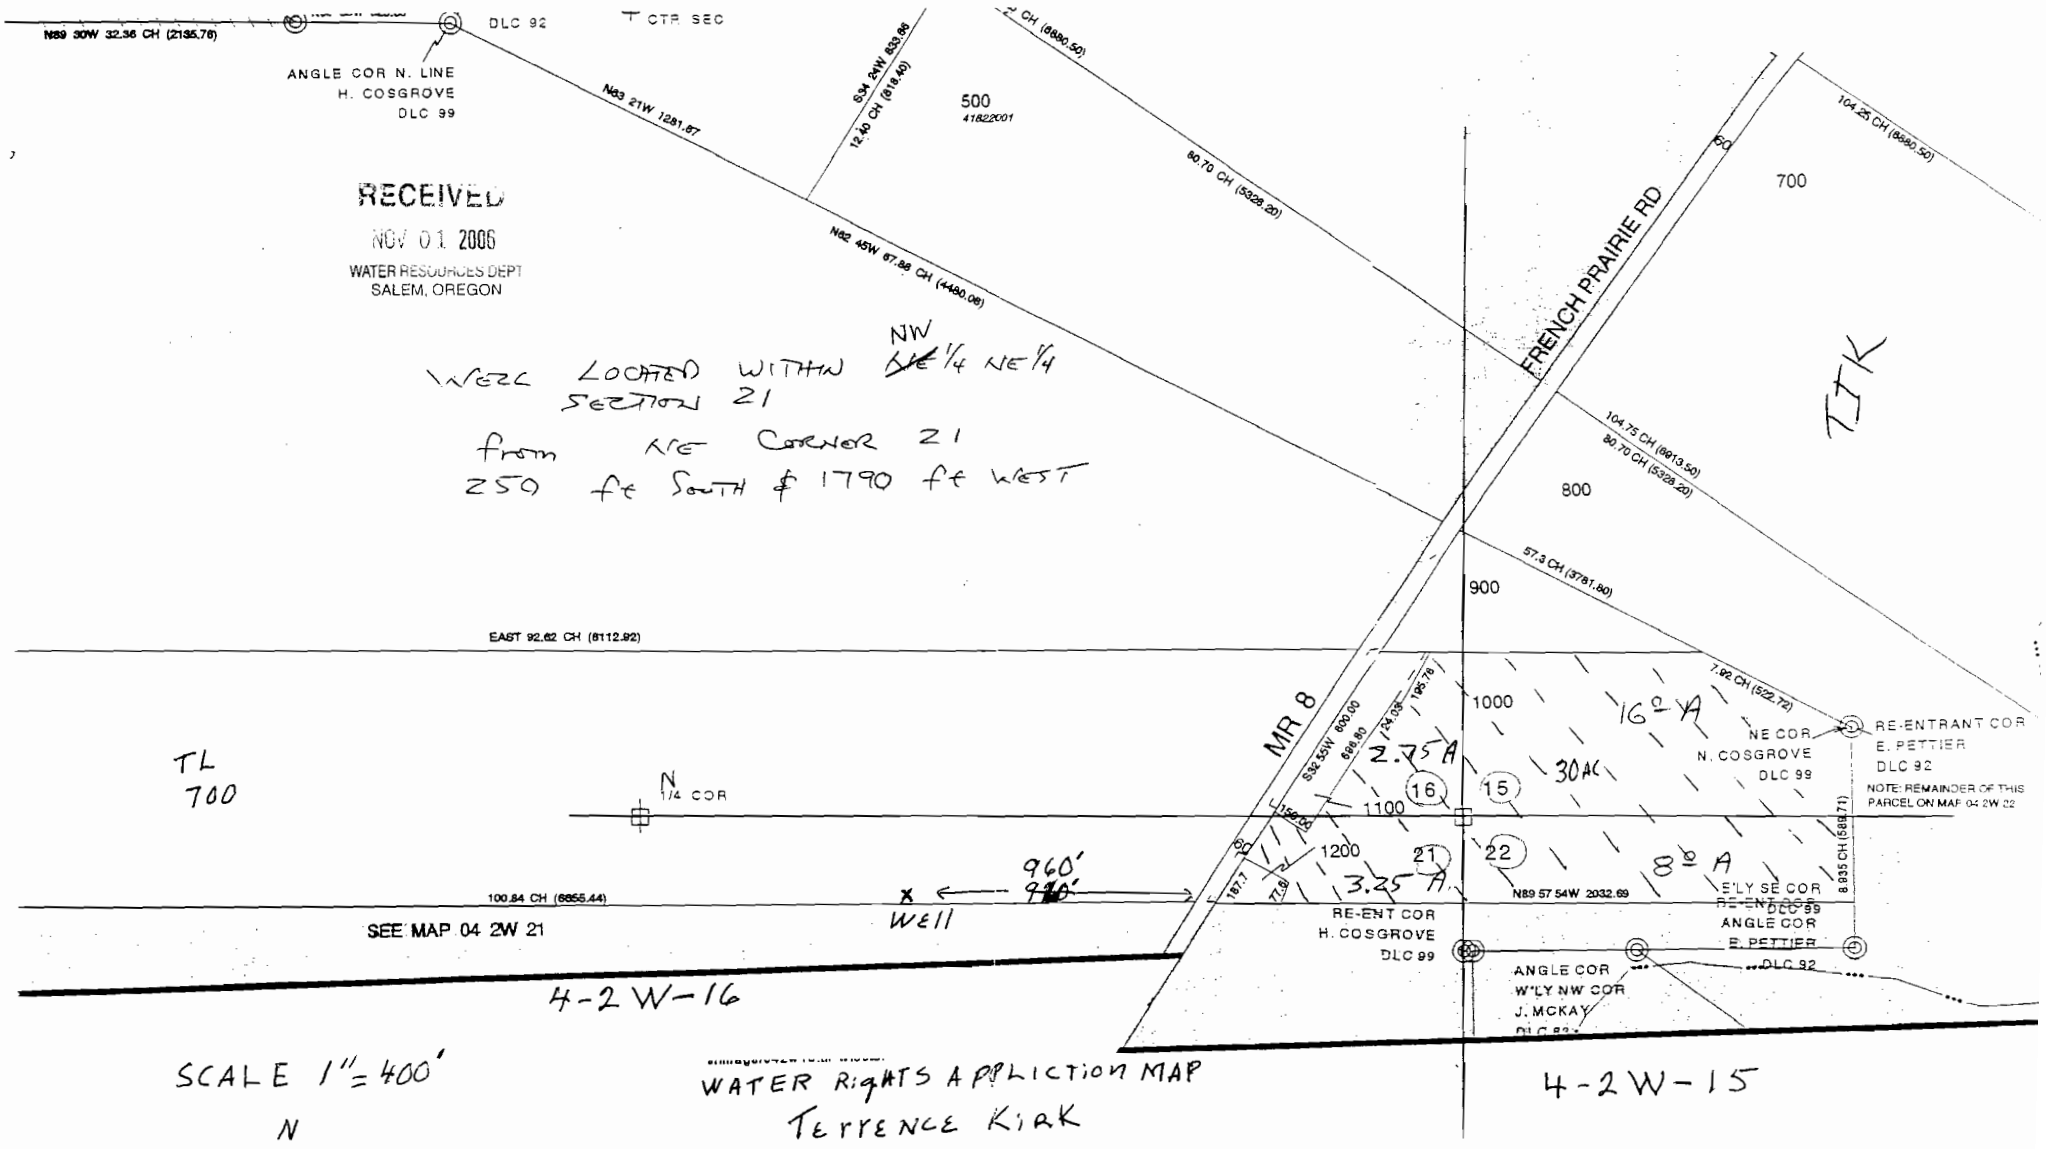

WELL LOCATED WITHIN ~~NE~~ NW 1/4 NE 1/4
SECTION 21
from NE CORNER 21
250 ft SOUTH & 1790 ft WEST

RECEIVED
NOV 01 2006
WATER RESOURCES DEPT
SALEM, OREGON

SCALE 1" = 400'

N
W E
S

WATER RIGHTS APPLICTION MAP
TERRENCE KIRK

APP 06-16745