


T.38S.R.8W.W.M.

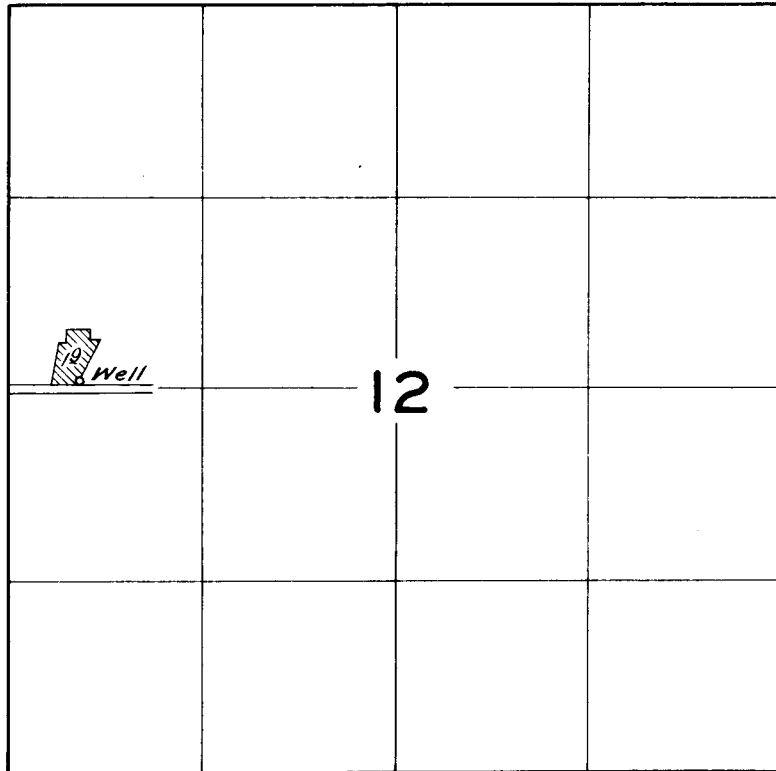

FINAL PROOF SURVEY  
UNDER

Application No. *G-1763* Permit No. *G-1629*  
IN NAME OF

*FRITZ KRAUSS*

Surveyed *April 20, 1961*, by *Ch. Bartels*