


T. 7S., R. 28 & 3 W., W.M.

RECEIVED

OCT 05 2006

WATER RESOURCES DEPT  
SALEM, OREGON

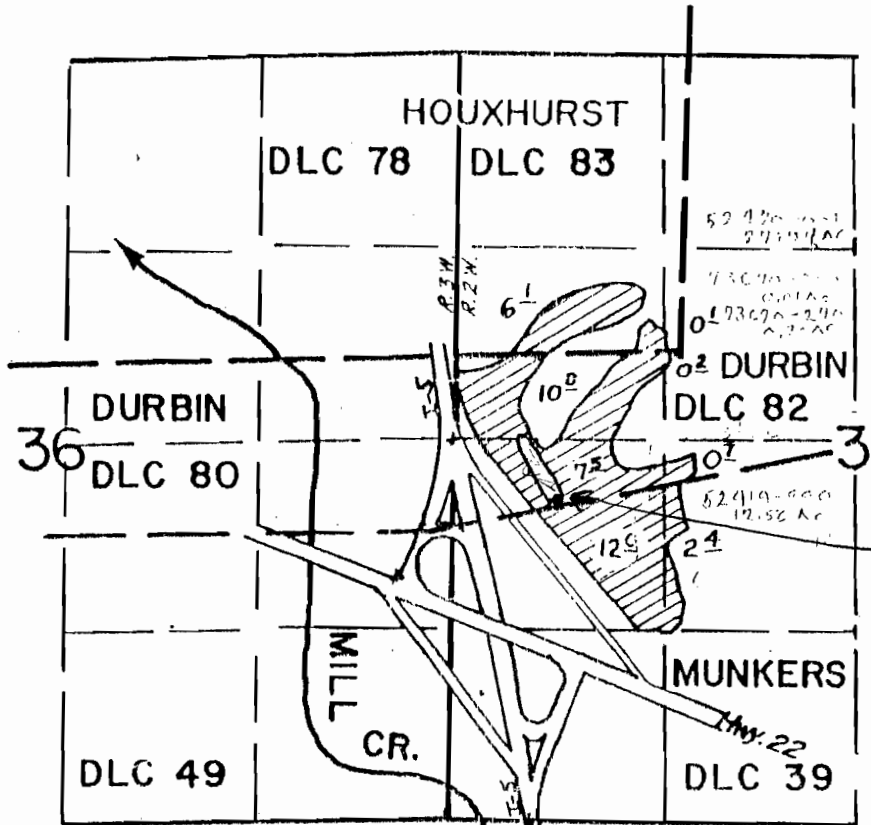

11.6  
 10.6  
 6.1  
 0.2  
 7.5  
 12.0  
 0.7  
 2.4  
 39.0  
 Proposed well #1

Proposed Well 1 is located 420 feet South and 700 feet East from the West  $\frac{1}{4}$  Corner, Section 31

**FINAL PROOF SURVEY**

TRANSFER F-7 UNDER PROOF 145

Application No. .... Permitt No. ....

IN NAME OF

**OHMART & CALABA**

Surveyed AUG 16 19 78, by S. APPLGATE

Water  
Right  
application  
Map

Meadowlawn  
Golf Course

NORTH SANTIAM RIVER SUPPLEMENTAL ADJUDICATION

app no G-16733