


Section 4 T.17S. R.4W.W.M.  
LANE COUNTY

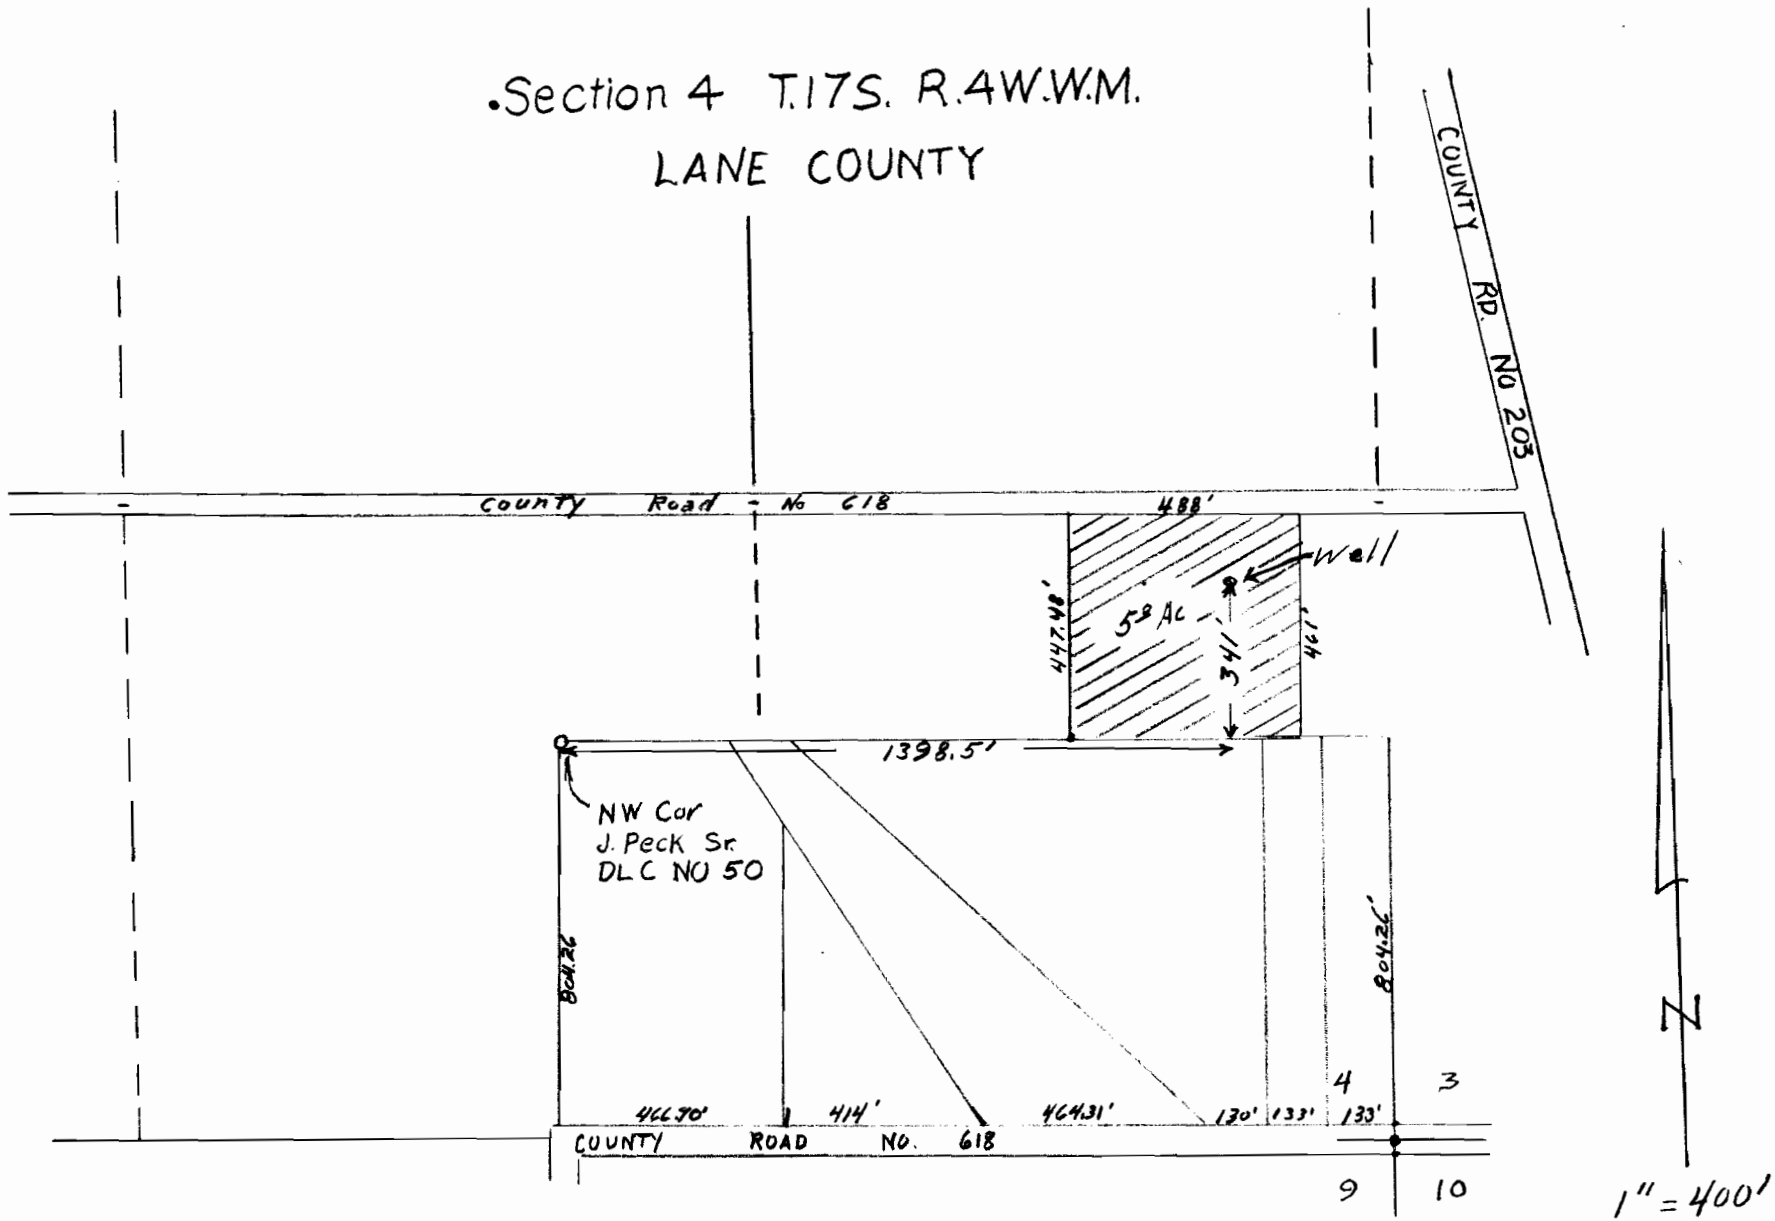

Application No. 6-1773  
Permit No. 6-1631