


6-106690

RECEIVED
JUN 19 2006
WATER RESOURCES DEPT
SALEM, OREGON


THIS MAP WAS PREPARED FOR
ASSESSMENT PURPOSE ONLY

SECTION 2 T.3S. R.26E. W.M.
MORROW COUNTY
1" = 400'

3S 26 2

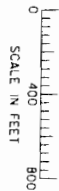

SEE MAP 35 26

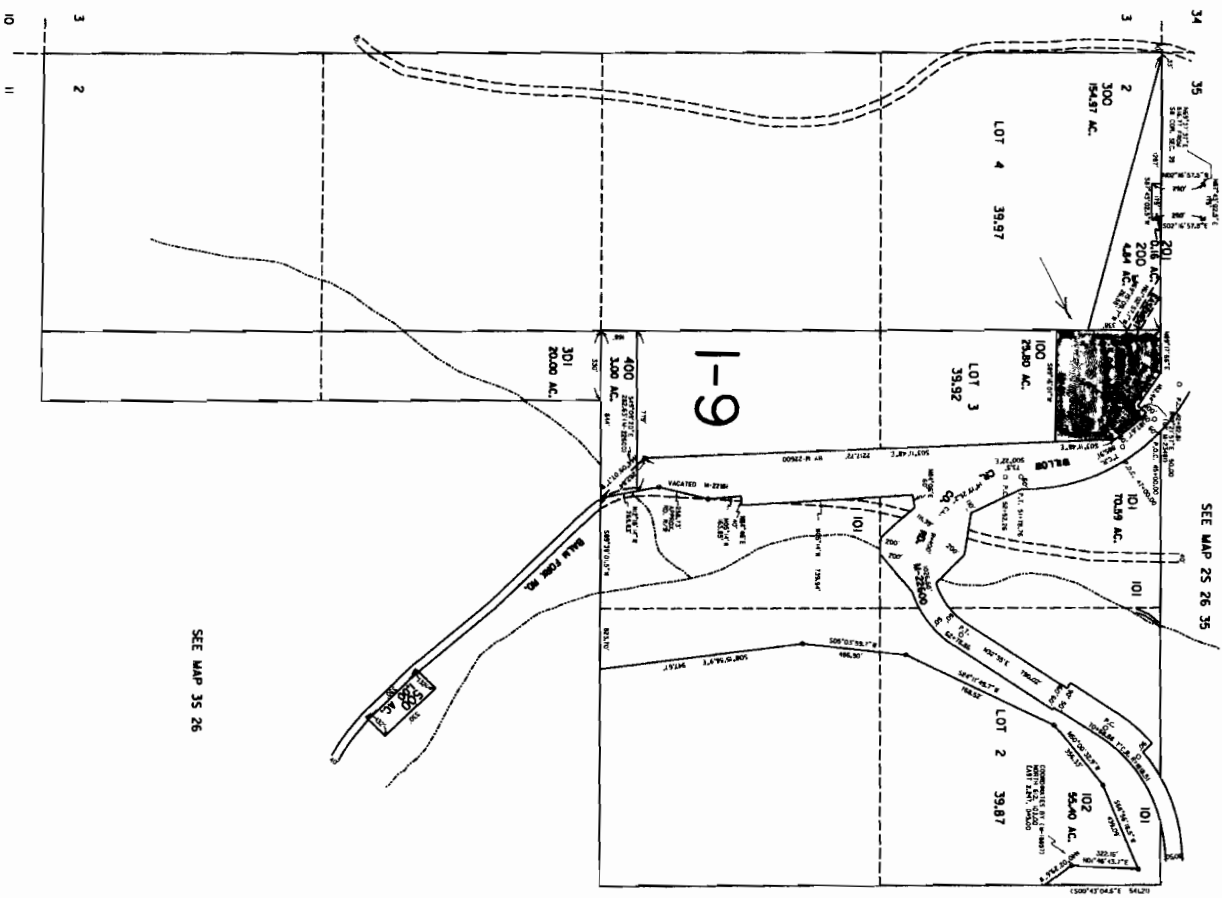

SEE MAP 35 26

SEE MAP 35 26



Revised
8/12/2005, KH
3S 26 2

34

35

36

3

320' Approx.

1760' (Approx.)

Well House & Power Pole - KERRER Well #5

2

3

1

AM Rox
SCALE
1" = 800 FT

WORK
COPY

RECEIVED
JUN 19 2006
WATER RESOURCES DEPT
SALEM, OREGON

SECTION 2 T 3 S. R 26 E. W.M.
Merrill P...L.

