


Township 4 North, Range 30, East, W.M.  
Umatilla County  
SCALE 1" - 1320'

WELL 1 - Located 790' N. & 250' E. of S. 1/4 Corner Sec. 17  
WELL 2 - Located 1200' N. & 130' E. of S. 1/4 Corner Sec. 17

MAP No. 4N 30

Tax Lot  
703  
2,652.29 Ac.

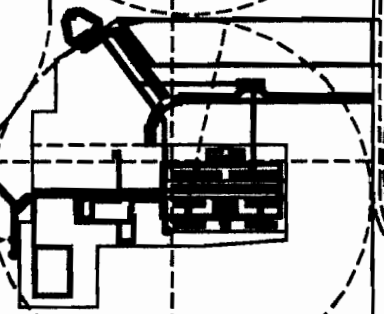

COMMUNITY SITE

DESPAIN GULCH

Water Rights Application Map  
for  
STAHL HUTTERIAN BRETHERN

Certified Water Right Examiner  
#202 WRE  
RONALD V. MCKINNIS  
NOV. 29, 1988  
STATE OF OREGON  
EXP 12-31-08

ENGINEERING - LAND SURVEYING - WATER RIGHTS  
**R. V. MCKINNIS ENGINEERING**  
79980 Prindle Loop Road  
Hermiston, Oregon 97838  
(541) -567-2017

DESPAIN GULCH ROAD

RECEIVED

JAN 16 2007

WATER RESOURCES DEPT  
SALEM, OREGON

app no G-16782