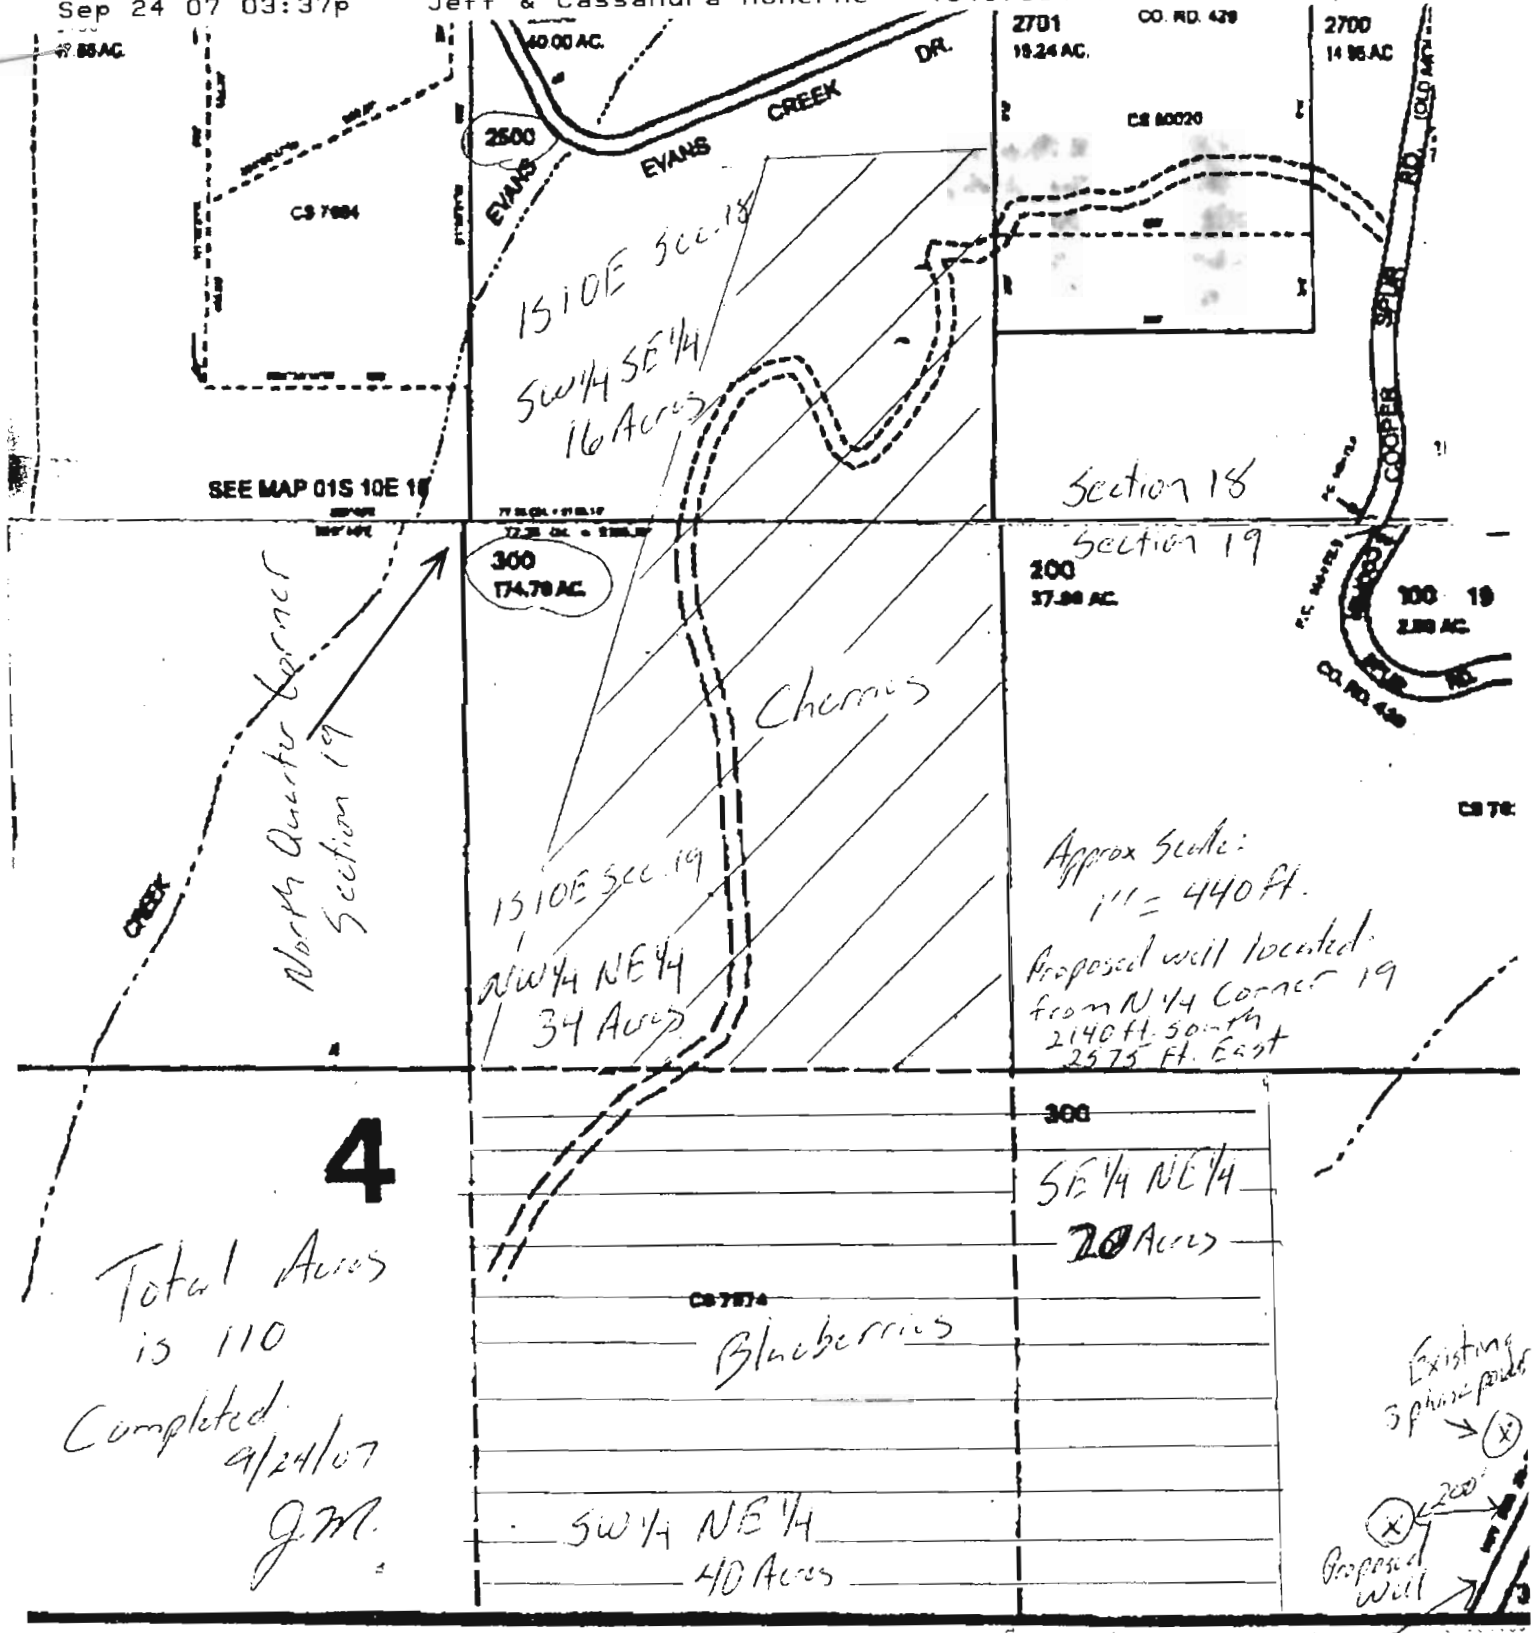

*Irrigation main lines will be determined by irrigation engineer once water rights are obtained

*Entire system will be drip irrigated

App No G-116933