

Steve Downer Property  
Township 6  
Range 2W  
Section 07  
Marion County  
Tax Lot 1200


RECEIVED

APR 30 2007

WATER RESOURCES DEPT  
SALEM, OREGON

NW  
SE  
TD

NE  
SE  
TD

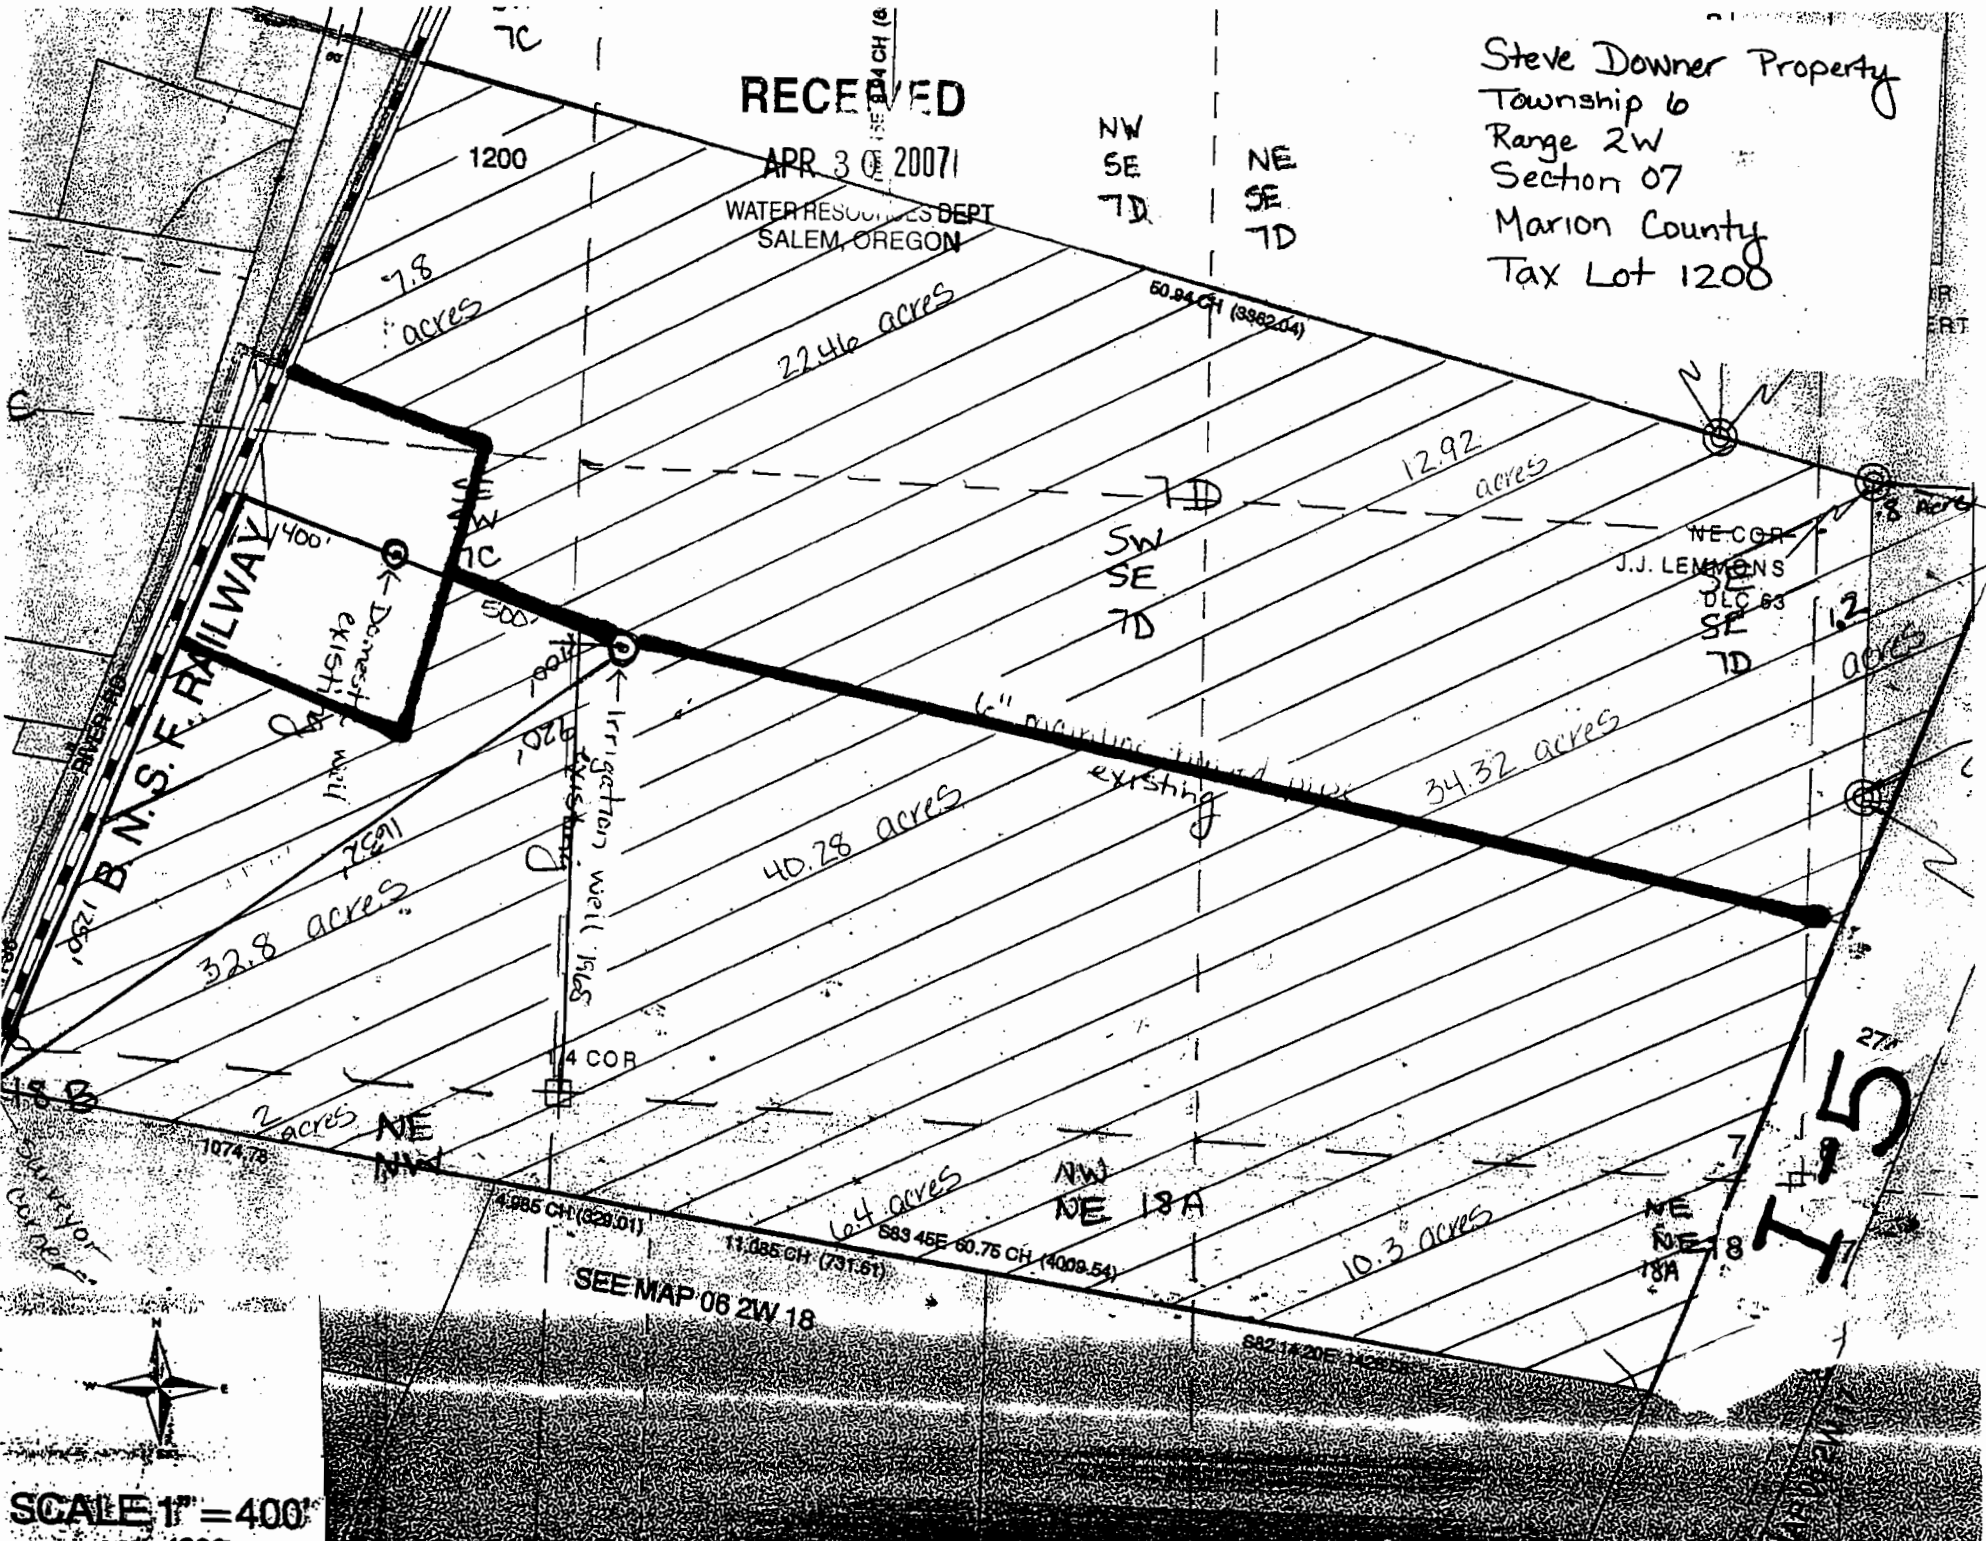

SCALE 1" = 400'  
ADD No G-16842