


North  
↑

NE1/4 SEC. 4 T.17S. R.11E.W.M.  
DESCHUTES COUNTY  
1"=300'

17 11 4A

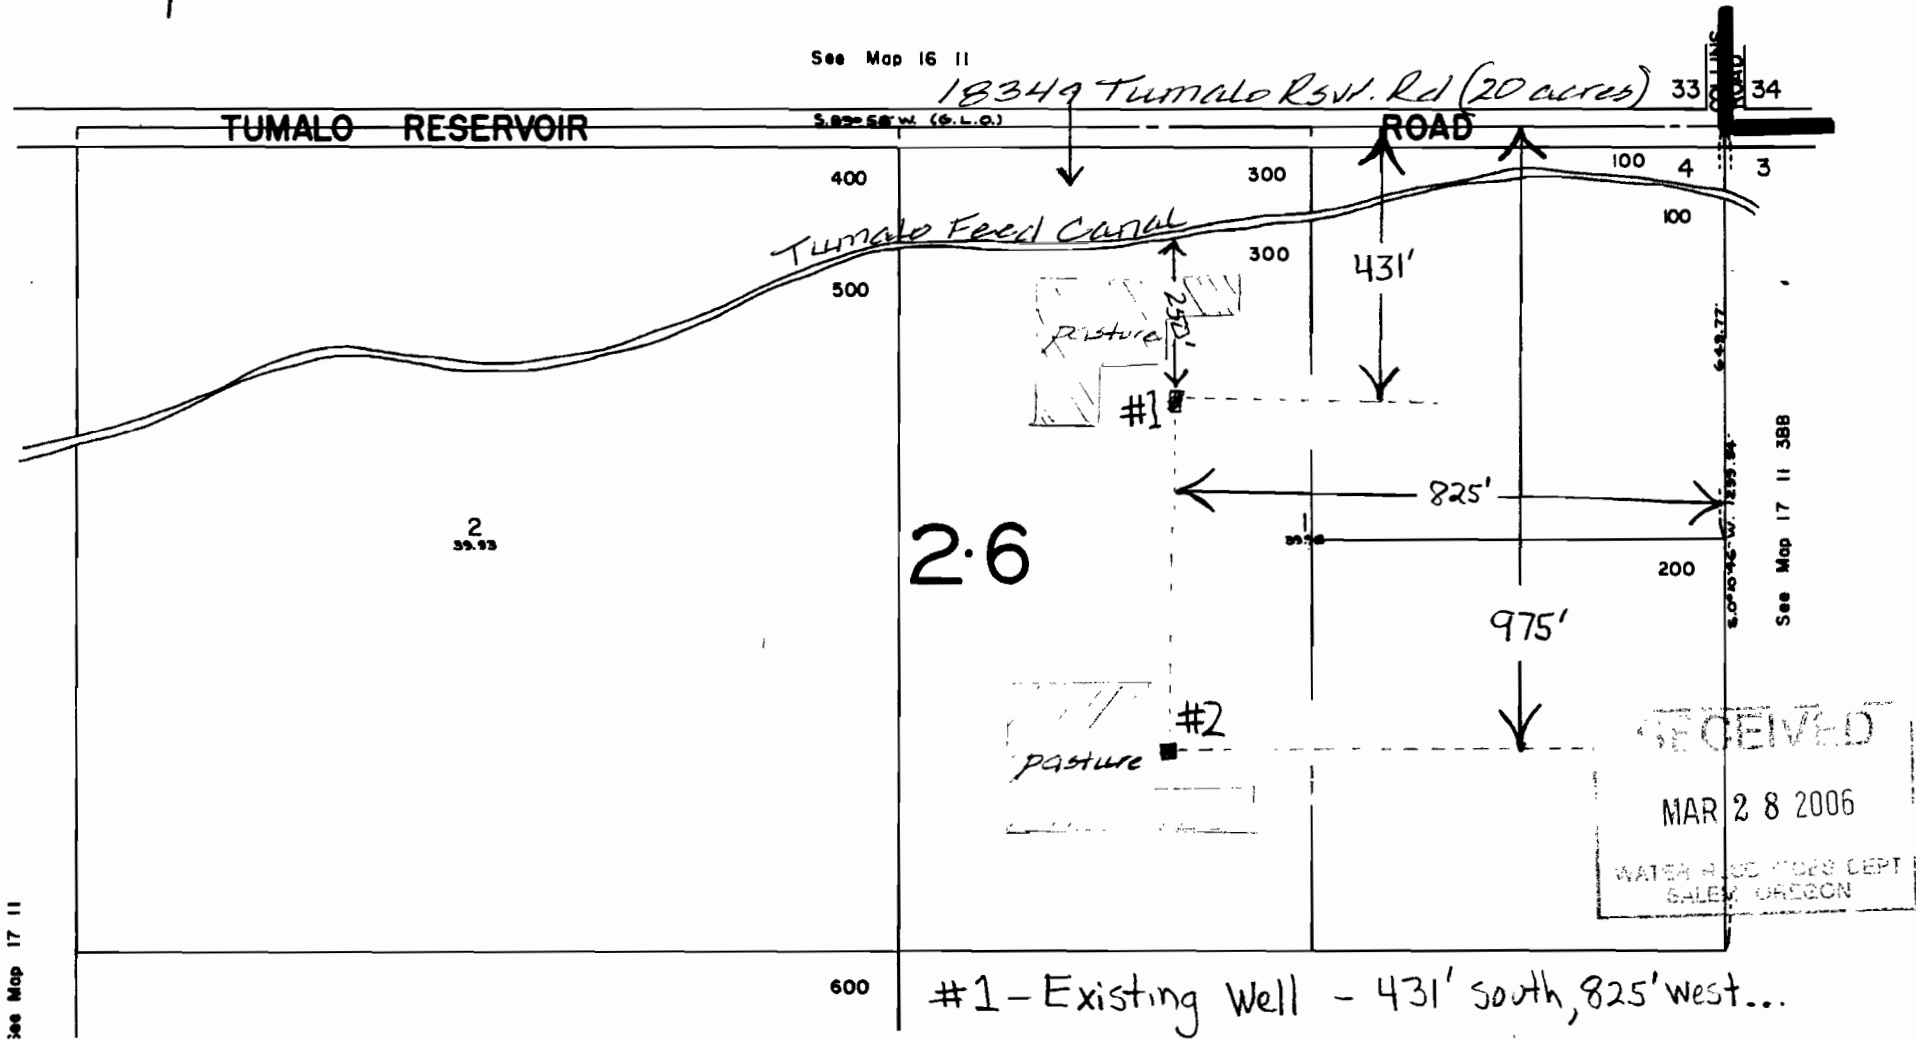

- #1 - Existing Well - 431' south, 825' west...
- #2 - Proposed Well - 975' south, 825' west...  
of section corner