



THIS MAP WAS PREPARED FOR ASSESSMENT PURPOSE ONLY

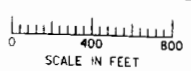

ADJUSTED APPROX SCALE CORRECTED SCALE 1" = 600 FT. SEE MAP SN 26 23

SECTION 26 T.5N. R.26E. W.M. MORROW COUNTY 1" = 600'

SN 26 26 & INDEX

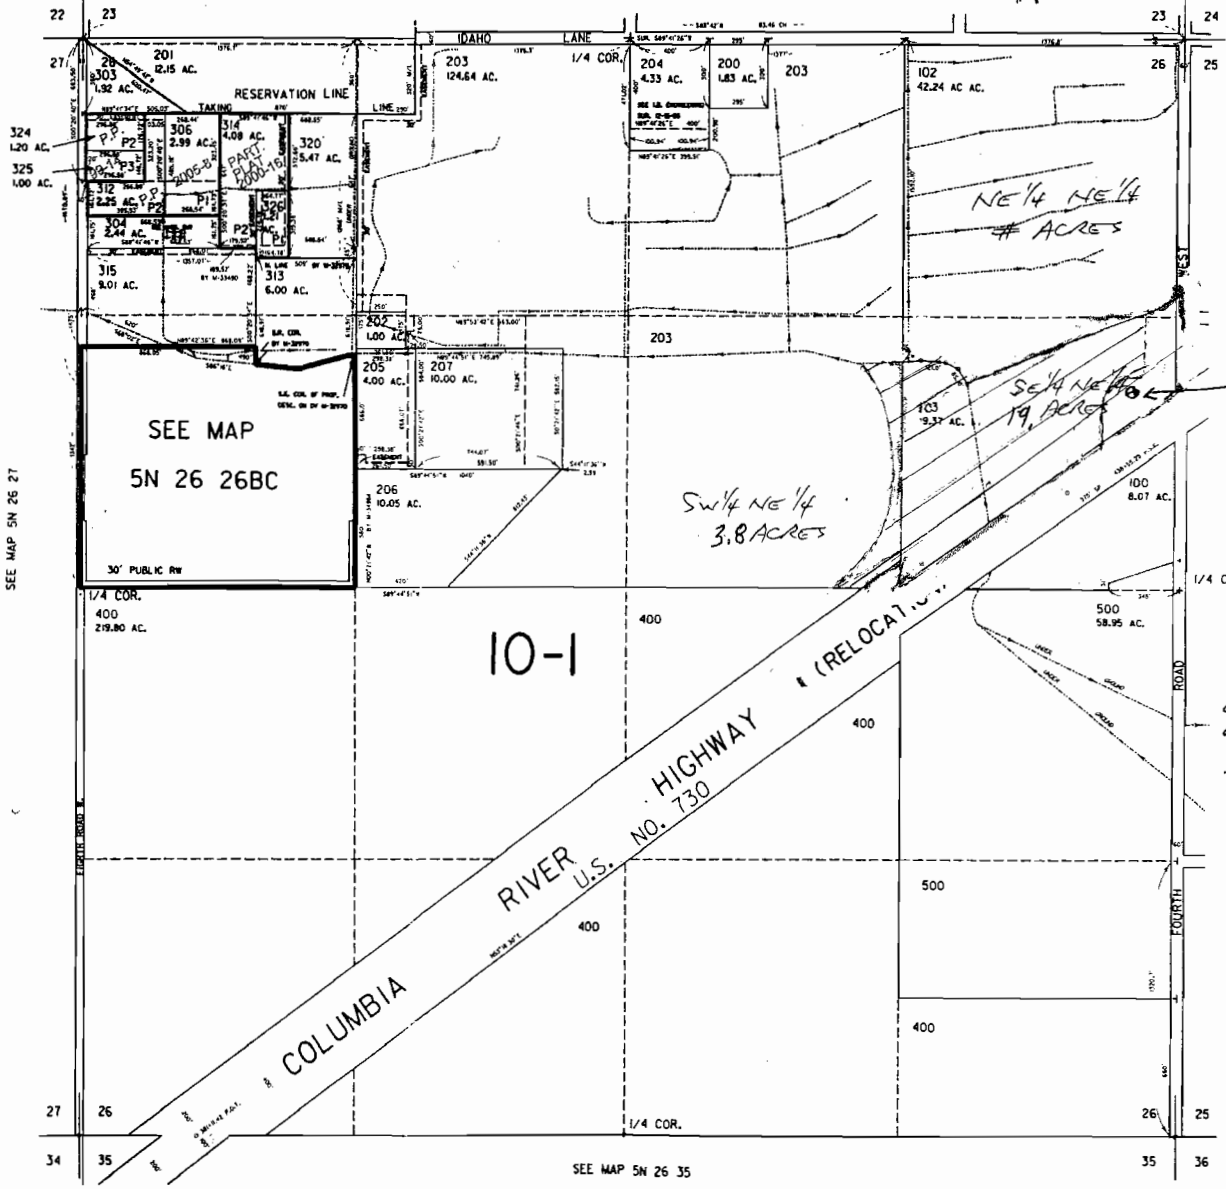

CANCELLED NO.
T.L. 301
T.L. 302
T.L. 305
T.L. 307 THRU 311
T.L. 316 THRU 319
T.L. 321 THRU 323

RECEIVED

SEE MAP SN 26 27

SEE MAP SN 26 25

Well is located approximately 220' S and 330' W of E 1/4 corner of NE 1/4, Section 26, Township 5 North, Range 26 East, W.M.

RECEIVED
MAR 16 2007
WATER RESOURCES DEPT
SALEM, OREGON

Revised
11/30/2005, DLW
SN 26 26

SEE MAP SN 26 35

appno G-16816