


# SECTION PLAT

Section 5 Township 26-S Range 31-E

County of Harney State of OR

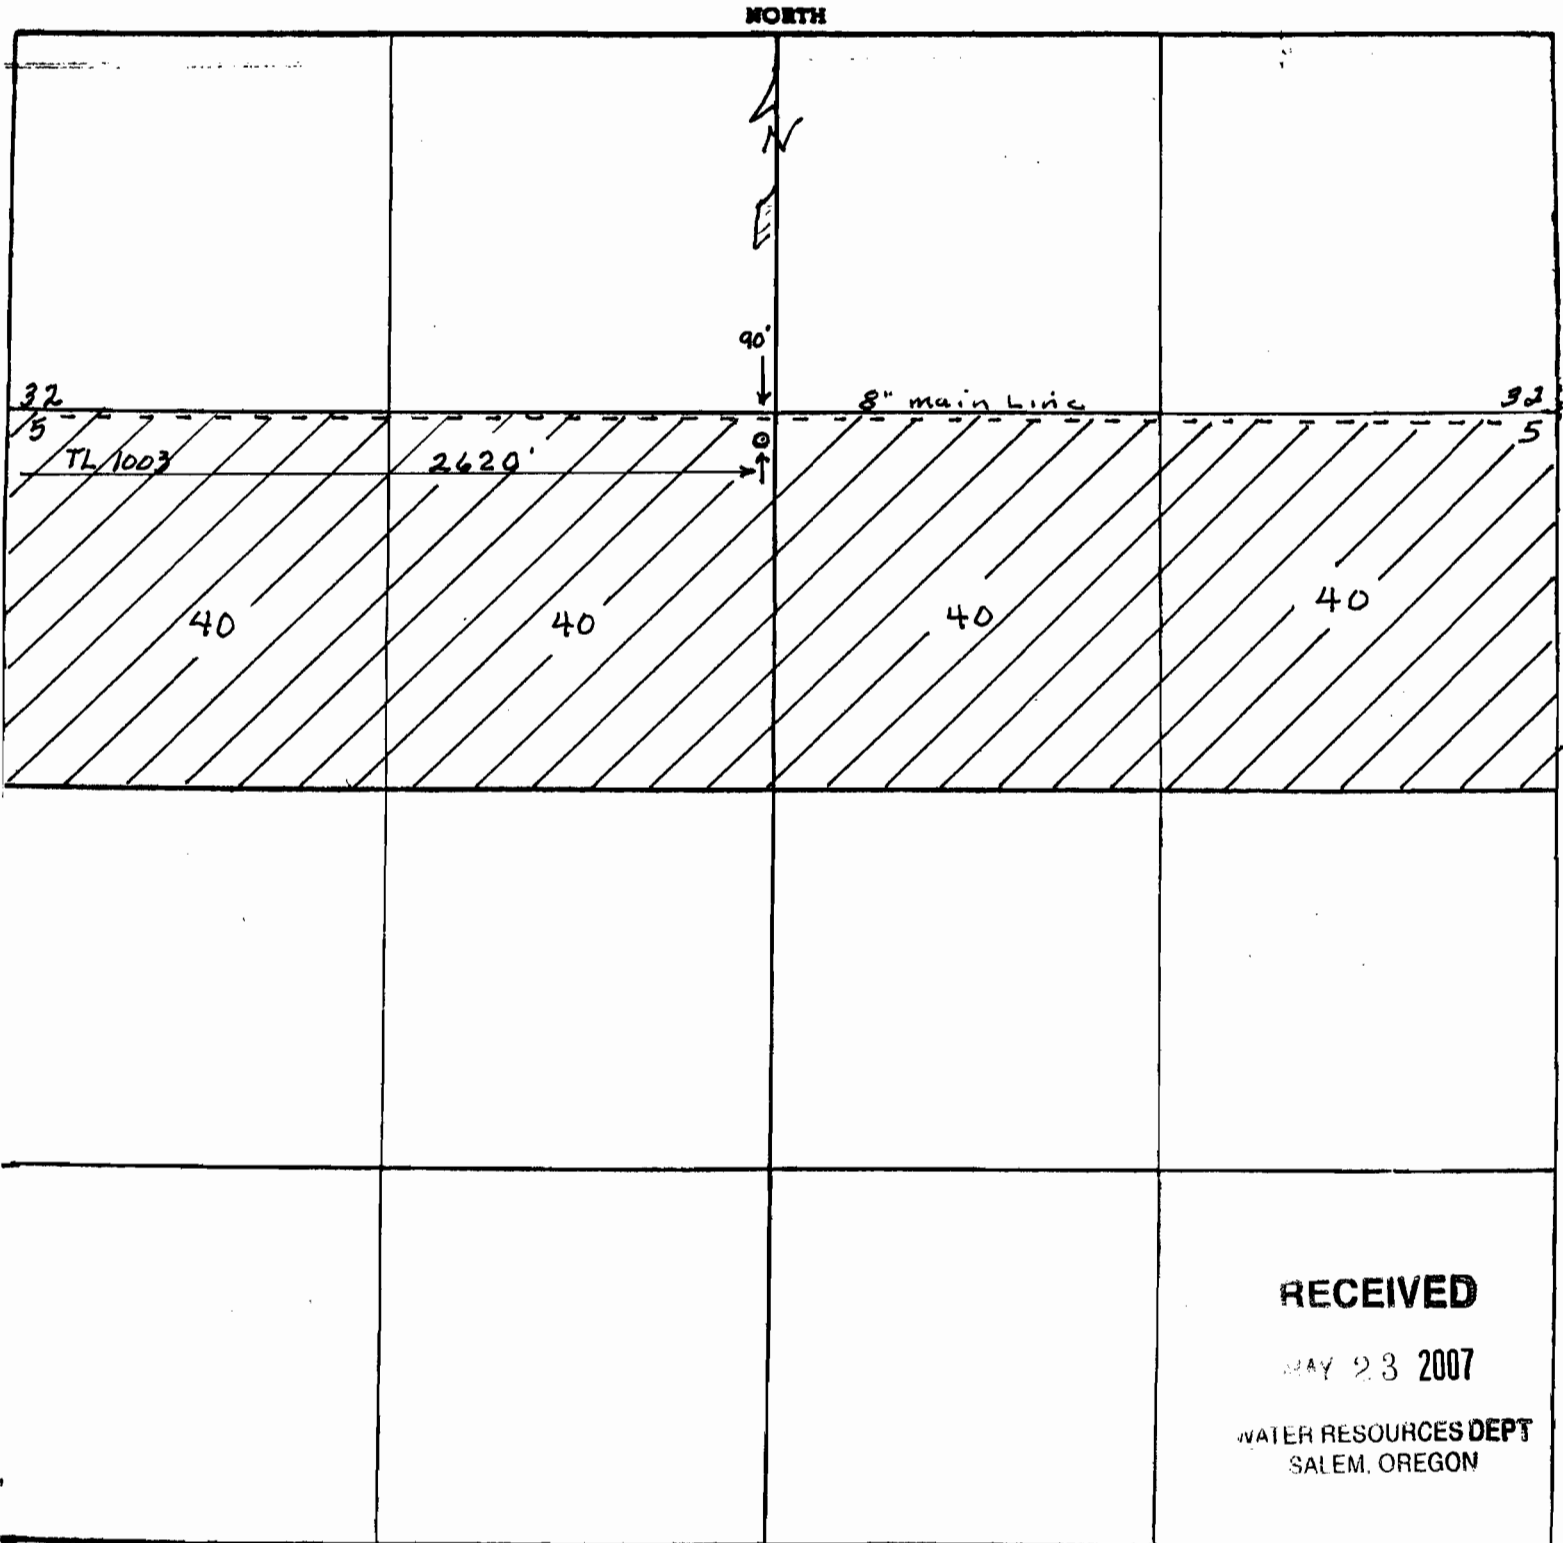

Scale = 1" = 660'

App No G-116867