

SECTION PLAT

Section 6 & 7


Township 26-5

Range 31-E

County of Harney

State of OR

NORTH

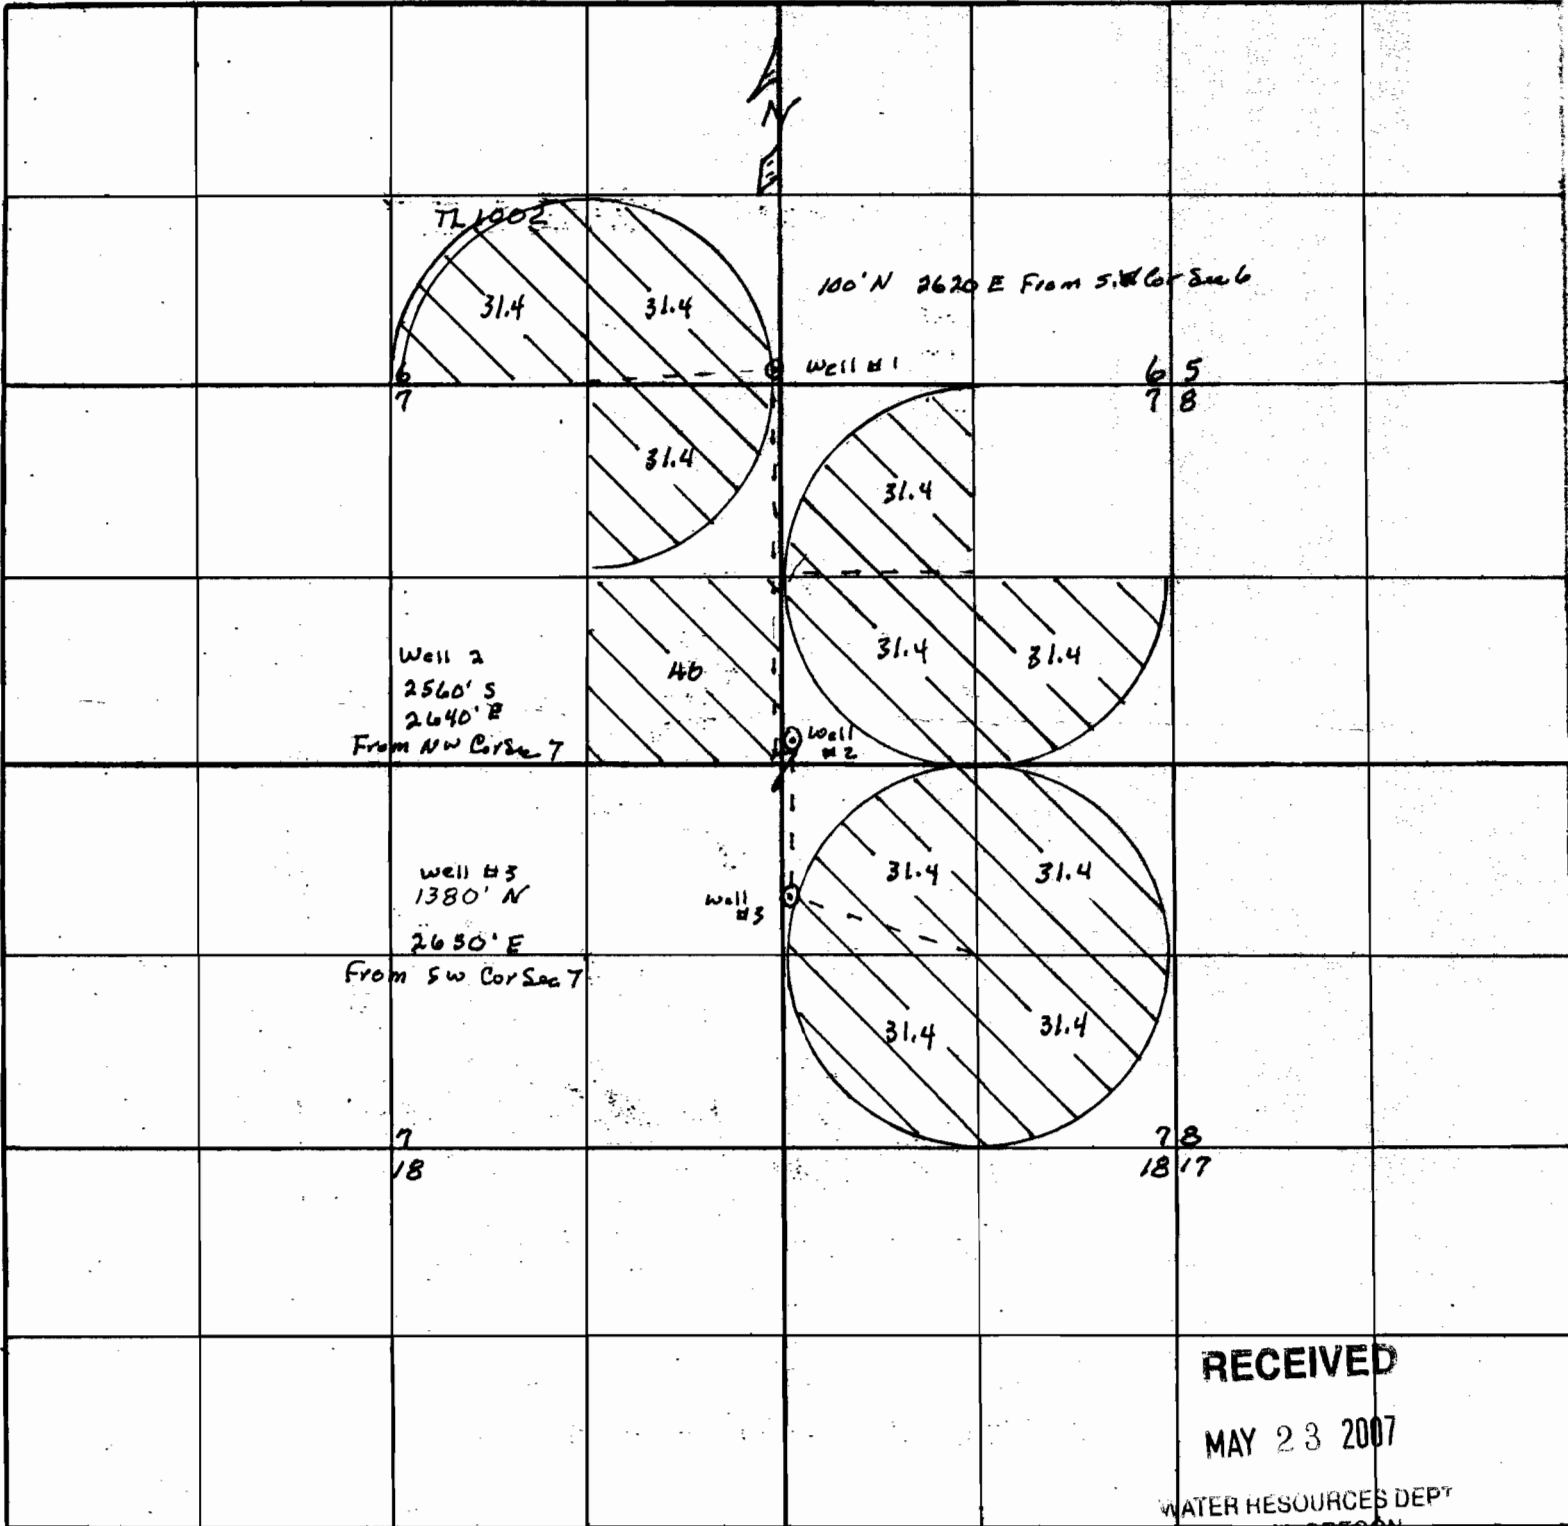

RECEIVED

MAY 23 2007

WATER RESOURCES DEPT
SALEM, OREGON

Remarks scale ~~1" = 1 mile~~ 4" = 1 mile

G-116868