


# Heffernan Water Rights Twp. 5S, Range 39 EWM

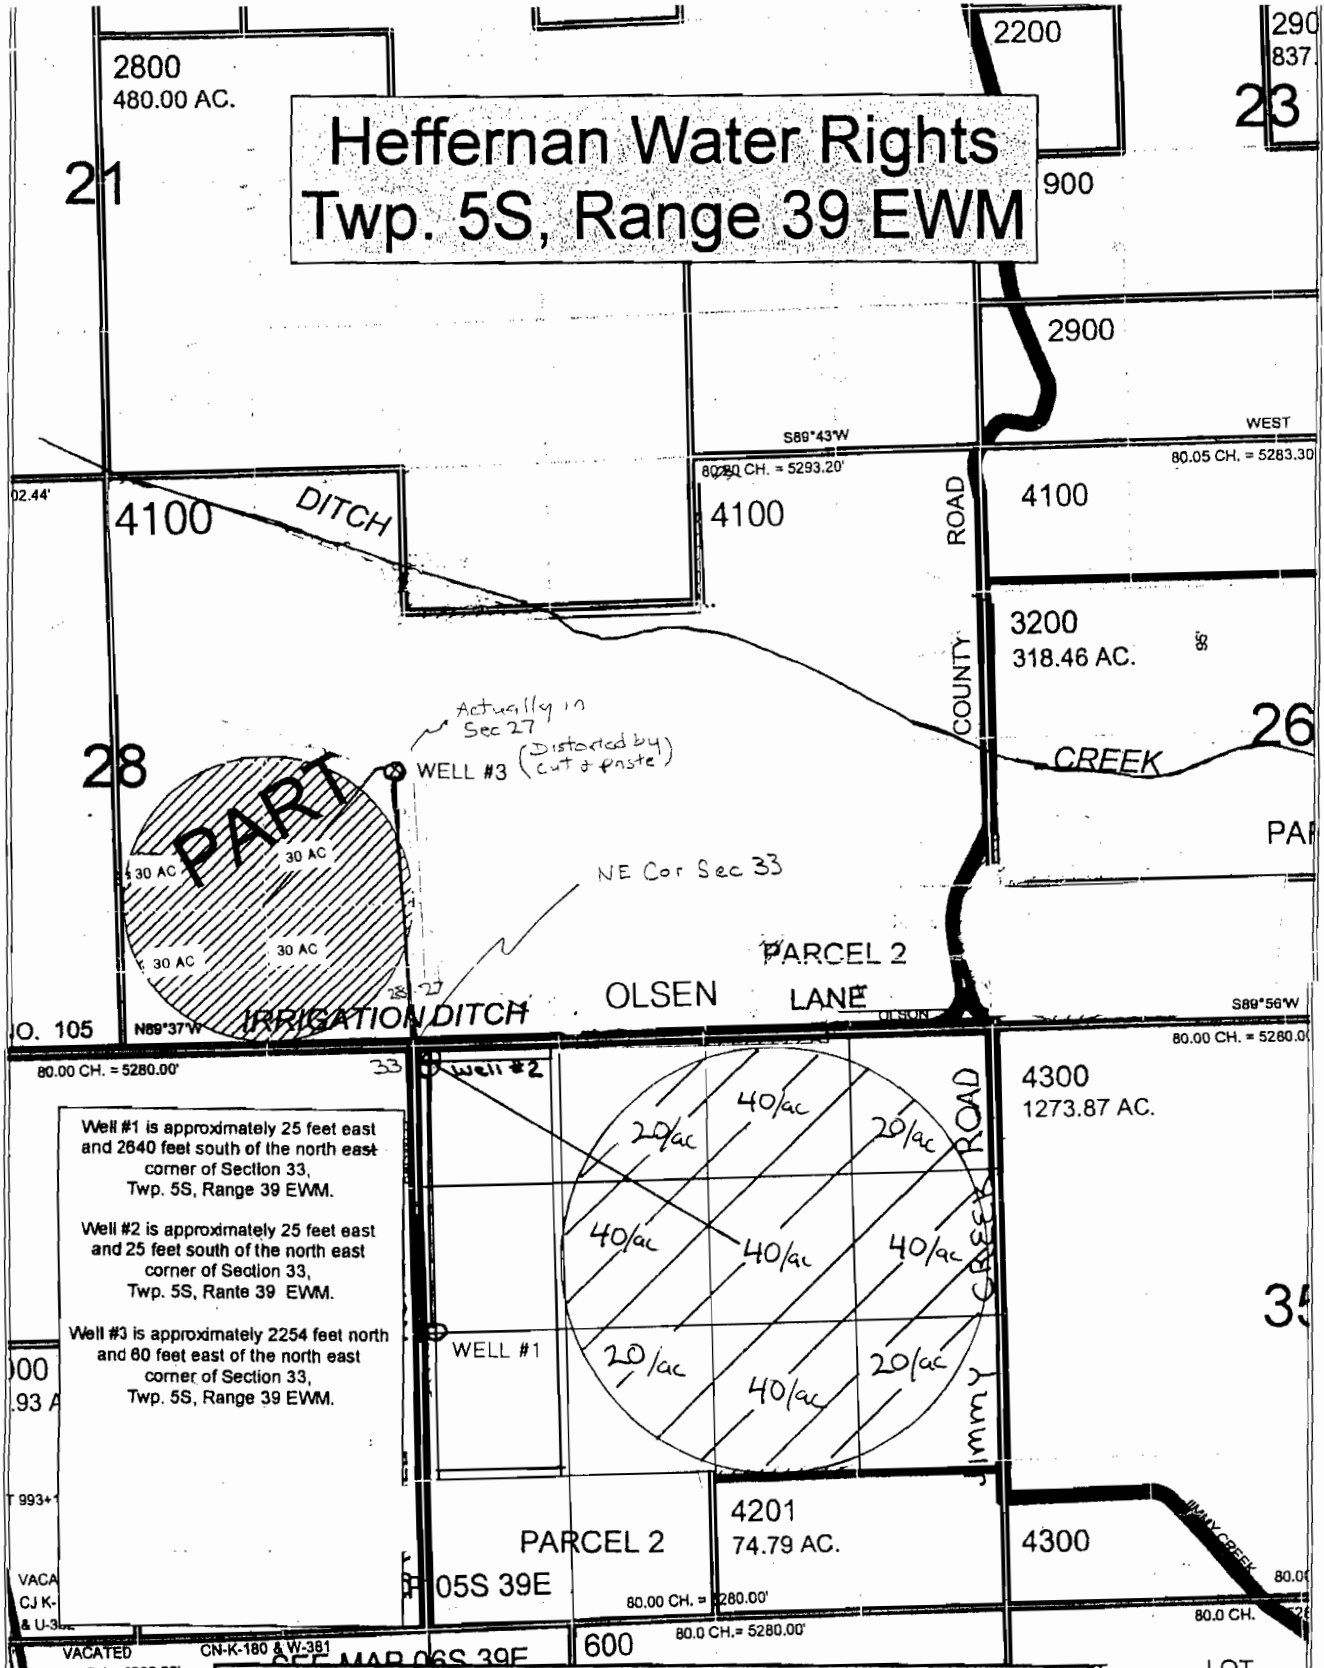

Well #1 is approximately 25 feet east and 2640 feet south of the north east corner of Section 33, Twp. 5S, Range 39 EWM.

Well #2 is approximately 25 feet east and 25 feet south of the north east corner of Section 33, Twp. 5S, Range 39 EWM.

Well #3 is approximately 2254 feet north and 60 feet east of the north east corner of Section 33, Twp. 5S, Range 39 EWM.

## Heffernan Water Rights Map

PIPELINE  
Area Irrigated Primary  
400 ACRES  
Tax Lots  
HEFFERNAN - 4100 & 4200

Scale affected by copy  
Scale 1" = 1,320'



RECEIVED  
MAY 27 2008  
WATER RESOURCES DEPT.  
SALEM, OREGON

AMENDED 5-21-08

Appl. G-17035