


# WATER RIGHT APPLICATION MAP

LOCATED MOSTLY IN: SECTION 35 & 36 T2S, R4W & SECTION 1 & 2 T3S, R4W  
 YAMHILL COUNTY, OREGON  
 SITE ADDRESS: 17155 NE WOODLAND LOOP ROAD  
 YAMHILL, OREGON 97148

ITEM 4



FOR  
 YAMHILL VISTA VINEYARDS, LLC

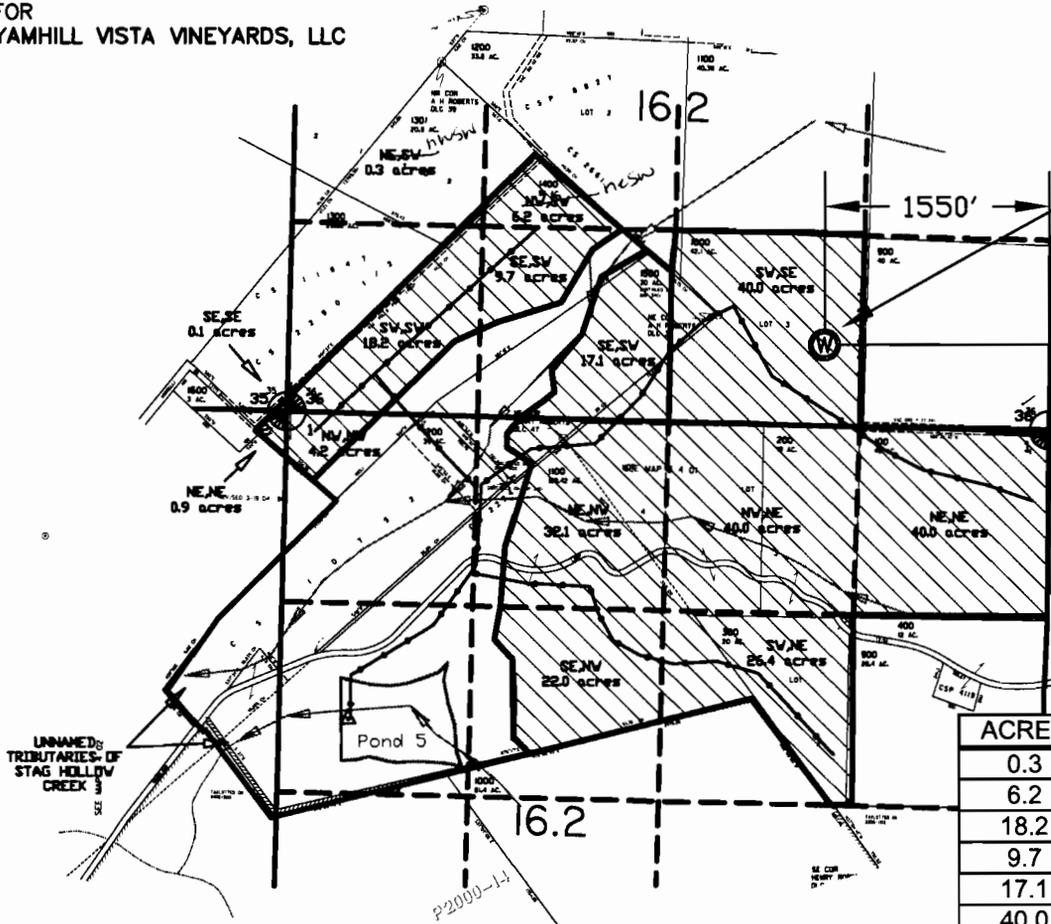

WELLS 1 IS 6 FEET NORTHERLY OF WELL 2

**RECEIVED**


MAR 23 2007

WATER RESOURCES DEPT  
 SALEM, OREGON

ACRES	1/4,1/4	S(T-R)
0.3	NE,SW	36(2S-4W)
6.2	NW,SW	36(2S-4W)
18.2	SW,SW	36(2S-4W)
9.7	SE,SW	36(2S-4W)
17.1	SE,SW	36(2S-4W)
40.0	SW,SE	36(2S-4W)
0.1	SE,SE	35(2S,4W)
0.9	NE,NE	2(3S-4W)
4.2	NW,NW	1(3S-4W)
32.1	NE,NW	1(3S-4W)
40.0	NW,NE	1(3S-4W)
40.0	NE,NE	1(3S-4W)
22.0	SE,NW	1(3S-4W)
26.4	SW,NE	1(3S-4W)
257.2	TOTAL	

THIS MAP WAS COMPILED BY SCALING TAX MAPS AND USGS QUAD MAPS A BOUNDARY SURVEY MAP.

- CREEK OR TRIBUTARY
- PROPOSED MAIN IRRIGATION LINES
- LOCATION BOTH WELLS L-72485 AND L-72486.
- AREA OF IRRIGATION
- POINT OF DIVERSION

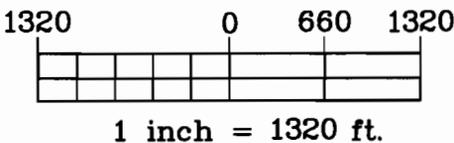

PREPARATION OF THIS MAP IS FOR THE PURPOSE OF IDENTIFYING THE LOCATION OF THE WATER RIGHT ONLY. THERE IS NO INTENT TO PROVIDE DIMENSIONS OR LOCATIONS OF PROPERTY OWNERSHIP LINES.



Project: 306-2-017  
 Drawing: 3062017H-GW&LIMUSE  
 By: URSTADT  
 Date: 12MAR2007

app no G-16822