


T 24 S, R 33 E, WM
Sec 12

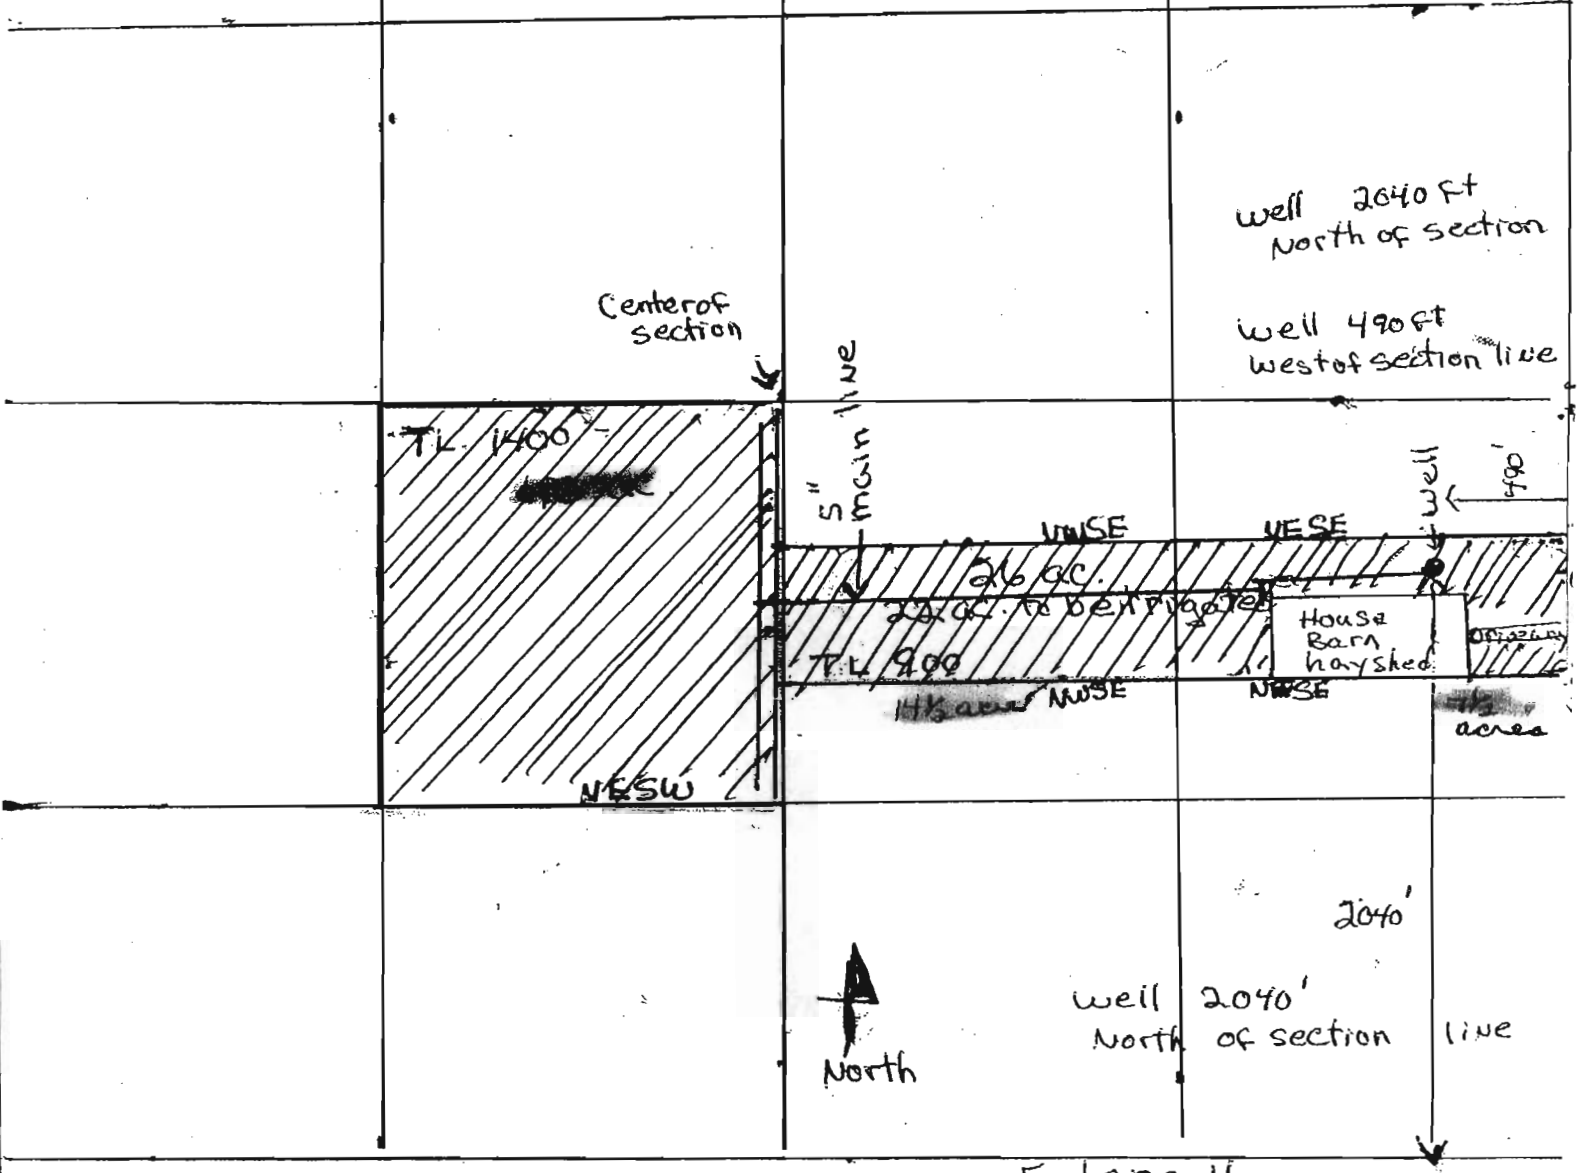

Ronald Krettinger
67396 Crane-Buchanan Rd
Burns, Or. 97720
Harney County

E Lane 16

Scale 1" = 660 ft

WATER RIGHT APPLICATION MAP

RECEIVED

DEC 24 2007

WATER RESOURCES DEPT
SALEM, OREGON

