

14 10 33D


See Map 14 10 33

# PARTITION PLAT NO. 1995-36

SCALE: 1" = 200'  
TAXLOT: 151004A

NE<sup>1</sup>/<sub>4</sub> NE<sup>1</sup>/<sub>4</sub> SEC 4  
Township 15S  
RANGE 10E W.M.

33 34  
4 3

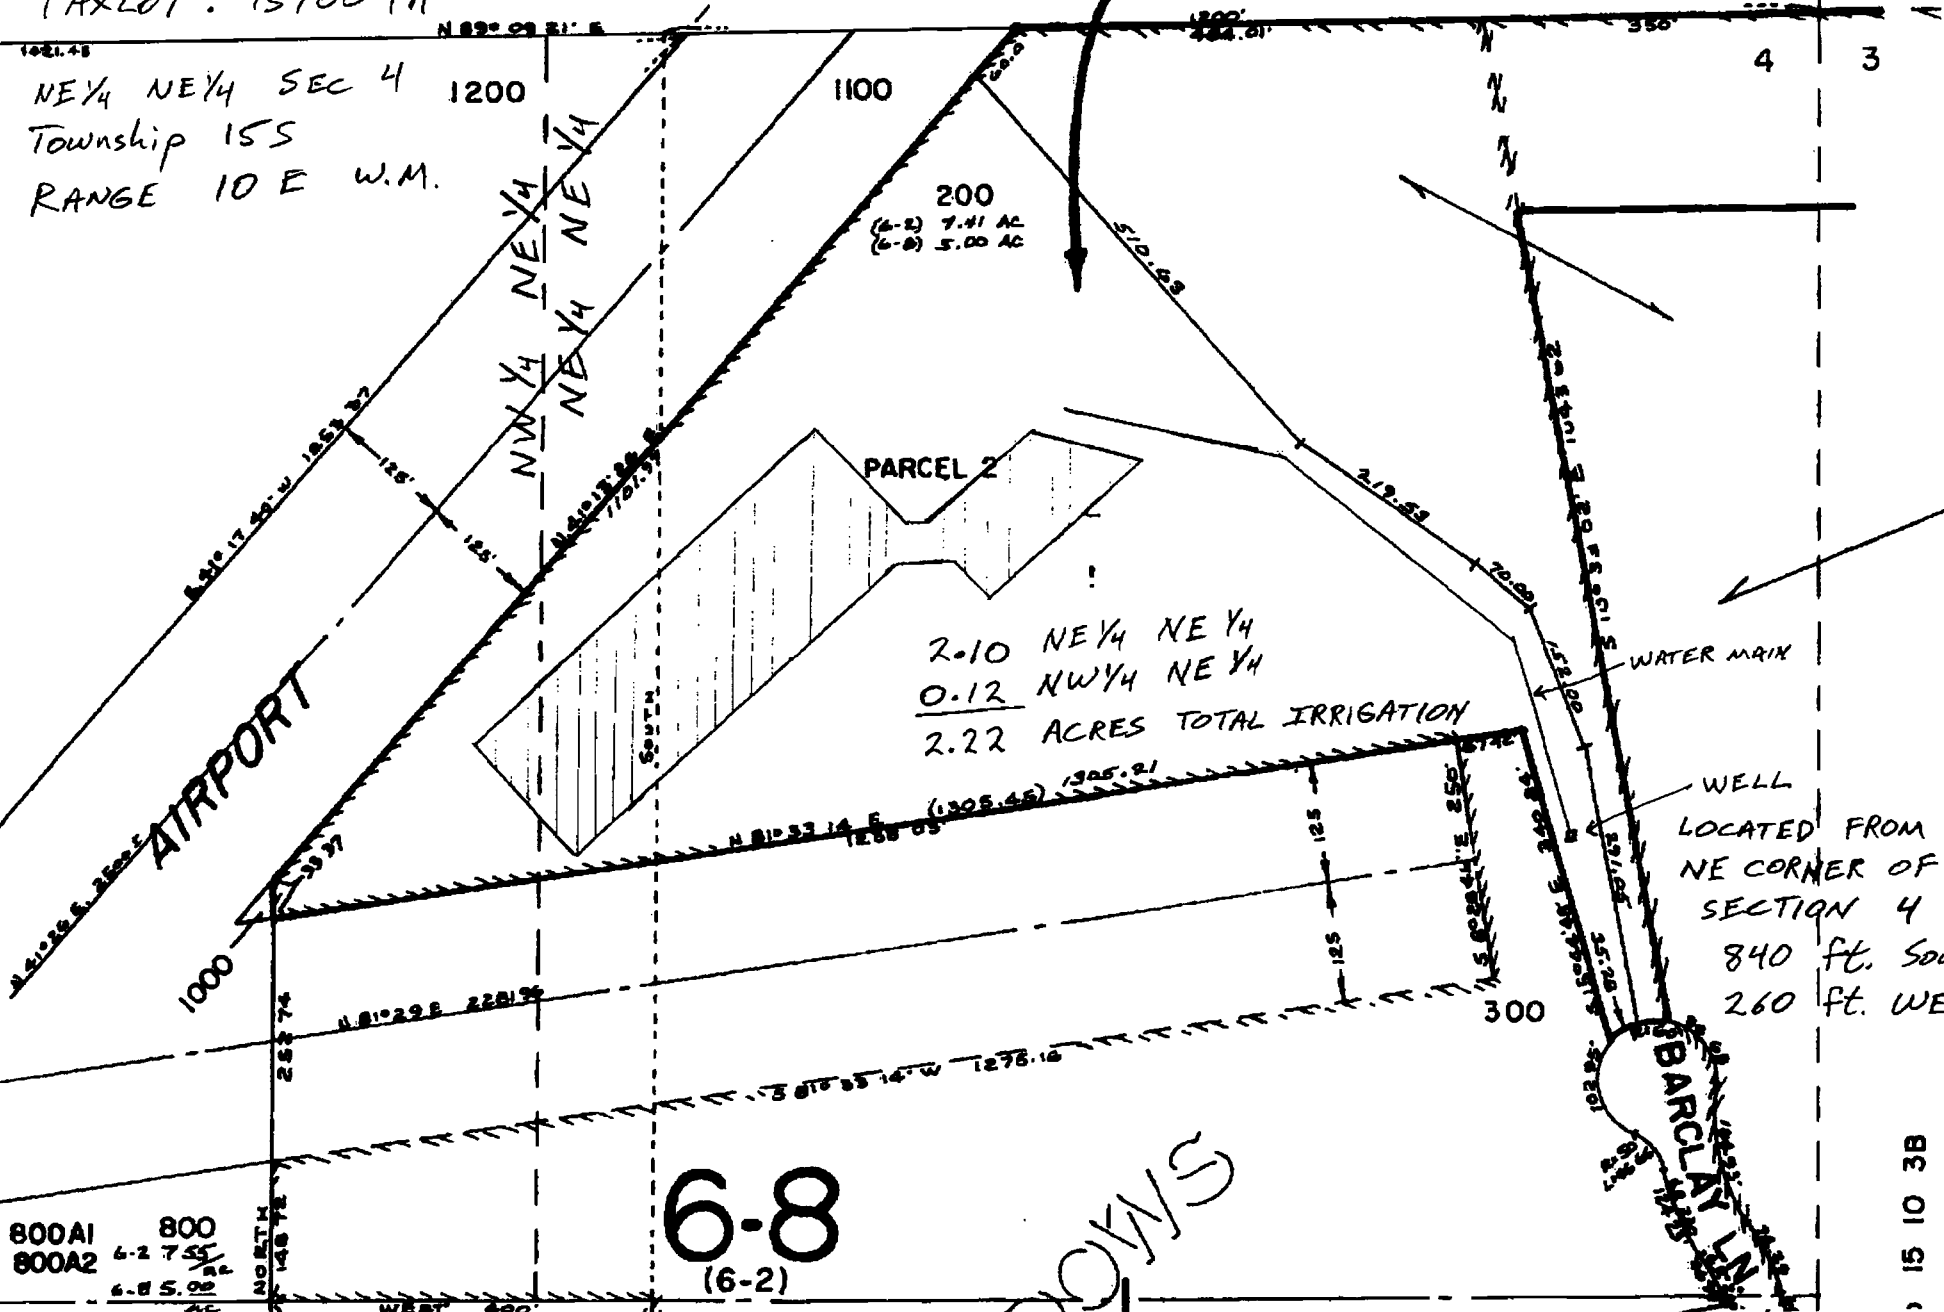

200  
(6-2) 7.41 AC  
(6-8) 5.00 AC

PARCEL 2

2.10 NE<sup>1</sup>/<sub>4</sub> NE<sup>1</sup>/<sub>4</sub>  
0.12 NW<sup>1</sup>/<sub>4</sub> NE<sup>1</sup>/<sub>4</sub>  
2.22 ACRES TOTAL IRRIGATION

WATER MAIN

WELL  
LOCATED FROM  
NE CORNER OF  
SECTION 4  
840 ft. South  
260 ft. WEST

BARCLAY

6-8  
(6-2)

JOHNS

15 10 3B

800A1 800  
800A2 6-2 7.51  
6-8 5.00  
AC

apno 6-16636