

PR 9-15-07

CALA FARMS - MAP 6

SCALE: 1" = 1,320 FEET SECTION 7

WELL LOCATED FROM NE CORNER
1718 FE SOUTH 1560 FE WEST



= Existing Water Rights



Acreage:

#203: 13s-3w-7
 NENW= 8.46 acres
 NWNE= 39.54 acres
 NENE= 1.68 acres
 SWNE= 12.87 acres
 SENW= .13 acres

#202: 13s-3w-7
 SWNE= 18.65 acres
 SENE= 34.35 acres
 NENE= 11 acres
 NWSE= 4.43 acres
 NWNE= .46 acres

#200: 13s-3w-7
 SWNE= 9.35 acres
 NWSE= 36 acres
 SWSE= 40 acres

#400: 13s-3w-7
 NWSW= 8.33 acres
 NESW= 20 acres

#500: 13s-3w-18
 NWSW= 20 acres
 NESW= 7.22 acres

#600: 13s-3w-18
 SWSW= 8.35 acres
 SESW= 22 acres

#400: 13s-3w-17
 SESE= 20 acres
 SWSW= 19.87 acres
 NENE= 40 acres
 NWNW= 40 acres
 SESE= 40 acres
 SWNW= 40 acres


#1000: 13s-3w-18
 NWSE= 18 acres
 SWSE= 18 acres
 NWNE= 20.47 acres
 NESE= 6.63 acres

#502: 13s-3w-17
 NESE= *30.25 acres
 NWSW= *23.9 acres
 NESW= *37.5 acres
 SWSW= *5 acres
 SESW= *2.03 acres
 SESE= *NONE

#500: 13s-3w-18
 SESE= 10.51 acres

#501: 13s-3w-17
 NESE= 3.72 acres
 SESE= 26 acres
 SWSW= *9.5 acres
 SESW= *22.63 acres

* = Additional Acreage

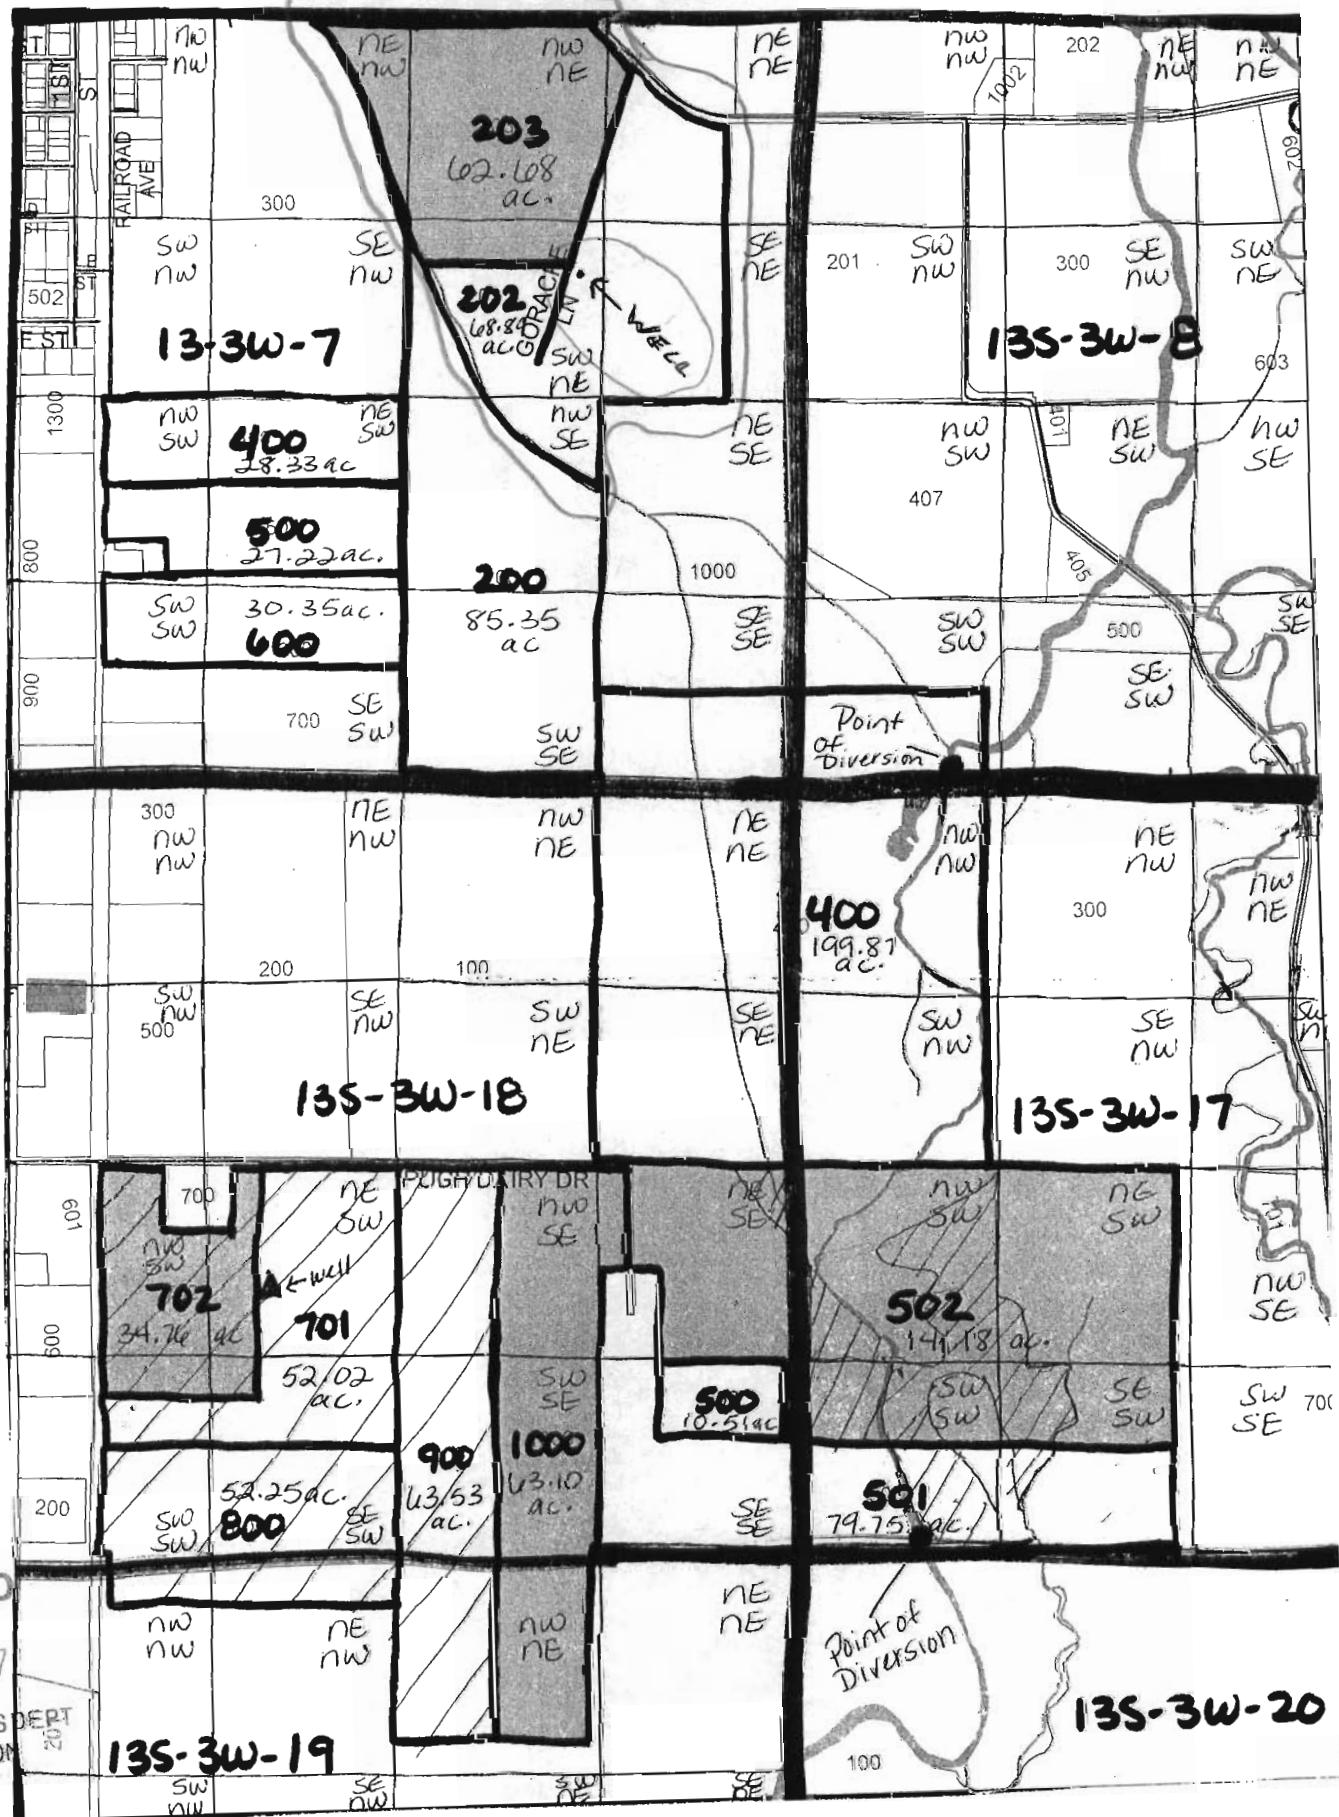

RECEIVED

SEP 18 2007

WATER RESOURCES DEPT
SALEM, OREGON

App No G-112930