


- NOTES:**
1. WELL NO. 1 (WATER RIGHT PERMIT NO. G-3125, CERTIFICATE NO. 41989) HAS FAILED AND HAS BEEN ABANDONED. THE WATER RIGHT HAS BEEN TRANSFERRED TO WELL NO. 5 (TRANSFER 7867).
  2. WELL NO. 3 (WATER RIGHT PERMIT NO. G-3531, CERTIFICATE NO. 41999) IS NO LONGER IN SERVICE AND IS TO BE ABANDONED.
  3. WELL NO. 4 (WATER RIGHT PERMIT NO. G-3531, CERTIFICATE NO. 41999) IS CURRENTLY IN SERVICE.
  4. WELL NO. 5 WAS CONSTRUCTED IN 1986 AND THE WATER RIGHT WAS TRANSFERRED FROM WELL NO. 1 (WATER RIGHTS TRANSFER 7867).
  5. WELL NO. 6 (WATER RIGHT PERMIT NO. G-15927) IS CURRENTLY IN SERVICE.
  6. WELL NO. 7 (WATER RIGHT PERMIT NO. G-15927) IS CURRENTLY IN SERVICE.
  7. THE CITY IS CURRENTLY APPLYING FOR A WATER RIGHT PERMIT FOR WELL NO. 8.
  8. ALL WATER USE IS WITHIN THE HARRISBURG CITY LIMITS.

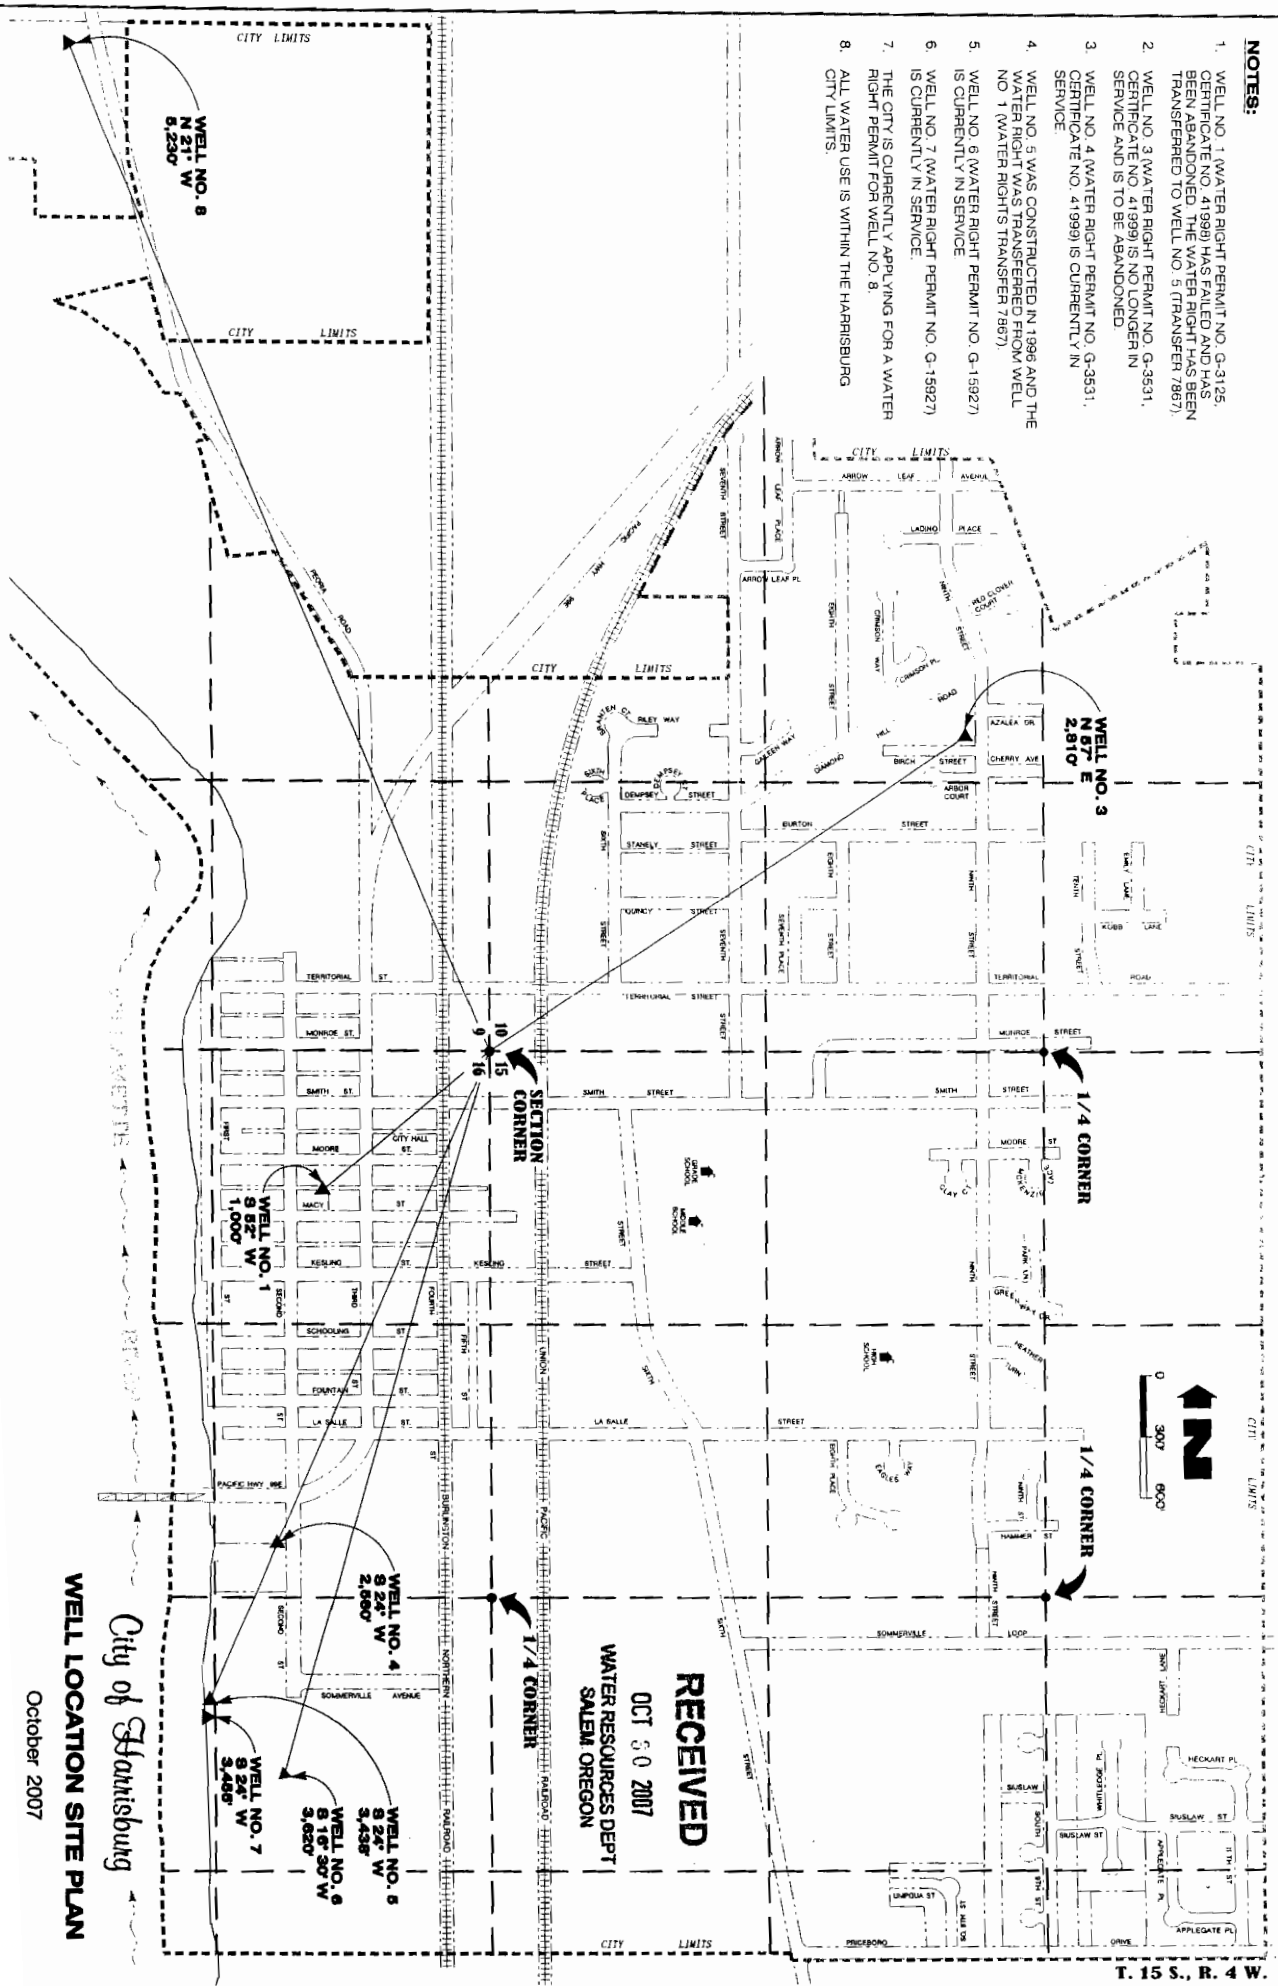

City of Harrisburg  
WELL LOCATION SITE PLAN

October 2007

**RECEIVED**  
OCT 5 0 2007  
WATER RESOURCES DEPT  
SALEM OREGON

T. 15 S., R. 4 W.