


Heffernan Water Rights Twp. 5S, Range 39 EWM

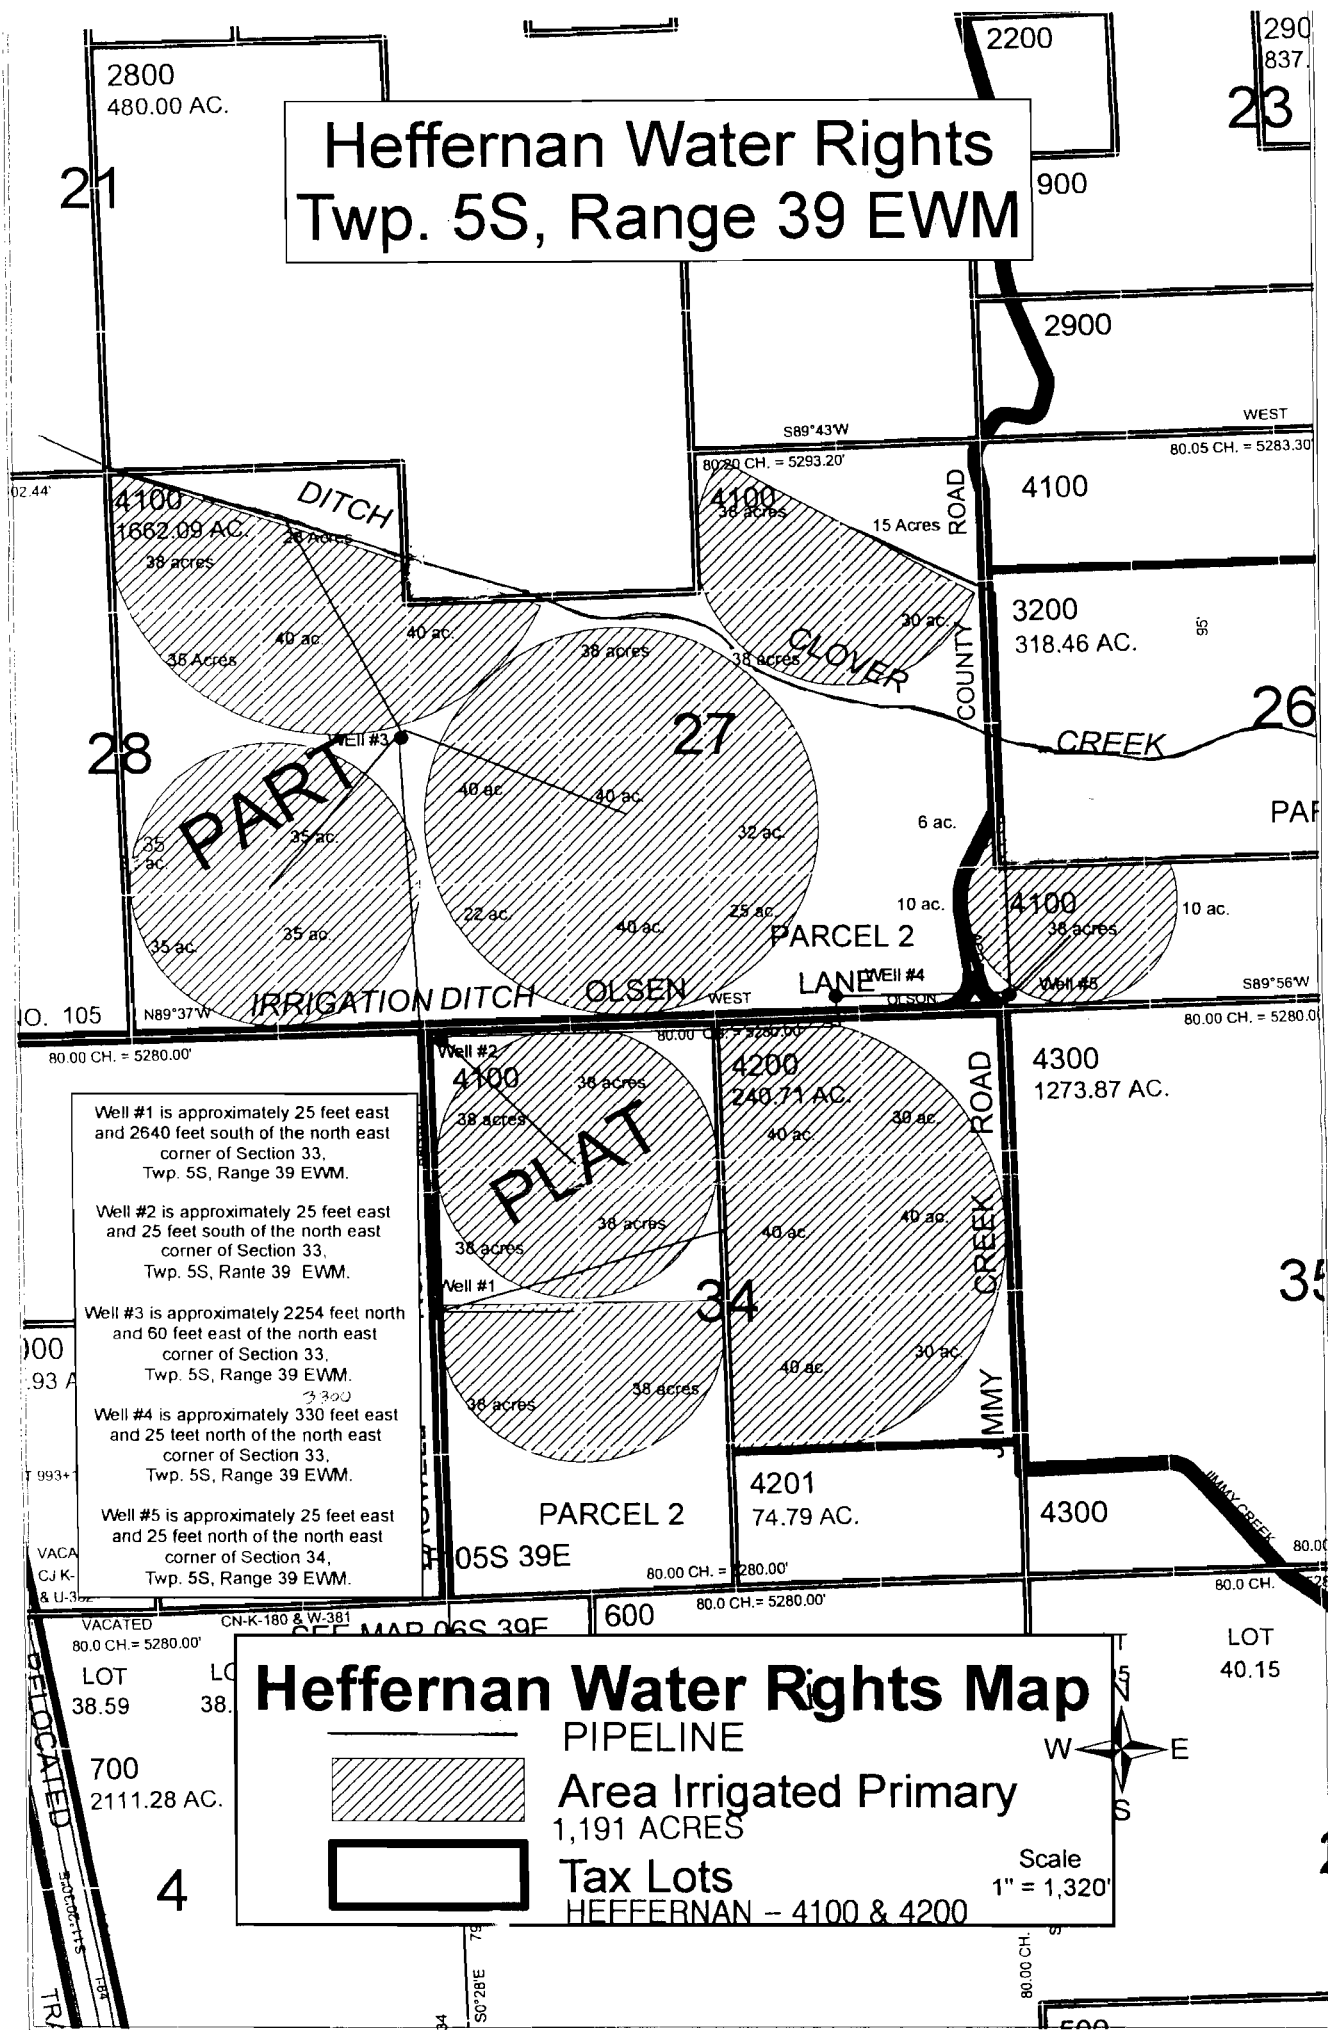

Well #1 is approximately 25 feet east and 2640 feet south of the north east corner of Section 33, Twp. 5S, Range 39 EWM.

Well #2 is approximately 25 feet east and 25 feet south of the north east corner of Section 33, Twp. 5S, Range 39 EWM.

Well #3 is approximately 2254 feet north and 60 feet east of the north east corner of Section 33, Twp. 5S, Range 39 EWM.

Well #4 is approximately 330 feet east and 25 feet north of the north east corner of Section 33, Twp. 5S, Range 39 EWM.

Well #5 is approximately 25 feet east and 25 feet north of the north east corner of Section 34, Twp. 5S, Range 39 EWM.

Heffernan Water Rights Map

PIPELINE

 Area Irrigated Primary
1,191 ACRES

 Tax Lots
HEFFERNAN - 4100 & 4200

Scale
1" = 1,320'

RECEIVED
APR 10 2009
WATER RESOURCES DEPT
SALEM, OREGON

Appl. G-16902