

RECEIVED
OCT 31 2007
WATER RESOURCES DEPT
SALEM, OREGON


**Fred & Charlene Teutsch
Application Map**

1 inch equals 500 feet
1 inch equals 0.09 miles

- T&R
- Sections
- Quarter Quarter
- Tax Lots
- Area to be Irrigated
- Well Locations


Note: This document is made by Harney County, Oregon Bureau of Land Management, as the county's authority, in cooperation with the Oregon Department of Agriculture. Original data was provided from parcel owners. The information is not intended to be used for legal purposes. This document was prepared through state funds and may be updated as circumstances change. Prepared by Bruce M. Dwyer

HARNEY COUNTY GIS
541-573-8105
www.ohb.state.or.us
In cooperation with
The Bureau of Land Management



RECEIVED
NOV 14 2007
WATER RESOURCES DEPT
SALEM OREGON

App No G-16961

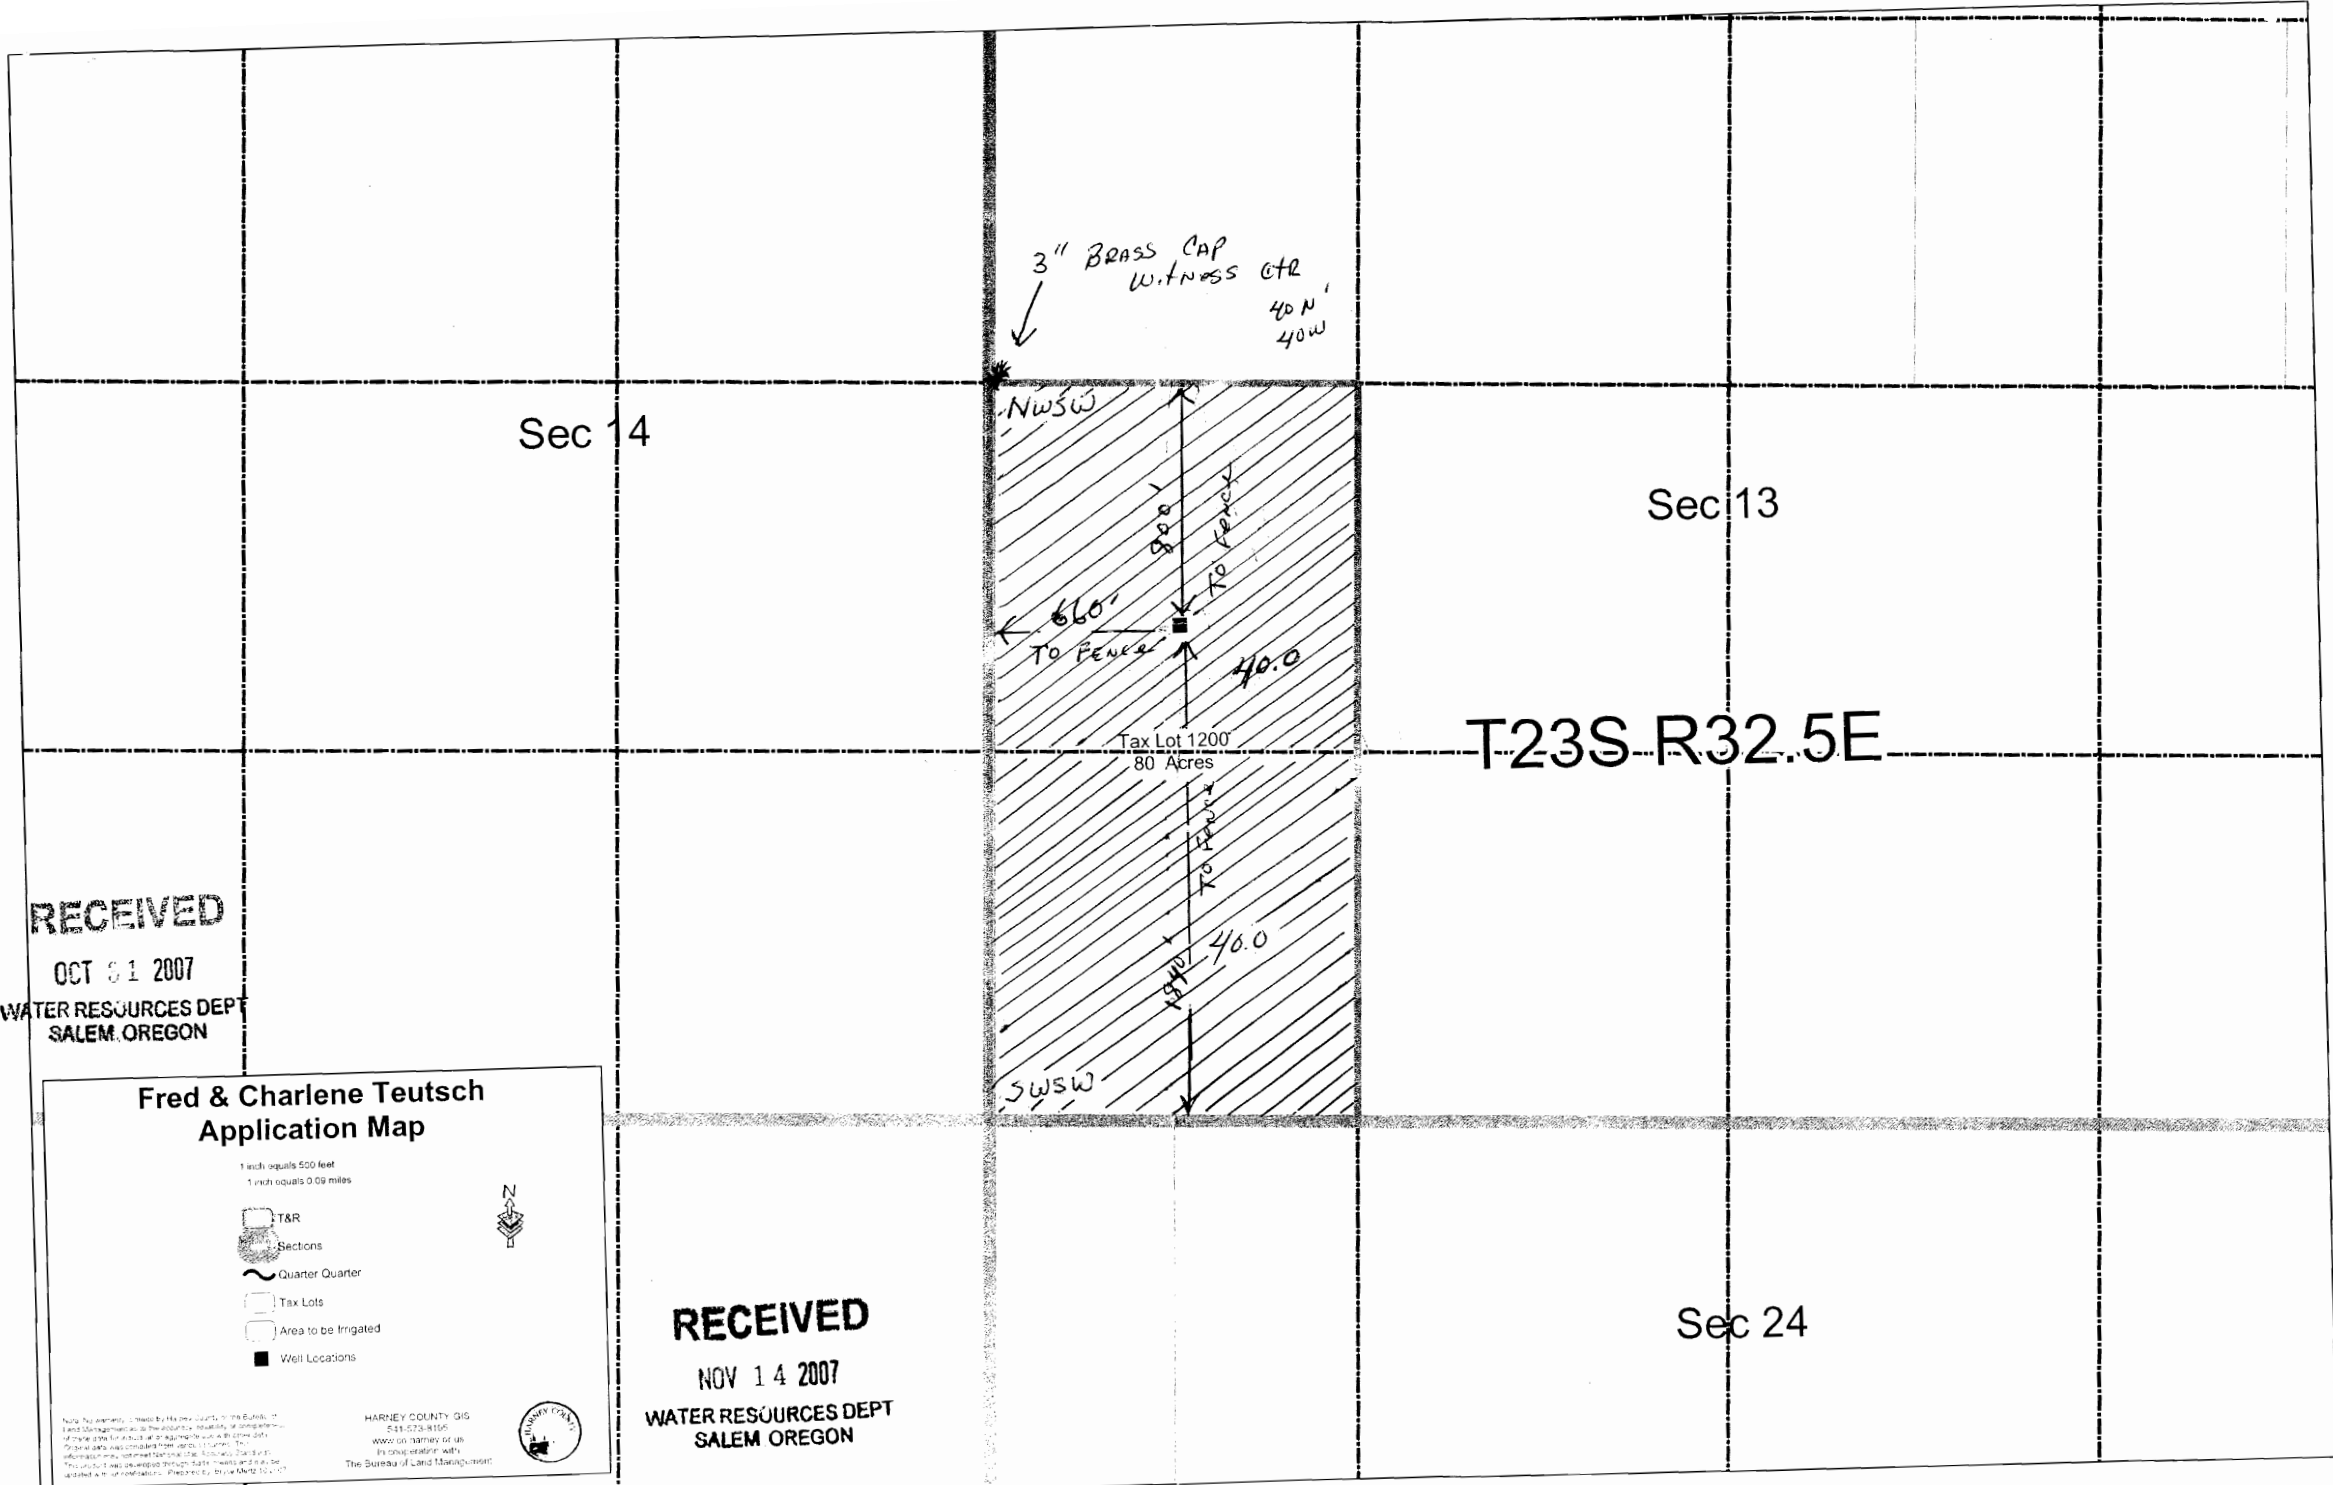

T23S R32.5E