N

This map was prepared for assessment purposes

NW1/4 SE1/4 SEC 29 T5N R29E WM
UMATILLA COUNTY
Scale: 1" = 400'

5N 29 29DB
AERIAL PHOTO NO. 1P-100

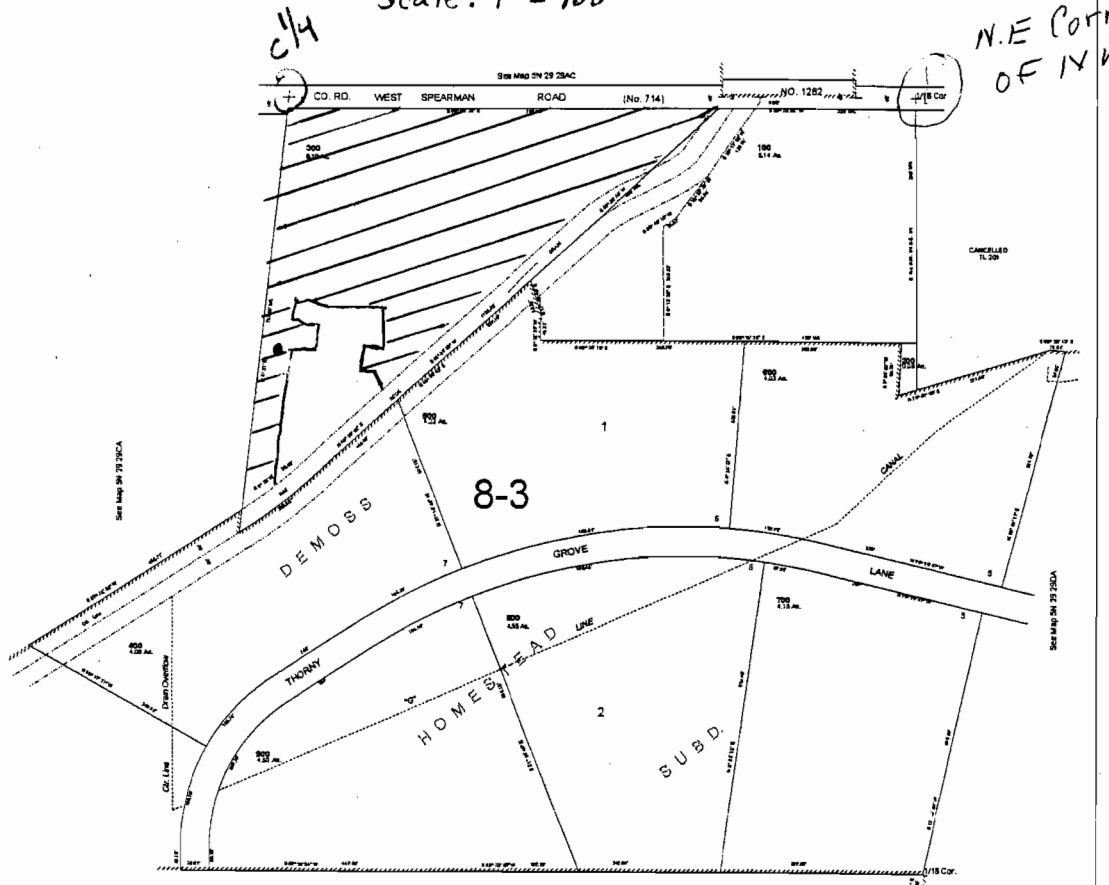

Map
N.W 1/4 SE 1/4 SEC. 29
T5N R29E WM

Key
5 AC. IRR. (NWSE TL 300)
BIDGS + PARKING + Drain Ditch
1.1 ac not irr.
App No G-17050

WELL Location
522 So. + 1320' W from The
N.E. Corner T.5N. R. 29E. W.M.
Sec. 29 NWSE. TAX LOT 300
Umatilla Co. Basin 7

(•) Well Location

RECEIVED
MAY 12 2008
WATER RESOURCES DEPT
SALEM, OREGON