


SECTION PLAT

Section 33 Township 26S Range 33E  
County of HARNEY State of OREGON



NORTH

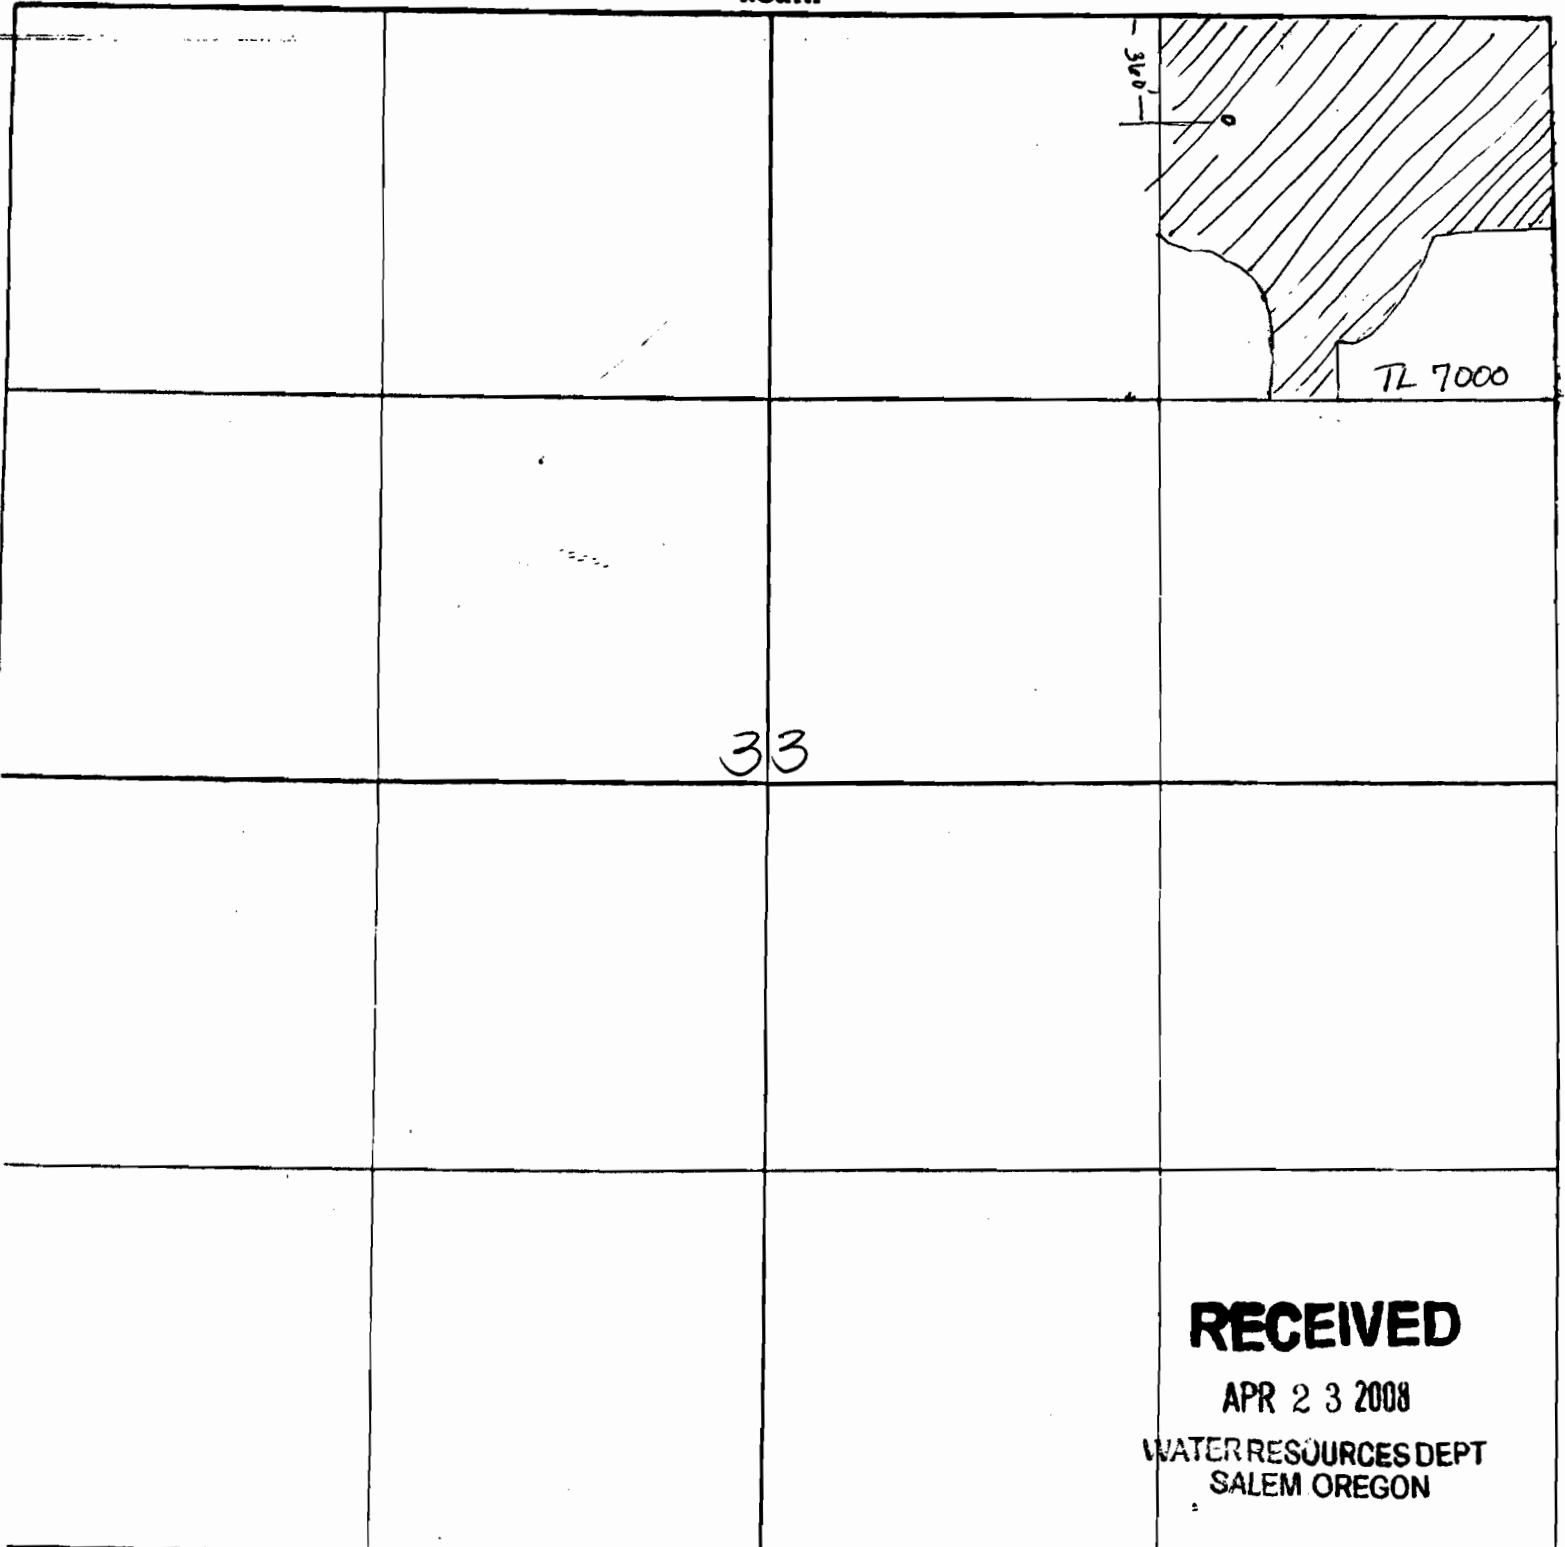

**RECEIVED**

APR 23 2008

WATER RESOURCES DEPT  
SALEM OREGON

Well located 360' S + ~~758'~~ 1,162' W from ~~NE~~ NE corner of the NE 1/4 of NE 1/4 of Section 33.

App No G-17045