


W.R. 666
ALBERT & ALPHA M. FORTIER
 SECS. 30 & 31, T. 10 S., R. 3 W., W.M., BENTON CO., ORE.
 Scale: 1" = 10 Chains
 Nov. 3, 1958

REGISTERED
OREGON
 LAND SURVEYOR
Orris A. Carnegie
 MAY 9, 1947
ORRIS A. CARNEGIE
 213

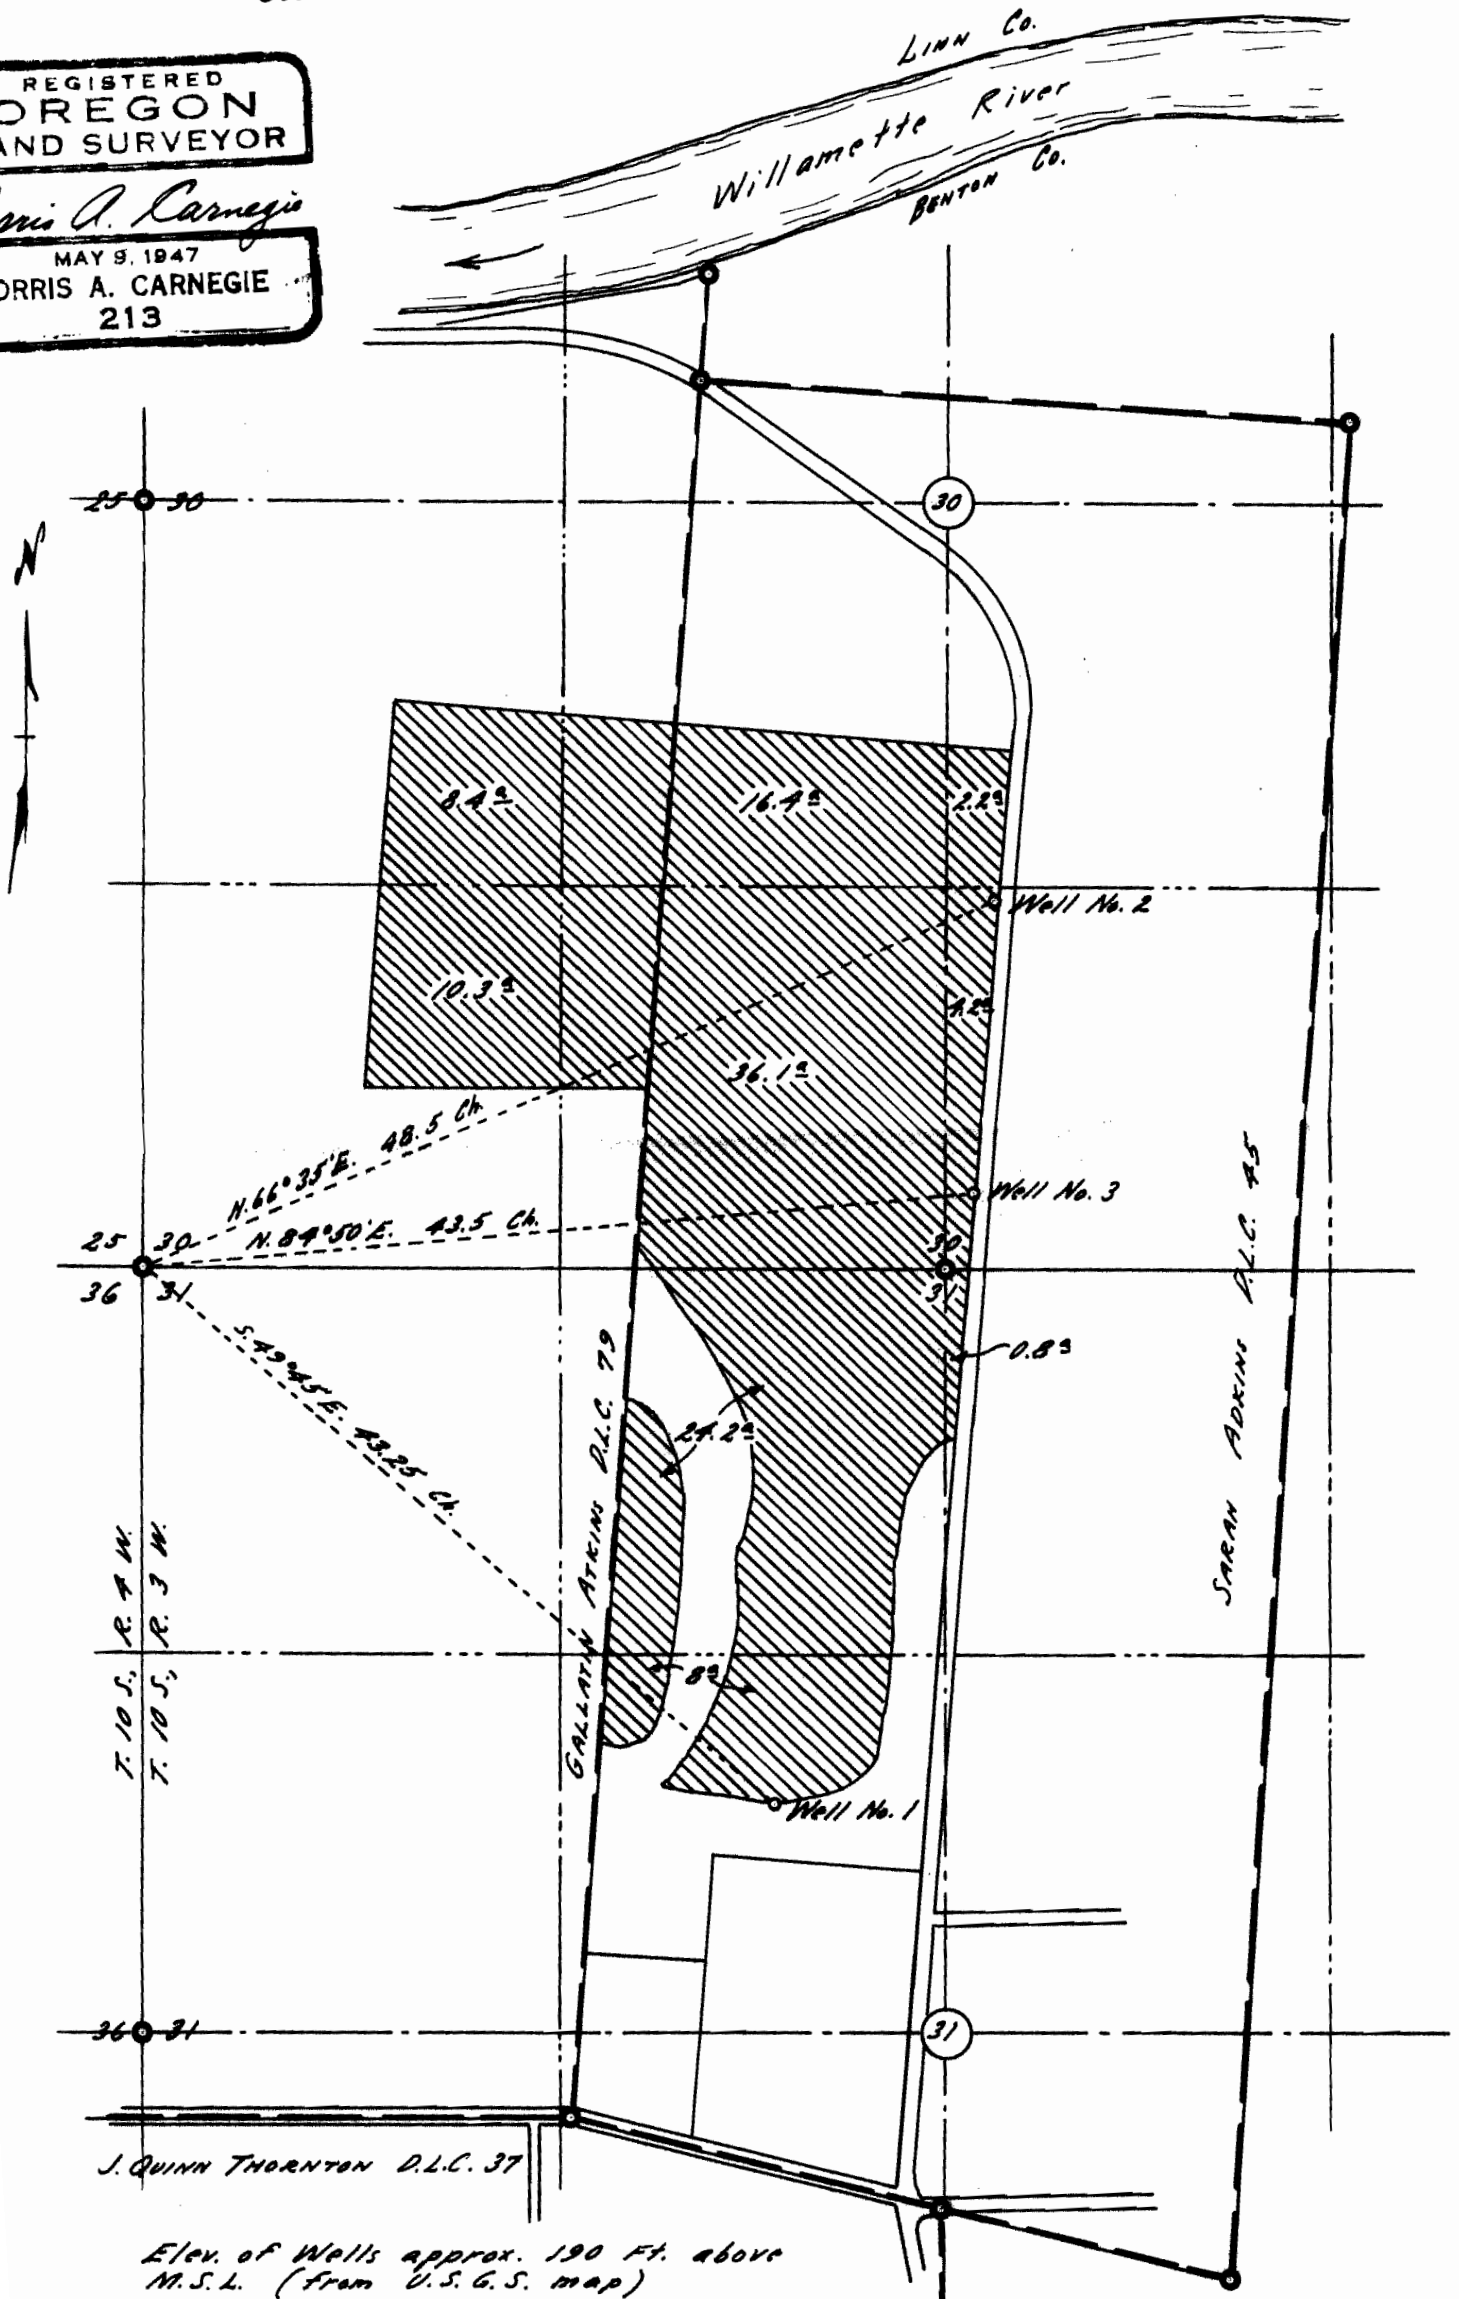

Elev. of Wells approx. 190 Ft. above
 M.S.L. (from U.S.G.S. map)

Application No. G-1801
 Permit No. G-1647