


EXHIBIT "A"

Permit #
ORPP # 6-15840

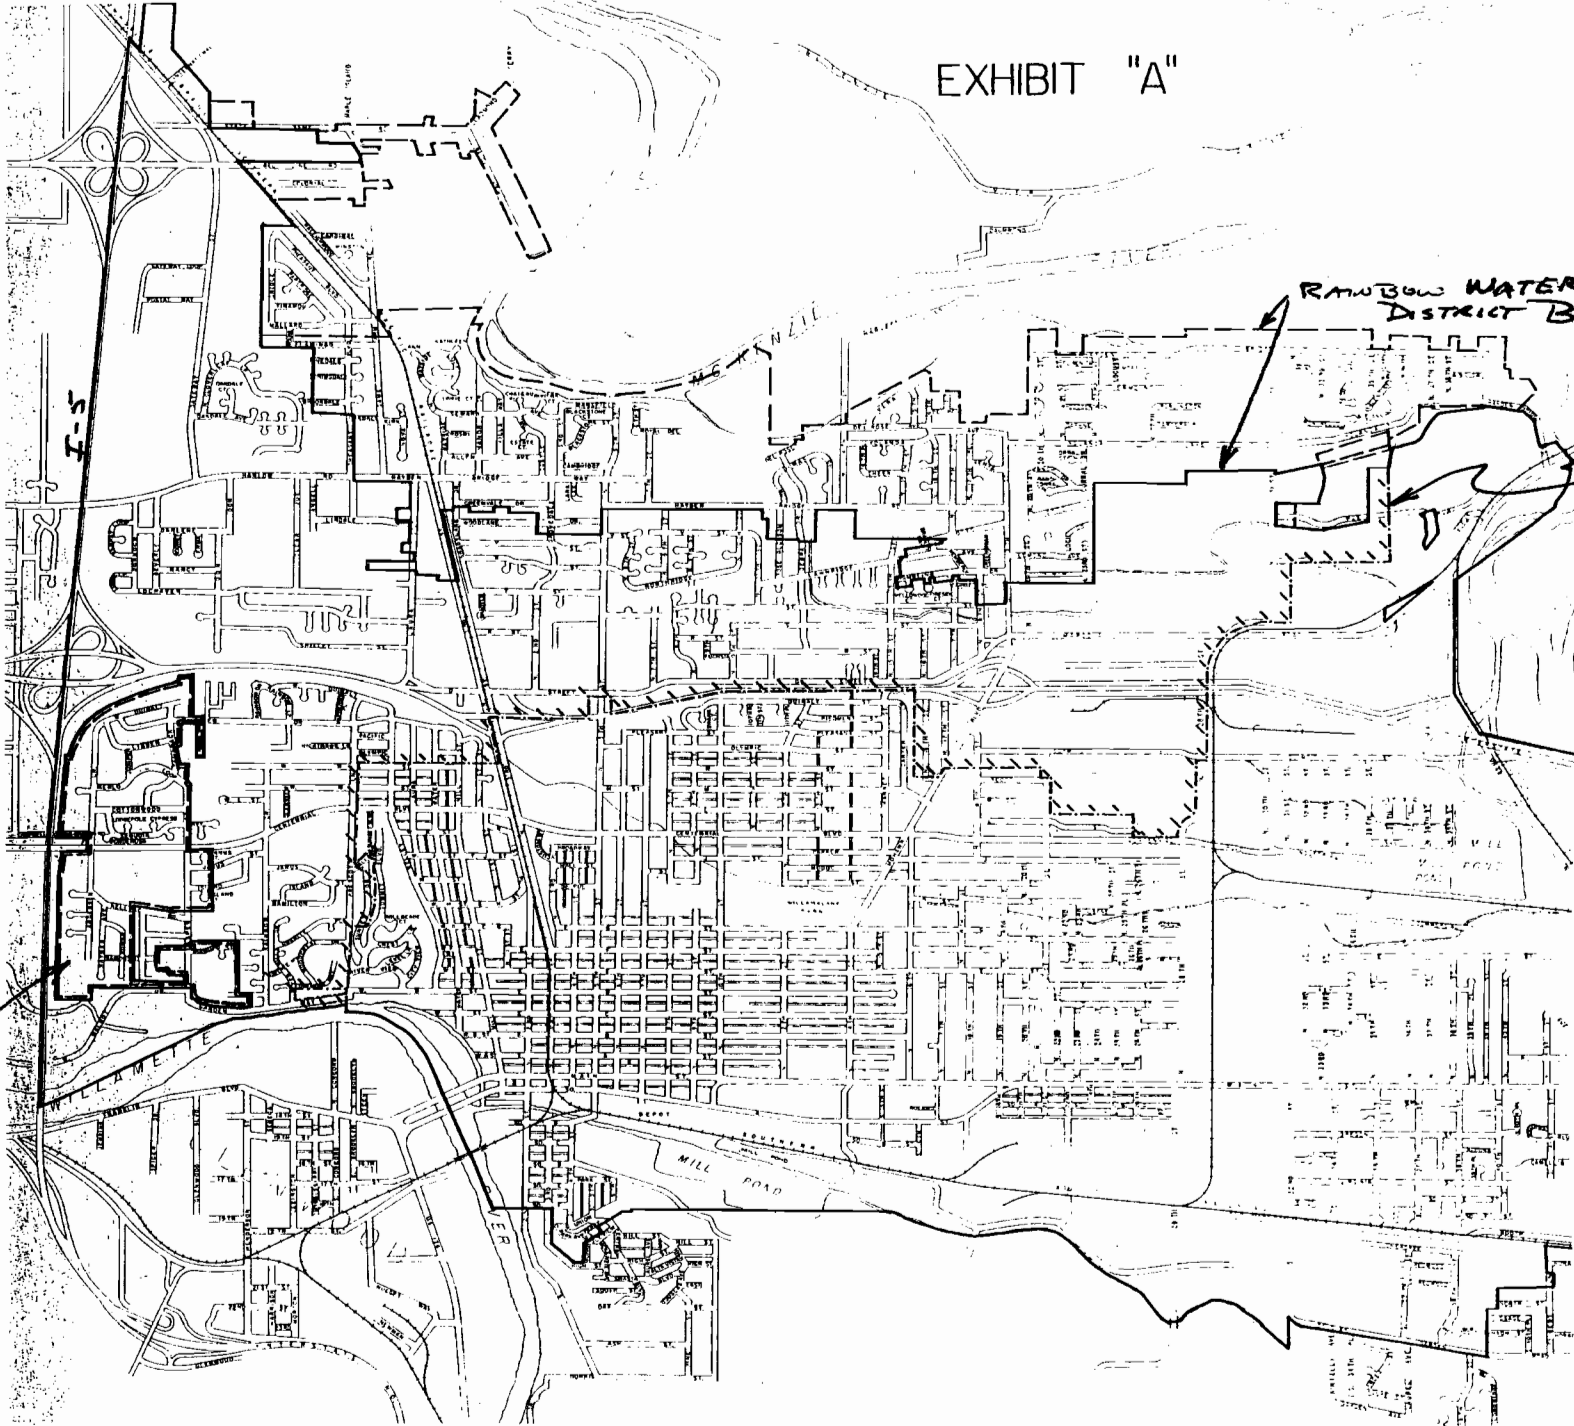

RAINBOW WATER DISTRICT BOUNDARY

FORMER
RAINBOW
WATER DISTRICT
BOUNDARY -
AREA NOW
SERVED BY
SUB

RAINBOW
WATER
DISTRICT
BOUNDARY

RECEIVED

SEP 19 2002



WATER RESOURCES DEPT.
SALEM, OREGON

CONVERSATION WITH ~~Asst.~~ Superintendent,
DEAN HILL OF RAINBOW WATER DISTRICT

EXIST. 80' PPEL
EASEMENT

9-19-02 R.W

TL 2500 17-03-10
ASLAUG KNOX, 2131 M-MILLEN
STREET, EUGENE, OR. 97405

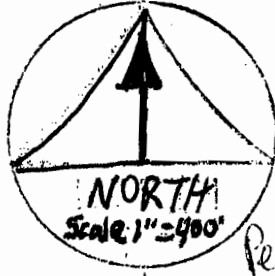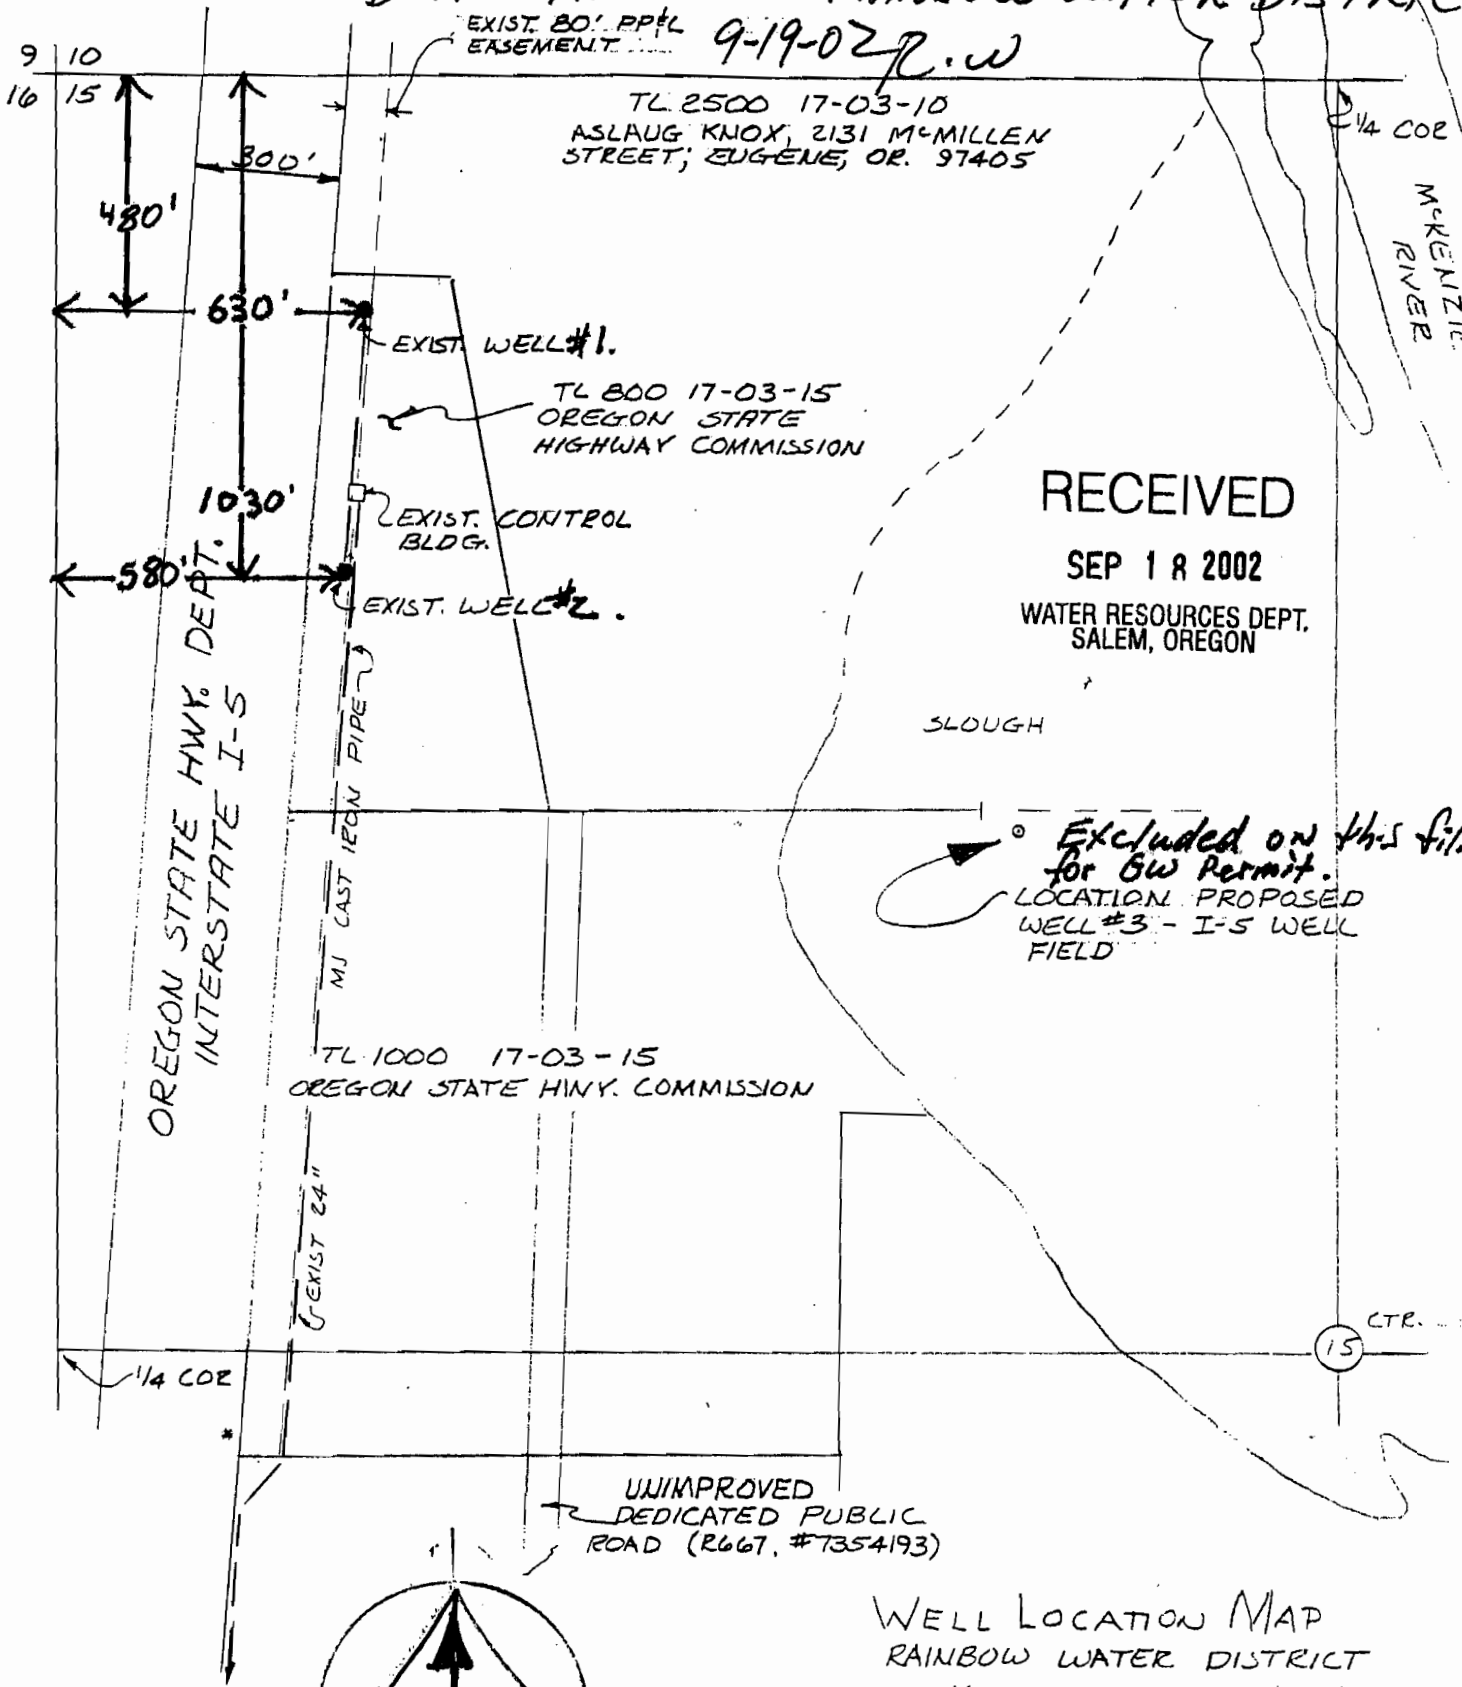

app # G-15840
Permit #

WELL LOCATION MAP
RAINBOW WATER DISTRICT
NW 1/4, SEC 15, T17S, R3WWM
PLANTS & ASSOCIATES
PROFESSIONAL ENGINEERS
& LAND SURVEYORS
54 CENTENNIAL LOOP
EUGENE, OREGON 97401