

SECTION PLAT

Section 5 & 6

Township 25-S


Range 33-E

County of HARNEY

State of OR

720

NORTH

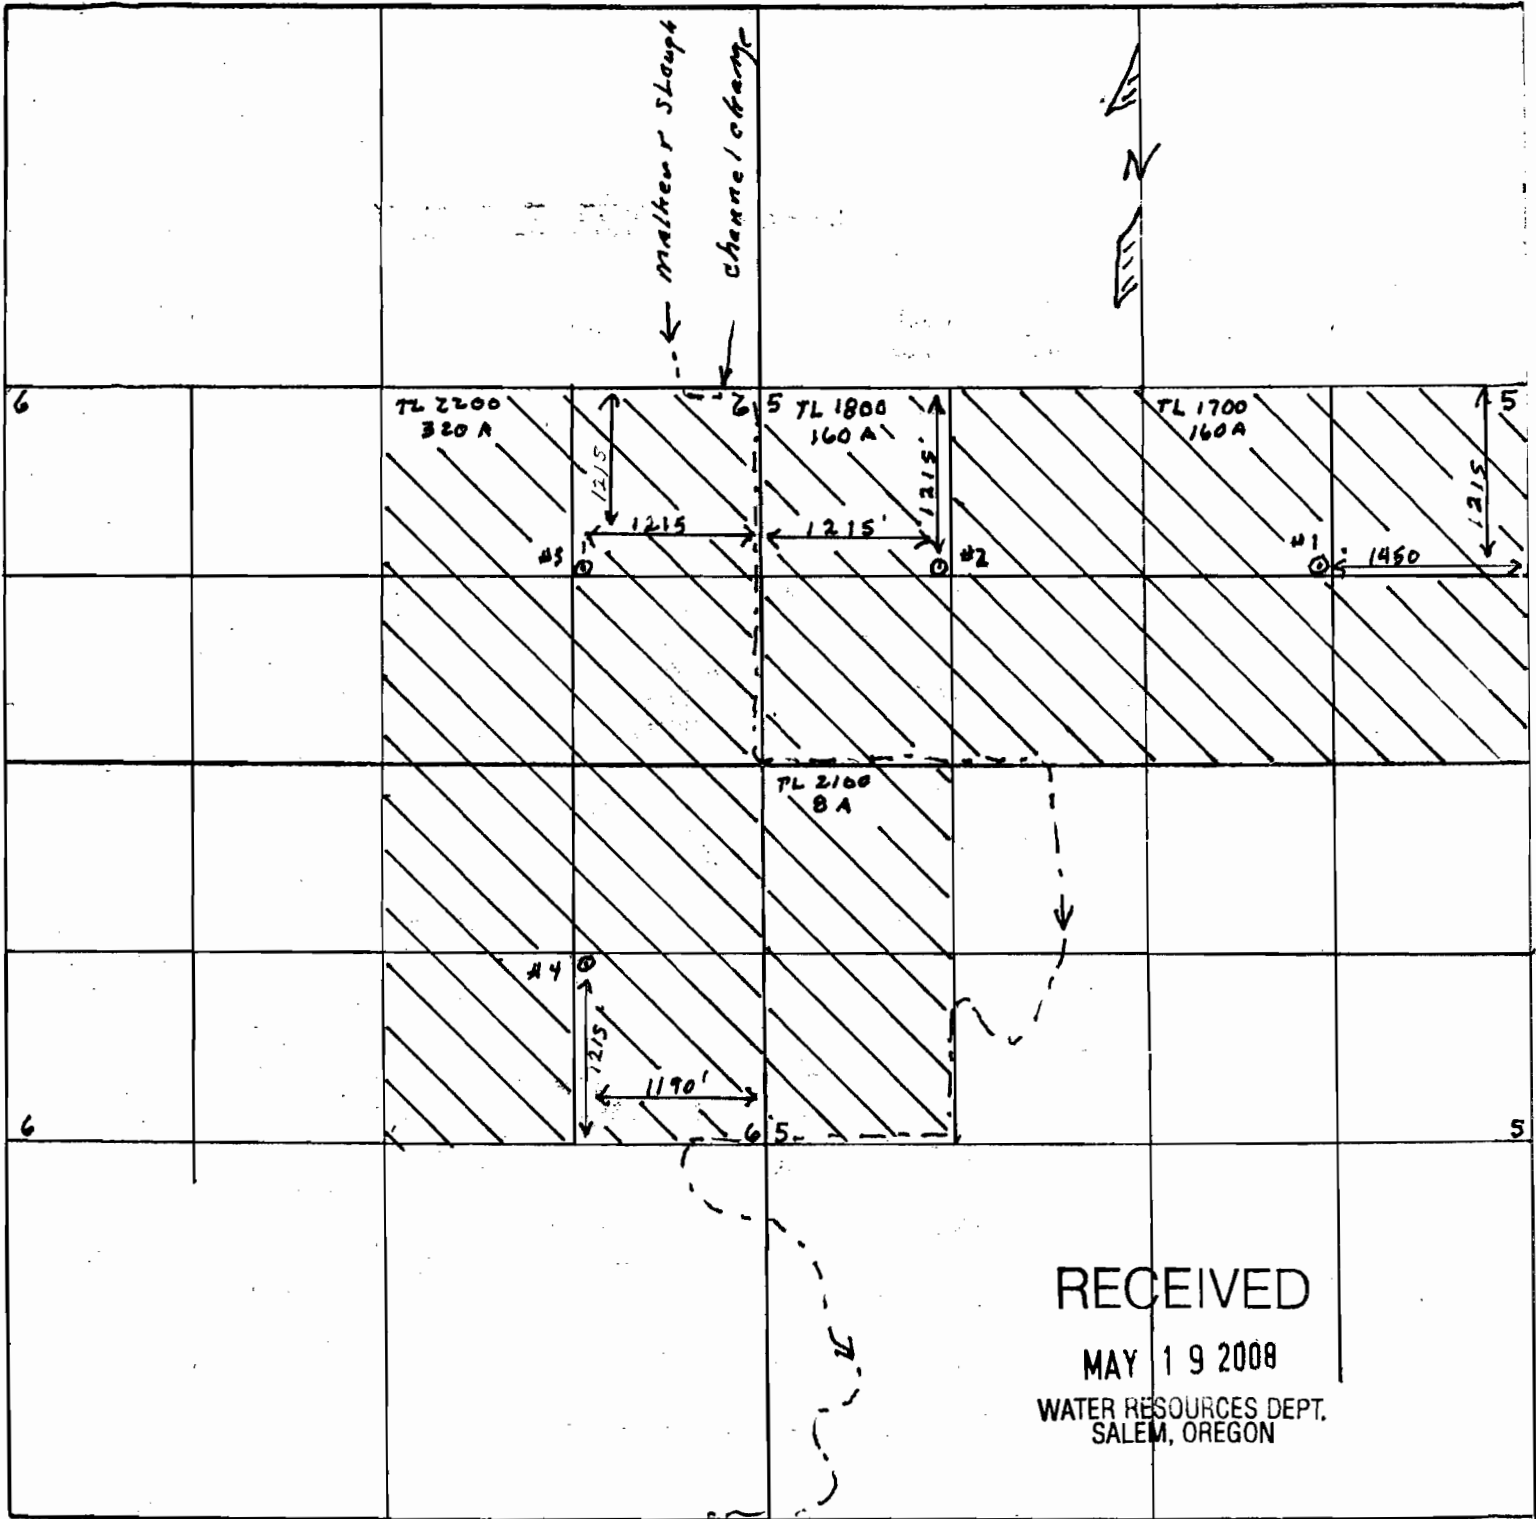

RECEIVED

MAY 19 2008

WATER RESOURCES DEPT.
SALEM, OREGON

Remarks scale - 8" = 1 mile - 660' -

RECEIVED

MAY 29 2008

WATER RESOURCES DEPT.
SALEM, OREGON

G-17062