

SECTION PLAT


Section 13

Township 23-S

Range 32.5-E

County of HARVEY State of OR

NORTH

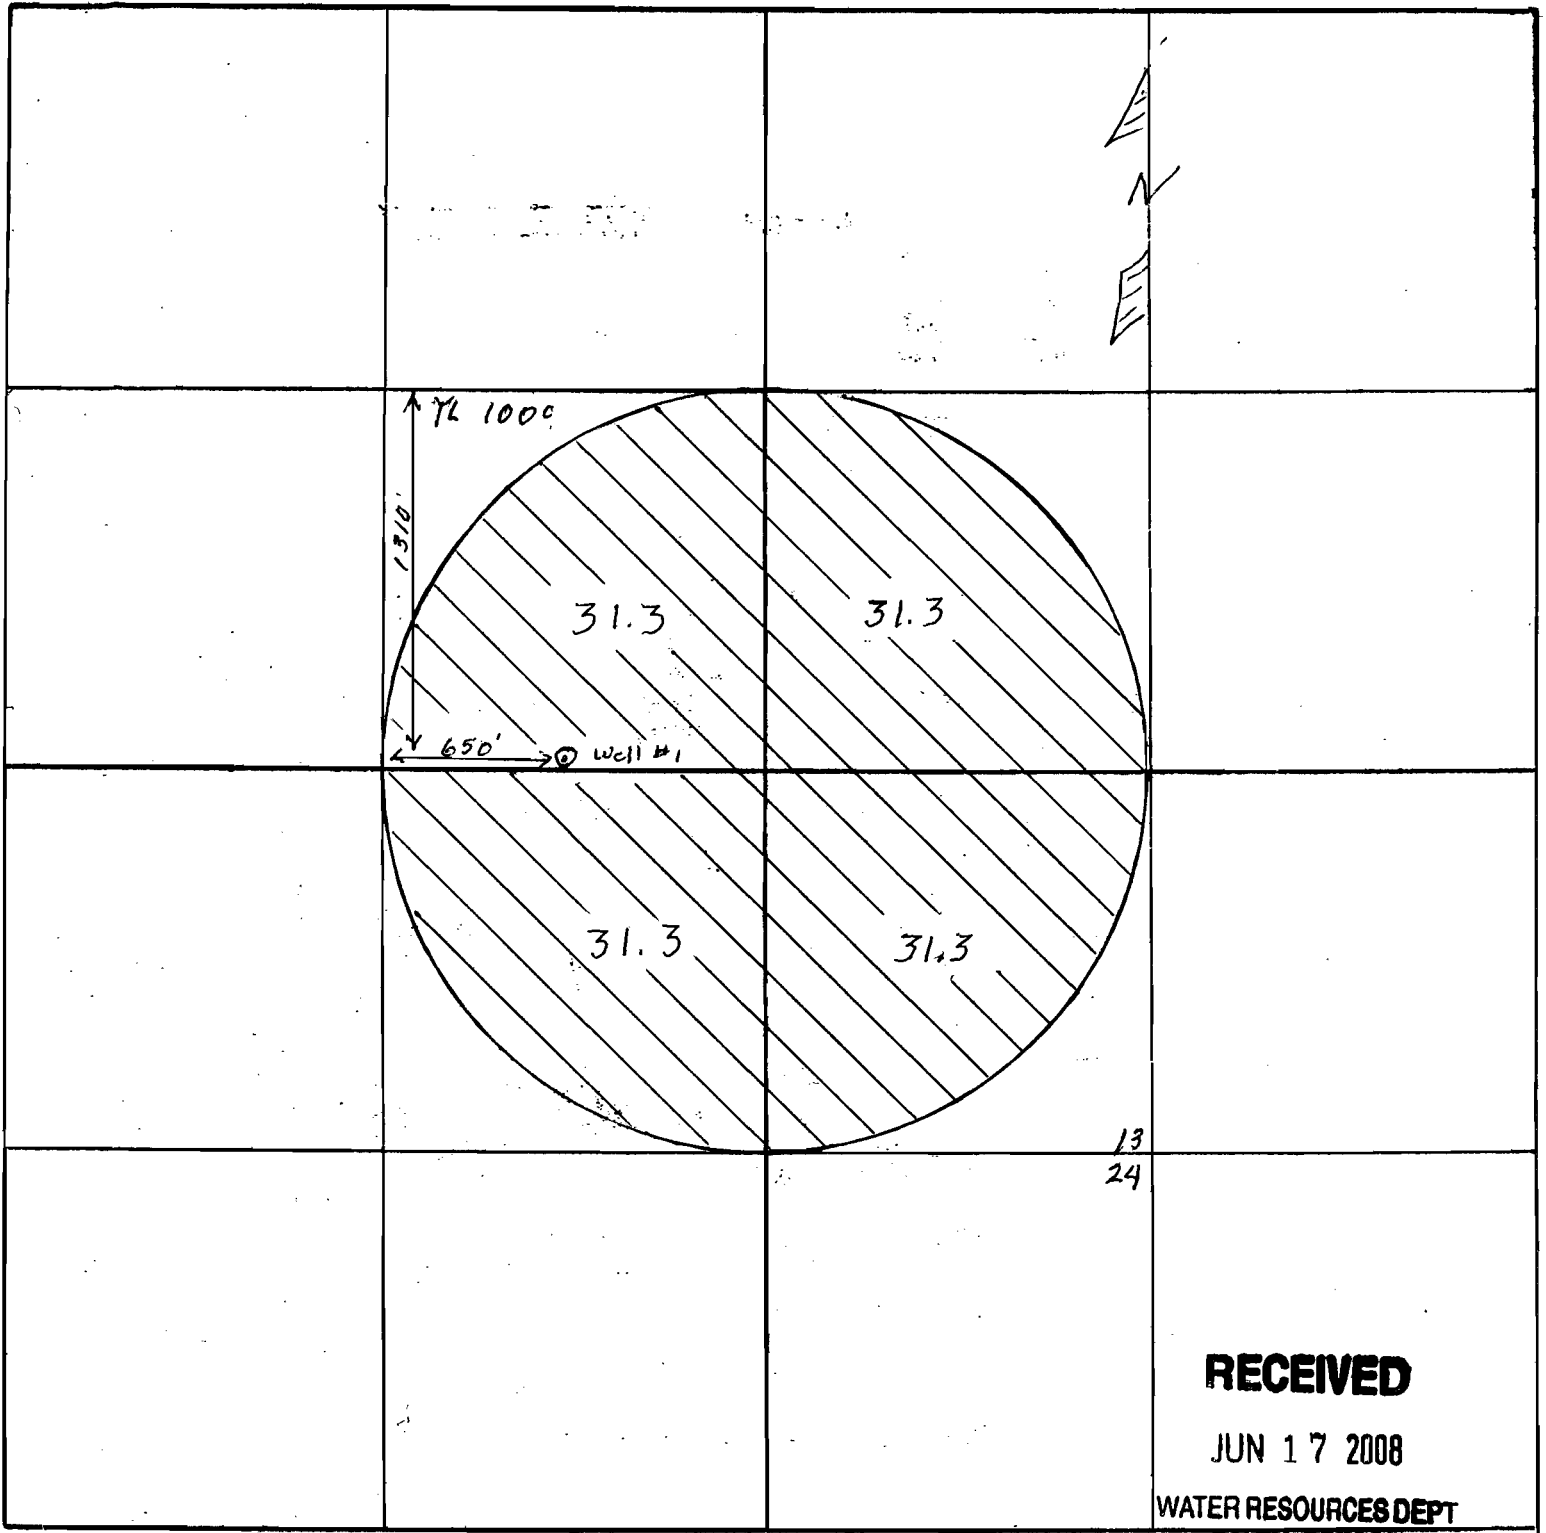

RECEIVED

JUN 17 2008

WATER RESOURCES DEPT
SALEM, OREGON

Remarks scale - 8" = 1 mile - 660' -

G-17071