


# SECTION PLAT

Section 3 Township 24-S Range 33-E

County of Harney State of OR

NORTH

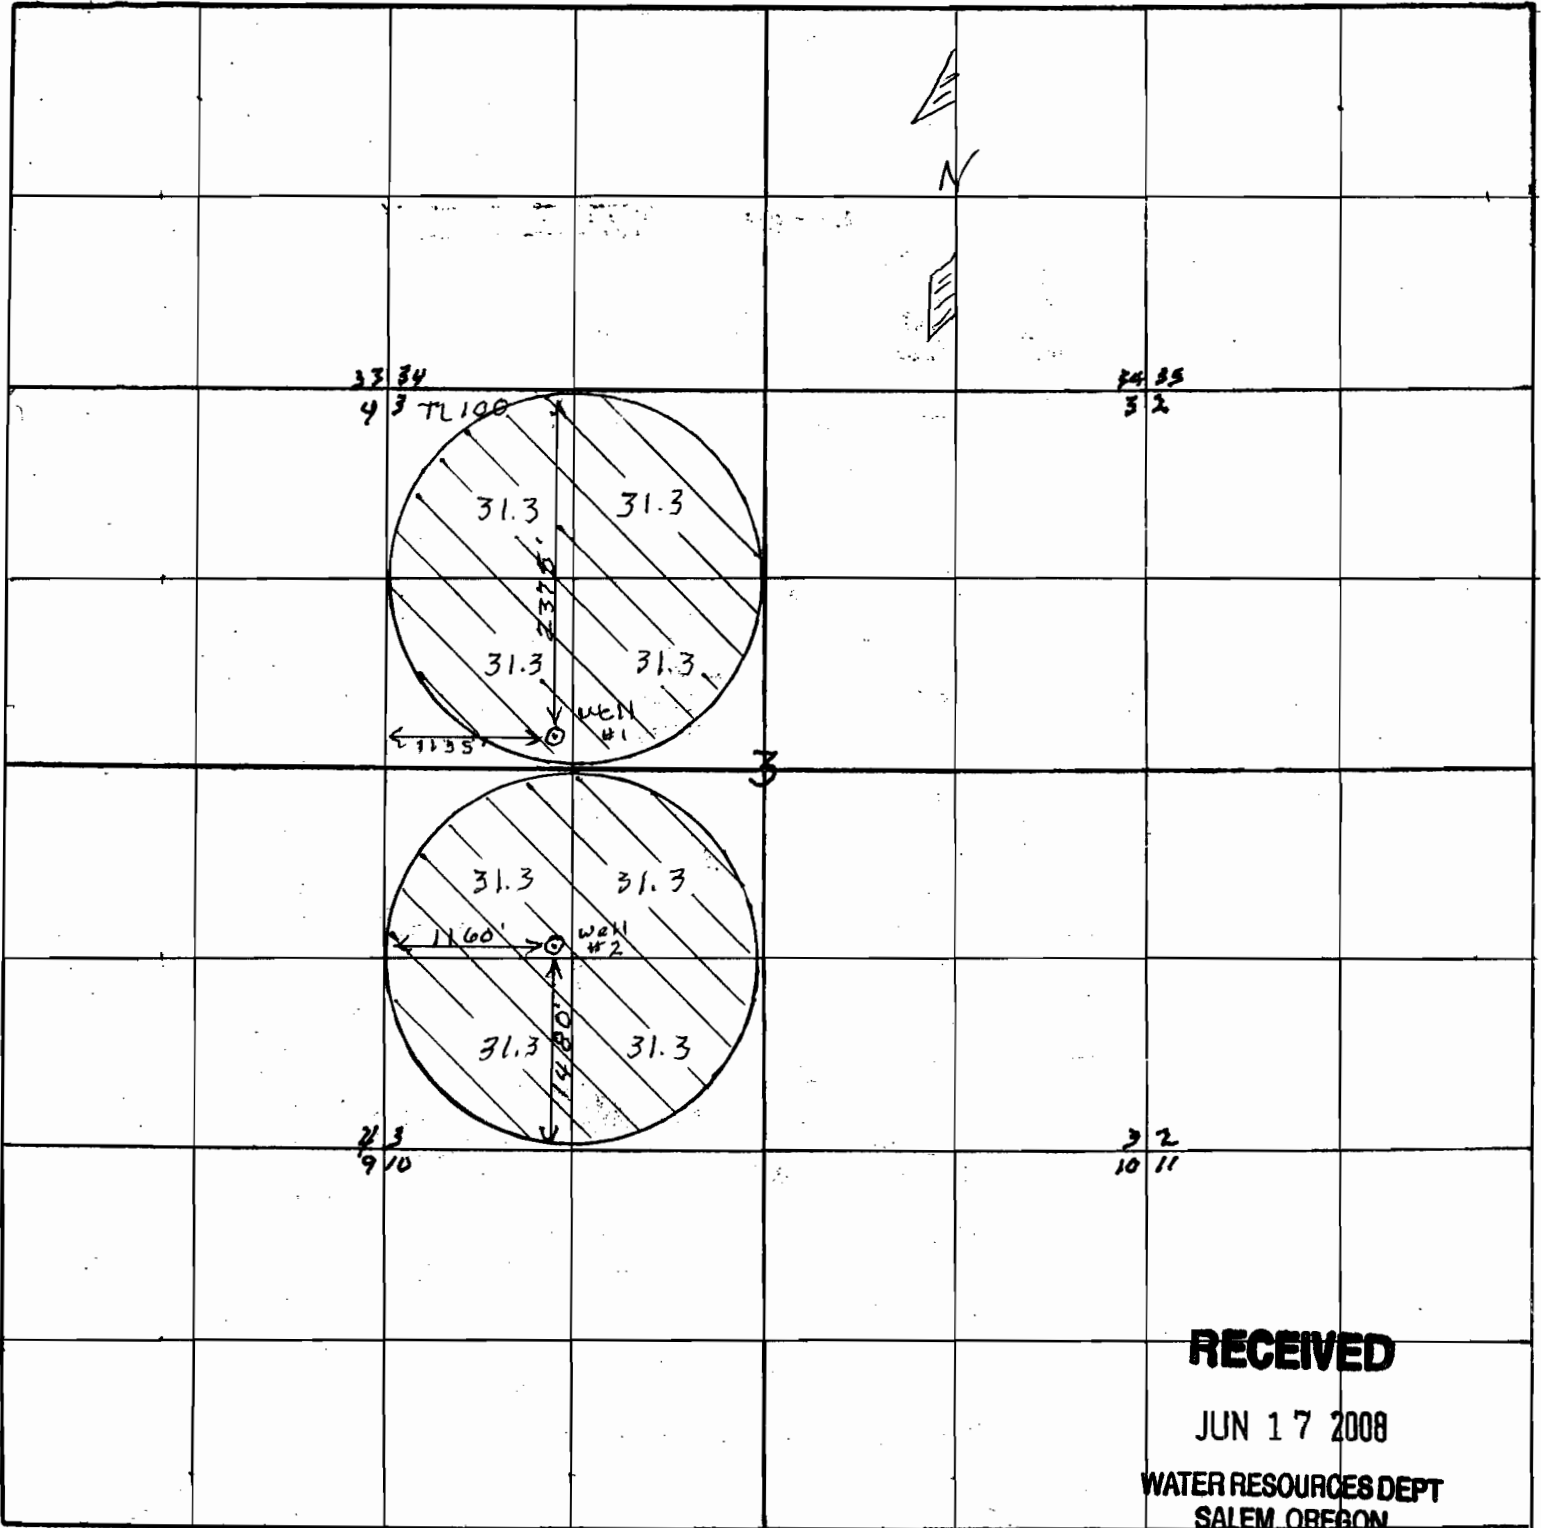

S

Remarks scale - 4" = 1 mile - 660' - 1" = 1320'

G-17072