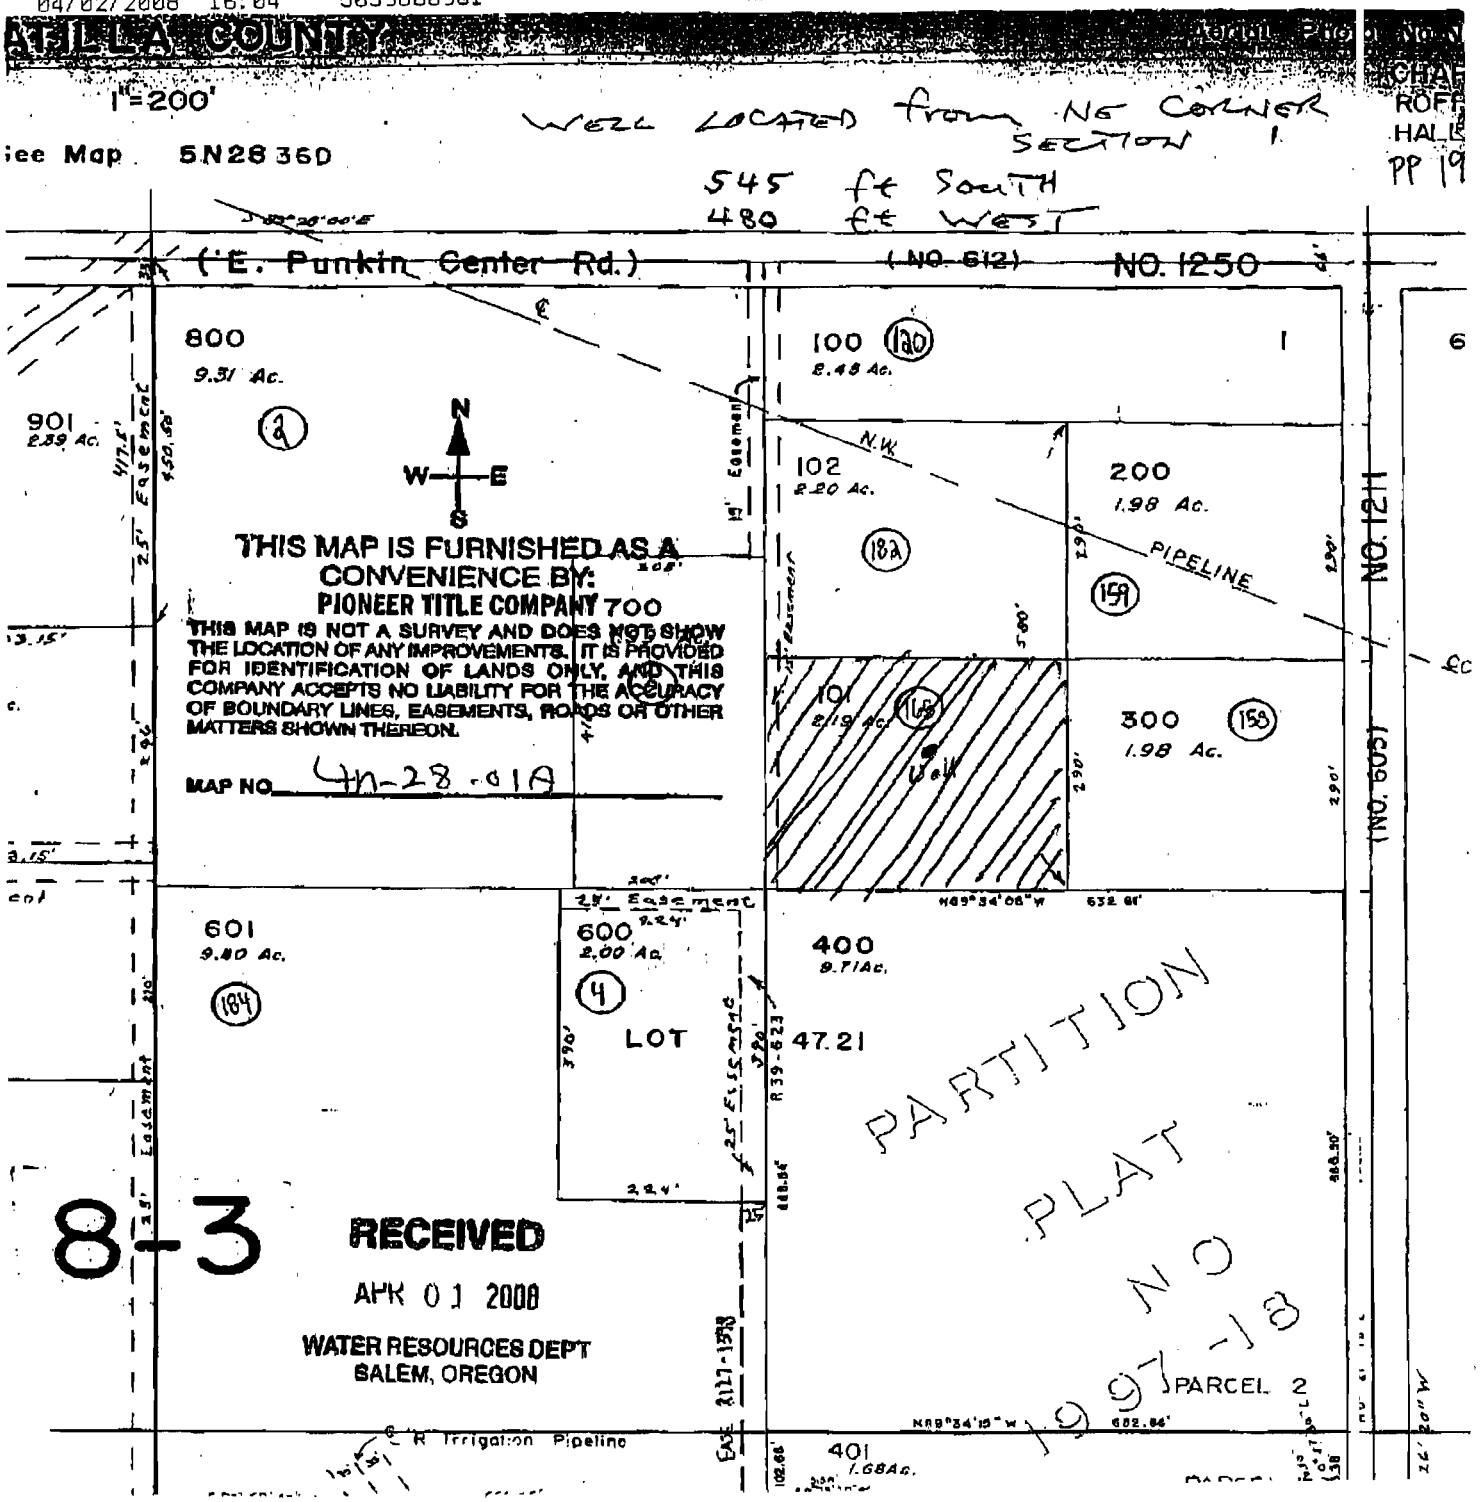

NE1/4 NE1/4 SEC 1 T 4N R 28E W/M

UMATILLA COUNTY, OR

SCALE: 1" =200'

Appl. G-17030

Virginia Blade
4-2-08