


UMATILLA County
UMATILLA BASIN
(Tax Lot 1400, MAP 2430A)

T.2N. R. 30E.W.M.

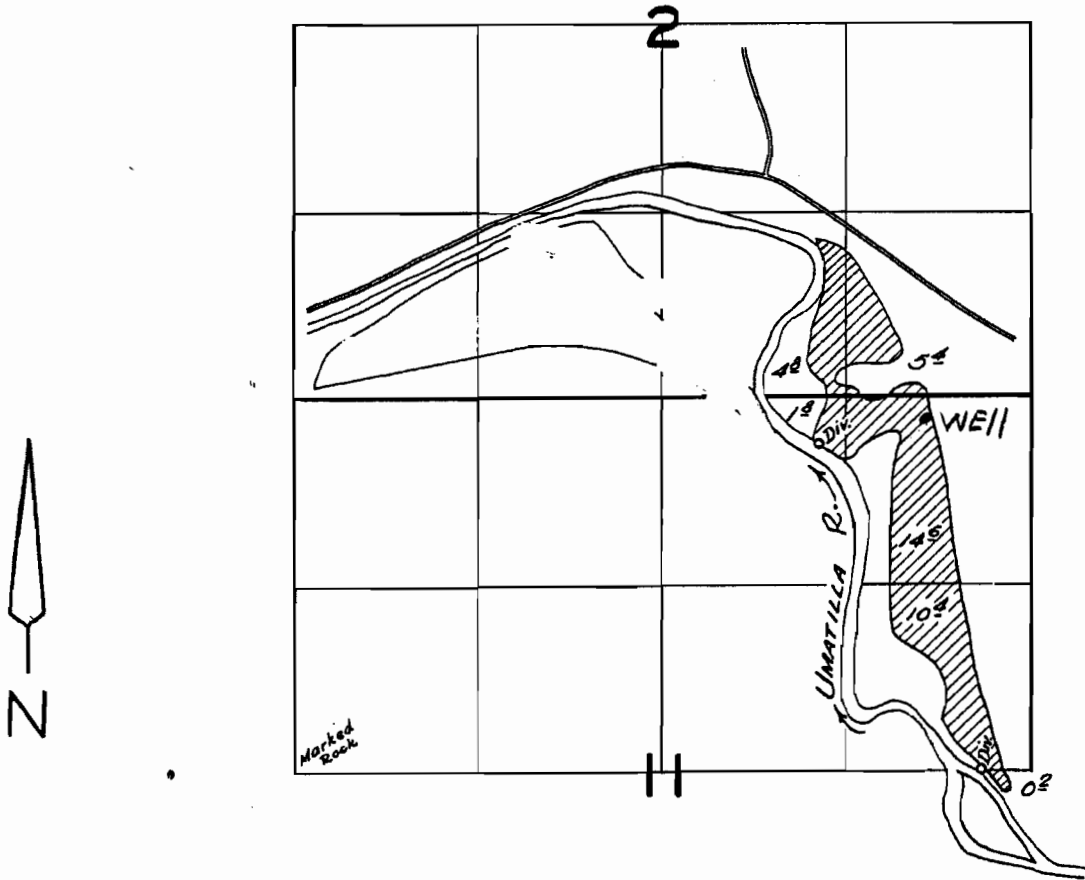

Well Loc. 180 Ft. South + 620 Ft. West
OF S.E. CORNER OF SECTION 2, T.2N. R.30E. W.M.

KENT BEEBE, SUPPLEMENTAL IRRIGATION
GROUND WATER APPLICATION.
Date: 4-4-08

RECEIVED

APR 09 2008

WATER RESOURCES DEPT
SALEM, OREGON

SCALE = 4" = 1 MILE

39.45

39.45

LOT 39.45

500
106.23 Ac.

LOT 39.67

LOT 39.89

400
7.50 Ac.

300
110.88 Ac.

LOT 40.10

LOT 40.10

21
98

LC

WORK COPY

YOAKUM RD
(Yoakum Market Rd.)
NO. 1125

1000
164.00 Ac.

16-

2

900
49.00 Ac.

600

CO. RD.

Existing well

16-29
Road Location

16-22

1200
22.00 Ac.

16-

1600
9.00 Ac.

1500
109.75 Ac.

1400
86.00 Ac.

(NO. 799)

16-22

CTR LINE UMATILLA RIVER
FROM ASCS AERIAL PHOTO
DATED 1971

16-29
16-27

NE Corner
Section 11
Proposed new well

SEE

located 330 feet South
and 620 feet West from
NE Corner, Section 11,
T2N, R30E, W.M.

2000
520.00 Ac.

11

16-27

THIS MAP IS FURNISHED AS A
CONFORMANCE BY:
FISHER TITLE COMPANY

THIS MAP IS NOT A SURVEY AND DOES NOT SHOW
THE LOCATION OF ANY IMPROVEMENTS. IT IS PROVIDED
FOR THE IDENTIFICATION OF LOTS ONLY AND THIS
COMPANY ACCEPTS NO LIABILITY FOR THE ACCURACY
OF BOUNDARY LINE DETERMINATIONS, RECORDS OR OTHER
MATTERS SHOWN THEREON.

MAP NO.

2N30A

SEE-MAP

2000

RECEIVED

DEC 10 2008

WATER RESOURCES DEPT
SALEM, OREGON

S 89° 56' W

79.96 ch.


S 89° 39' W

App No G-17033

G-5051

49140

T. 2N. R. 30E. W.M.

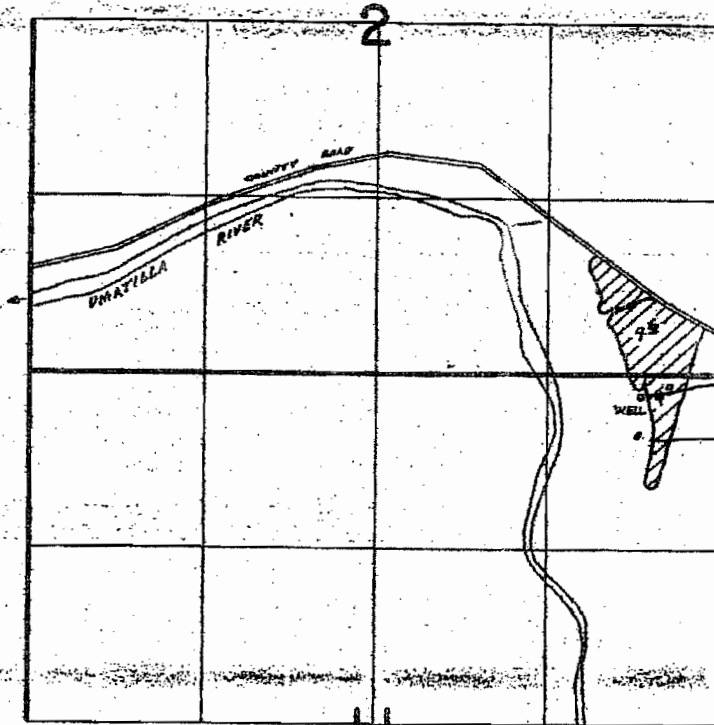

WELL LOC. 180'S & 620'W FROM SE COR OF SEC 2

FINAL PROOF SURVEY
UNDER

Application No. G-5988... Permit No. G-5051...
IN NAME OF

ROBERT U. GENTNER

Surveyed 8-11 1978, by R. BARWIN

RECEIVED

DEC 10 2008

WATER RESOURCES DEPT
SALEM OREGON

FL10A-12 V.L.C.