

SCALE: 1"=660'

RECEIVED BY OWRD

AUG 28 2013

SALEM, OR

RECEIVED BY OWRD


AUG 05 2013

SALEM, OR

Well # 1 is a domestic well not used for irrigation: Latitude: 43 56'56.83178" N, Longitude: 117 06'32.12845" W.

Well # 2 is the irrigation well
Latitude: 43 56'56.78222" N, Longitude: 117 06' 33.39427" W.

JUNE 28, 2013

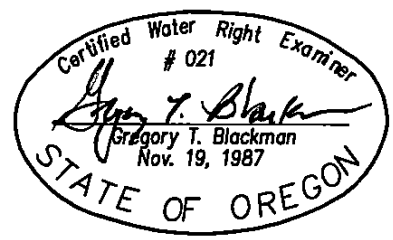

CLAIM OF BENEFICIAL USE MAP FOR
PRIMARY IRRIGATION FROM WELL NUMBER
2 UNDER PERMIT NUMBER G-16524

FOR
GREG SCHNEIDER

BY
GREG BLACKMAN WATER RIGHTS
126 RIDGE DRIVE
LA GRANDE, OREGON 97850

NOTE: The preparation of this map was for the purpose of identifying the location of the proposed water right and has no intent to provide dimensions or location of property ownership lines. Location information shown hereon was furnished by the applicant.

APPLICATION NO. G-17105
PERMIT NUMBER G-16524