

LEGEND

LINE TYPES

- LOT BOUNDARY OLD PROPERTY LINE
- RIGHT-OF-WAY VACATED RIGHT-OF-WAY
- ROAD RAILROAD RIGHT-OF-WAY
- STREAM, LAKE, ETC. NON-BOUNDARY
- SECTION BOUNDARY PARTITION PLAT BDY.
- SECTION CODE BOUNDARY EASEMENT

SYMBOL TYPES


- D.L.C.
- CONTROL POINTS
- SURVEY MONUMENTS
- G.L.O. CORNERS

NUMBERS

TAX CODE NO. 000 00 00 0


ACREAGE - ALL ACREAGES EXCLUDE ANY PORTION THAT MAY LIE WITHIN THE INDICATED PUBLIC RIGHT OF WAYS.

TICK MARKS - WHEN A TICK MARK IS INDICATED ON THE EXTENSION OF A LINE, THEN THE DIMENSION GOES TO THE TICK MARK. GENERALLY THIS IS USED WHEN DIMENSIONS GO INTO PUBLIC RIGHT OF WAYS.

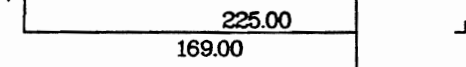


ARROWS ARE USED WITH DIMENSIONS IN AREAS OF GREATER COMPLEXITY.

NOTICE: This map was created for Assessor's office use ONLY.

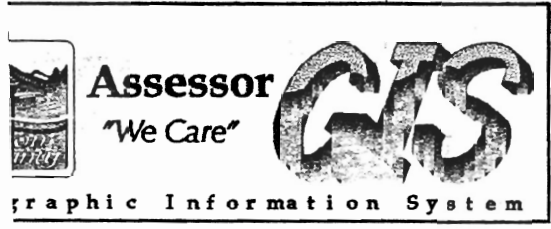

OCT 18 2007

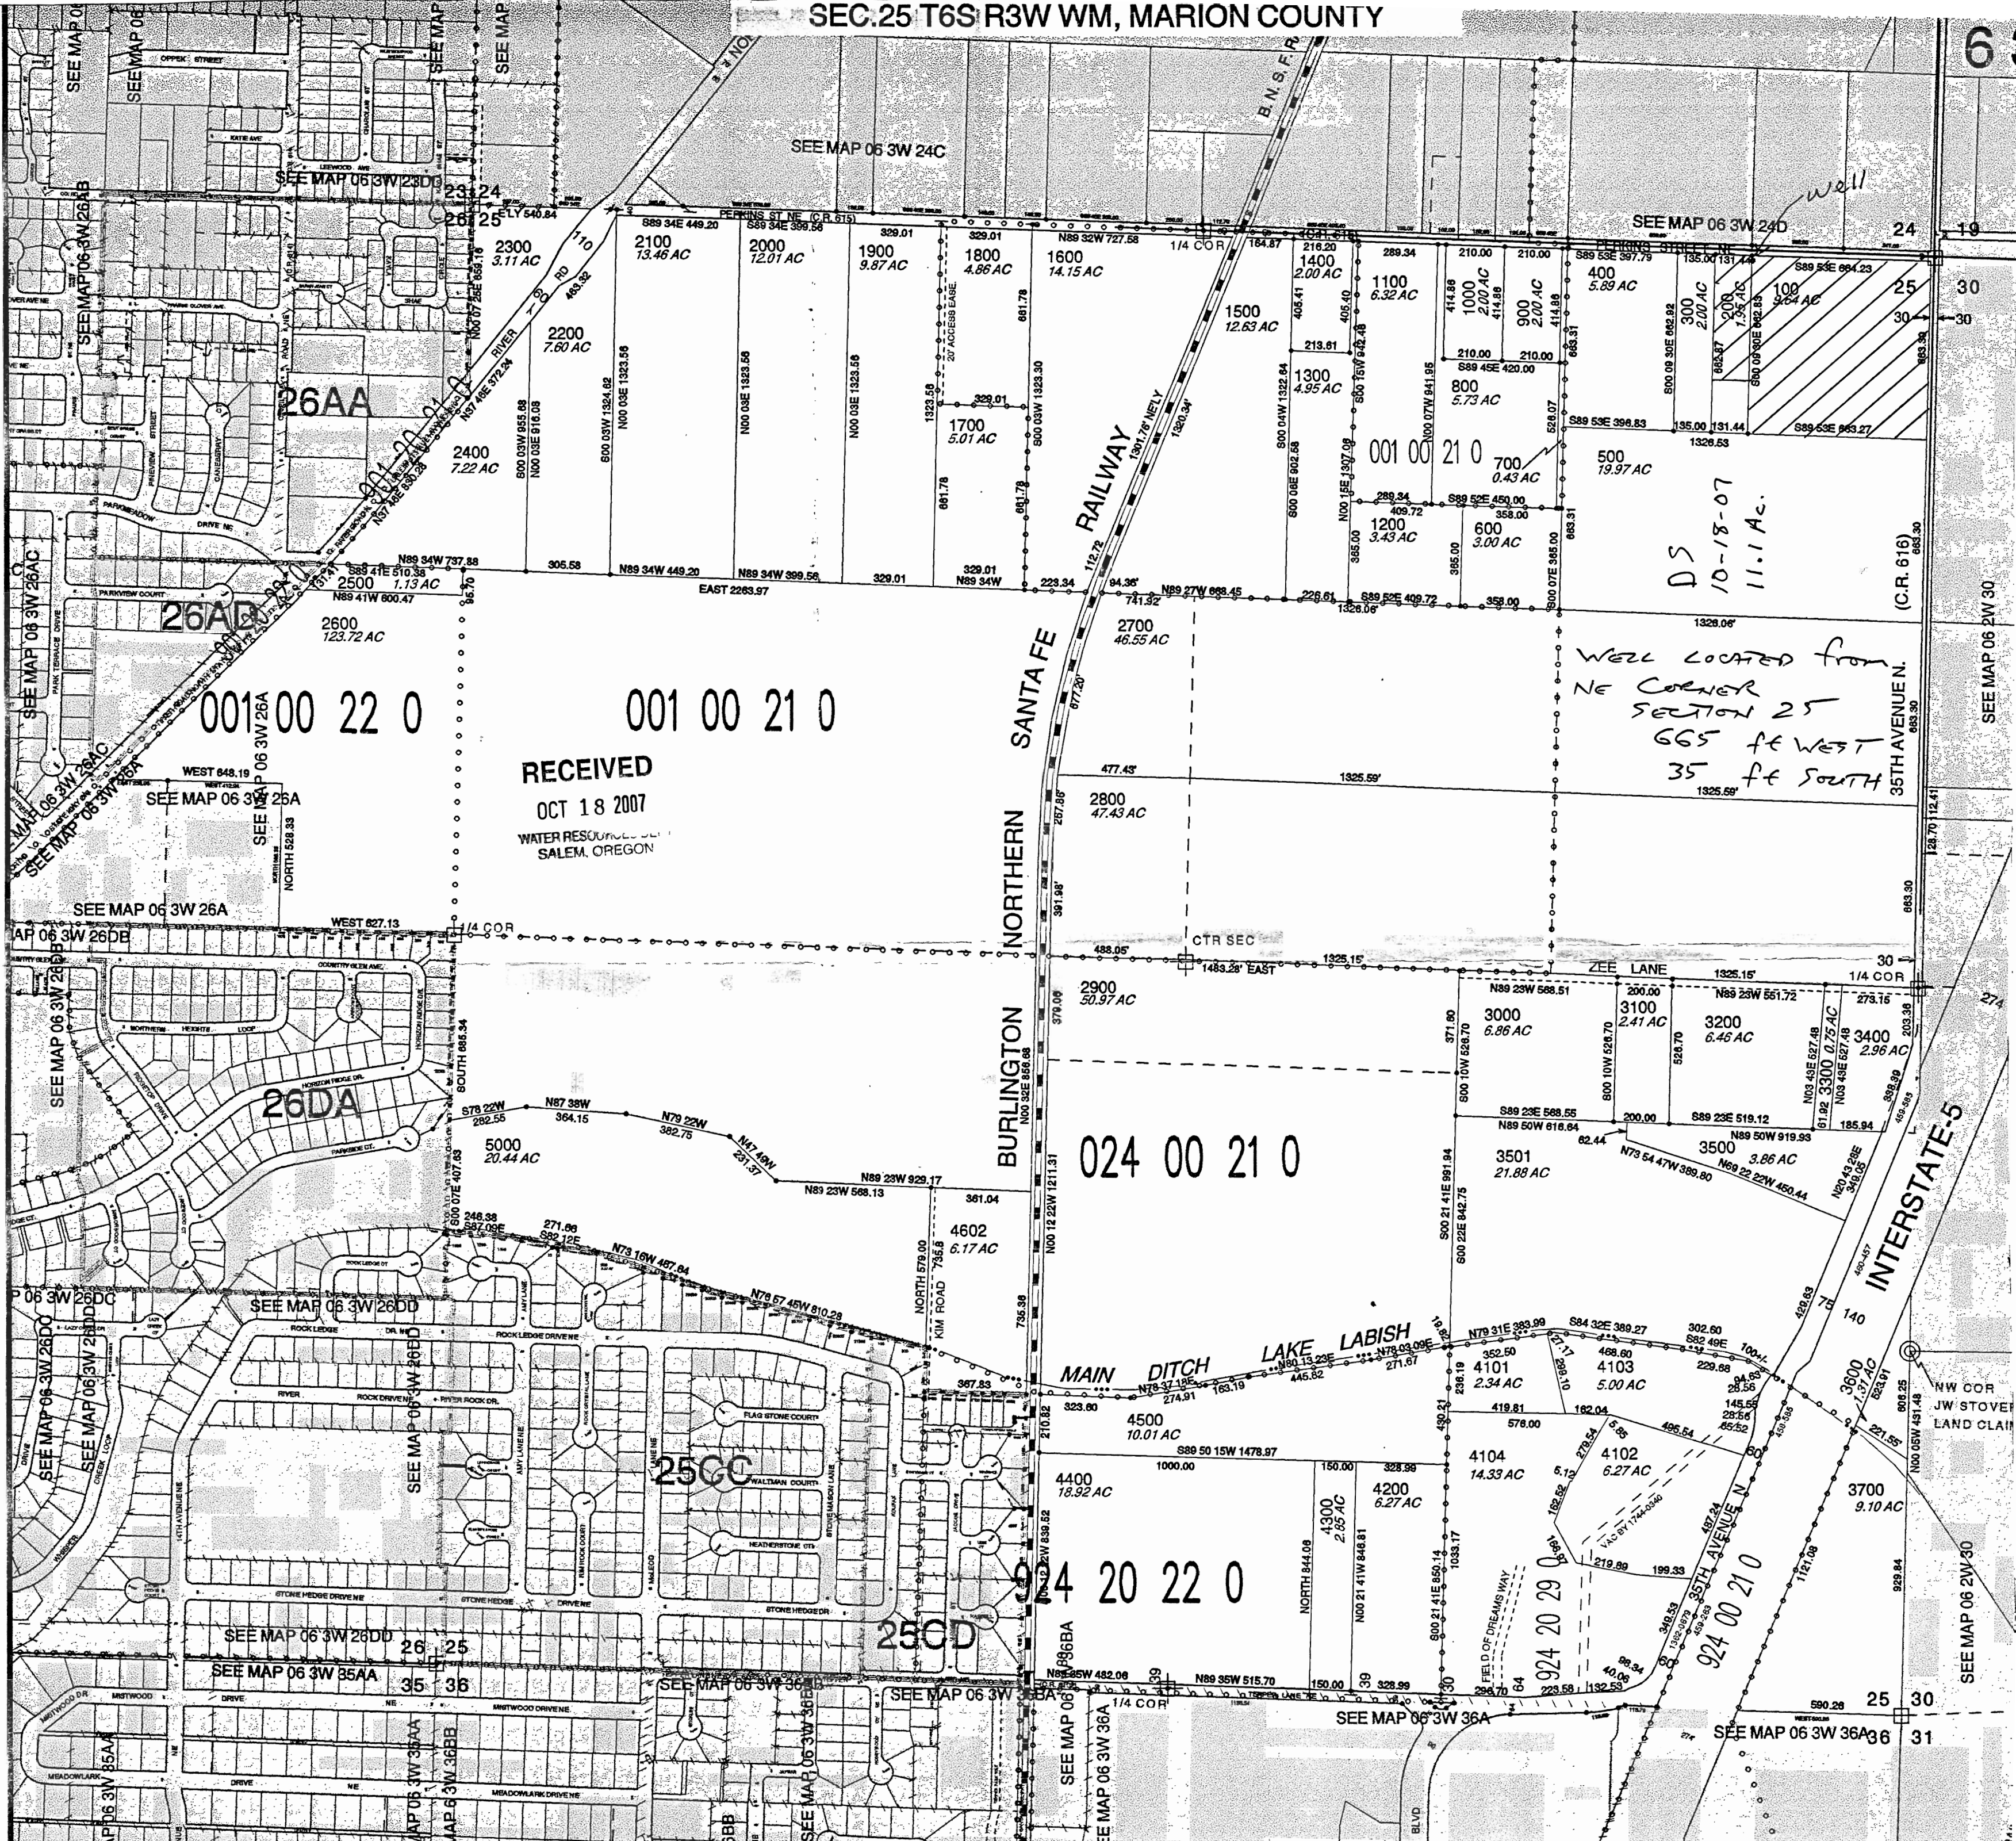

RECEIVED OCT 18 2007 WATER RESOURCES DIVISION SALEM, OREGON

WELL LOCATED FROM NE CORNER SECTION 25 665 FE WEST 35 FE SOUTH 35TH AVENUE N.

DS 10-18-07 11.1 AC.

001 00 22 0

001 00 21 0

024 00 21 0

024 20 22 0

924 00 21 0

924 20 29 0