




Attachment (A)

T. 23S. R. 31E. W.M.

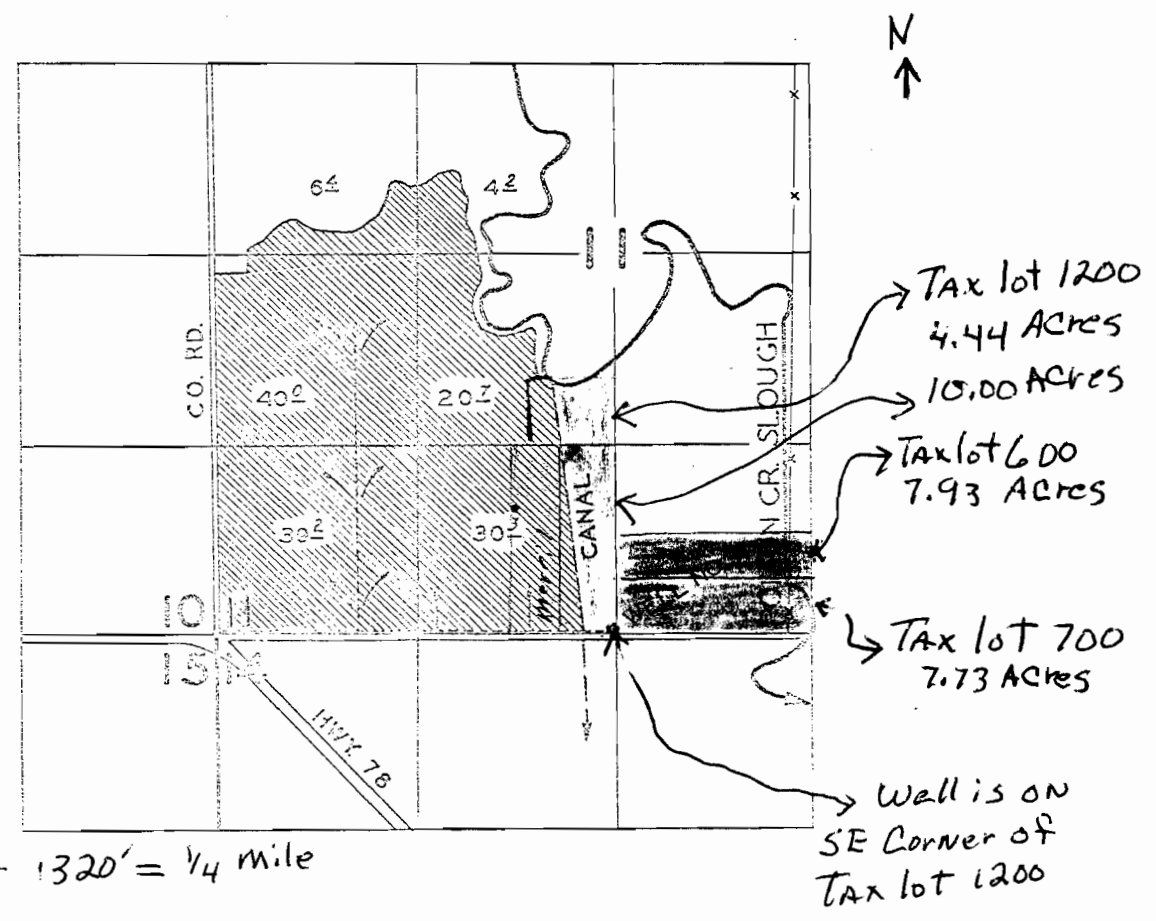

RECEIVED
 DEC 08 2006
 WATER RESOURCES DEPT
 SALEM, OREGON

T. 23 S. R. 31 E. W.M.

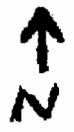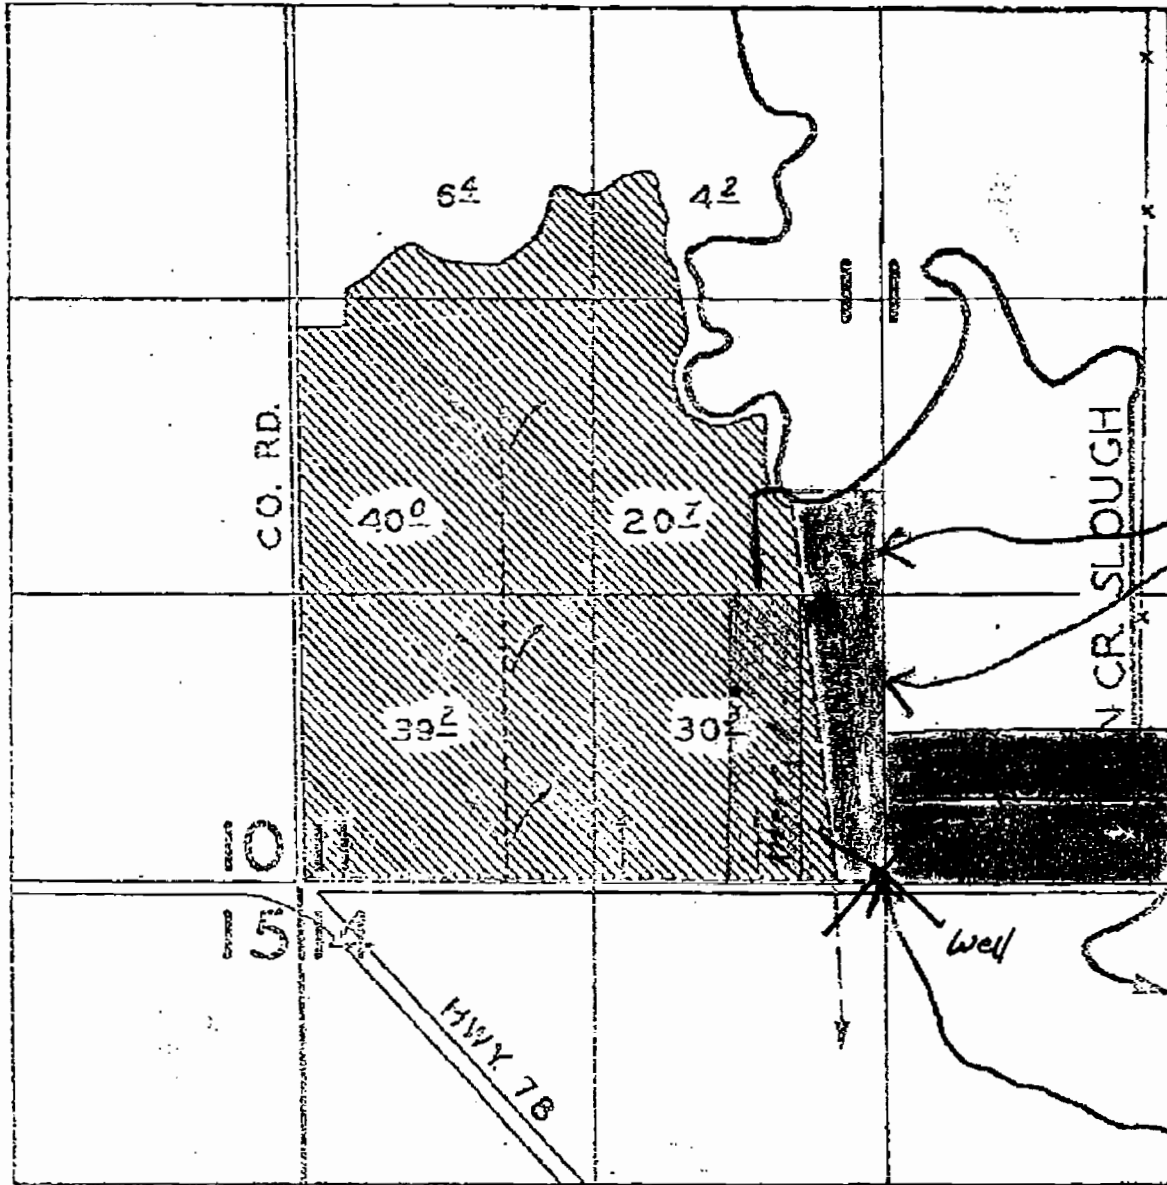

1200
 TAX lot 1200
 4.44 Acre

10.00 Acre
 TAX lot 600
 7.93 Acres

700
 TAX lot 700
 7.73 ACRES

Well is on
 SE Corner of
 TAX lot 1200
 (18' North of Aquest line & 85' W of Property line)

WELL IS LOCATED DUE SOUTH
 FROM CENTER OF SECTION 11
 APPROX. 2580 FT. UTM

Scale - 1320' = 1/4 mile
 APPROX REVISED UTM
 CORRECTED SCALE
 1" = 800 FEET

app no G-16762