


SECTION PLAT

*Thad & Joyce Geer*  
8-7-08

Section 2 & 10 Township 23s Range 31E  
County of Harney State of Oregon

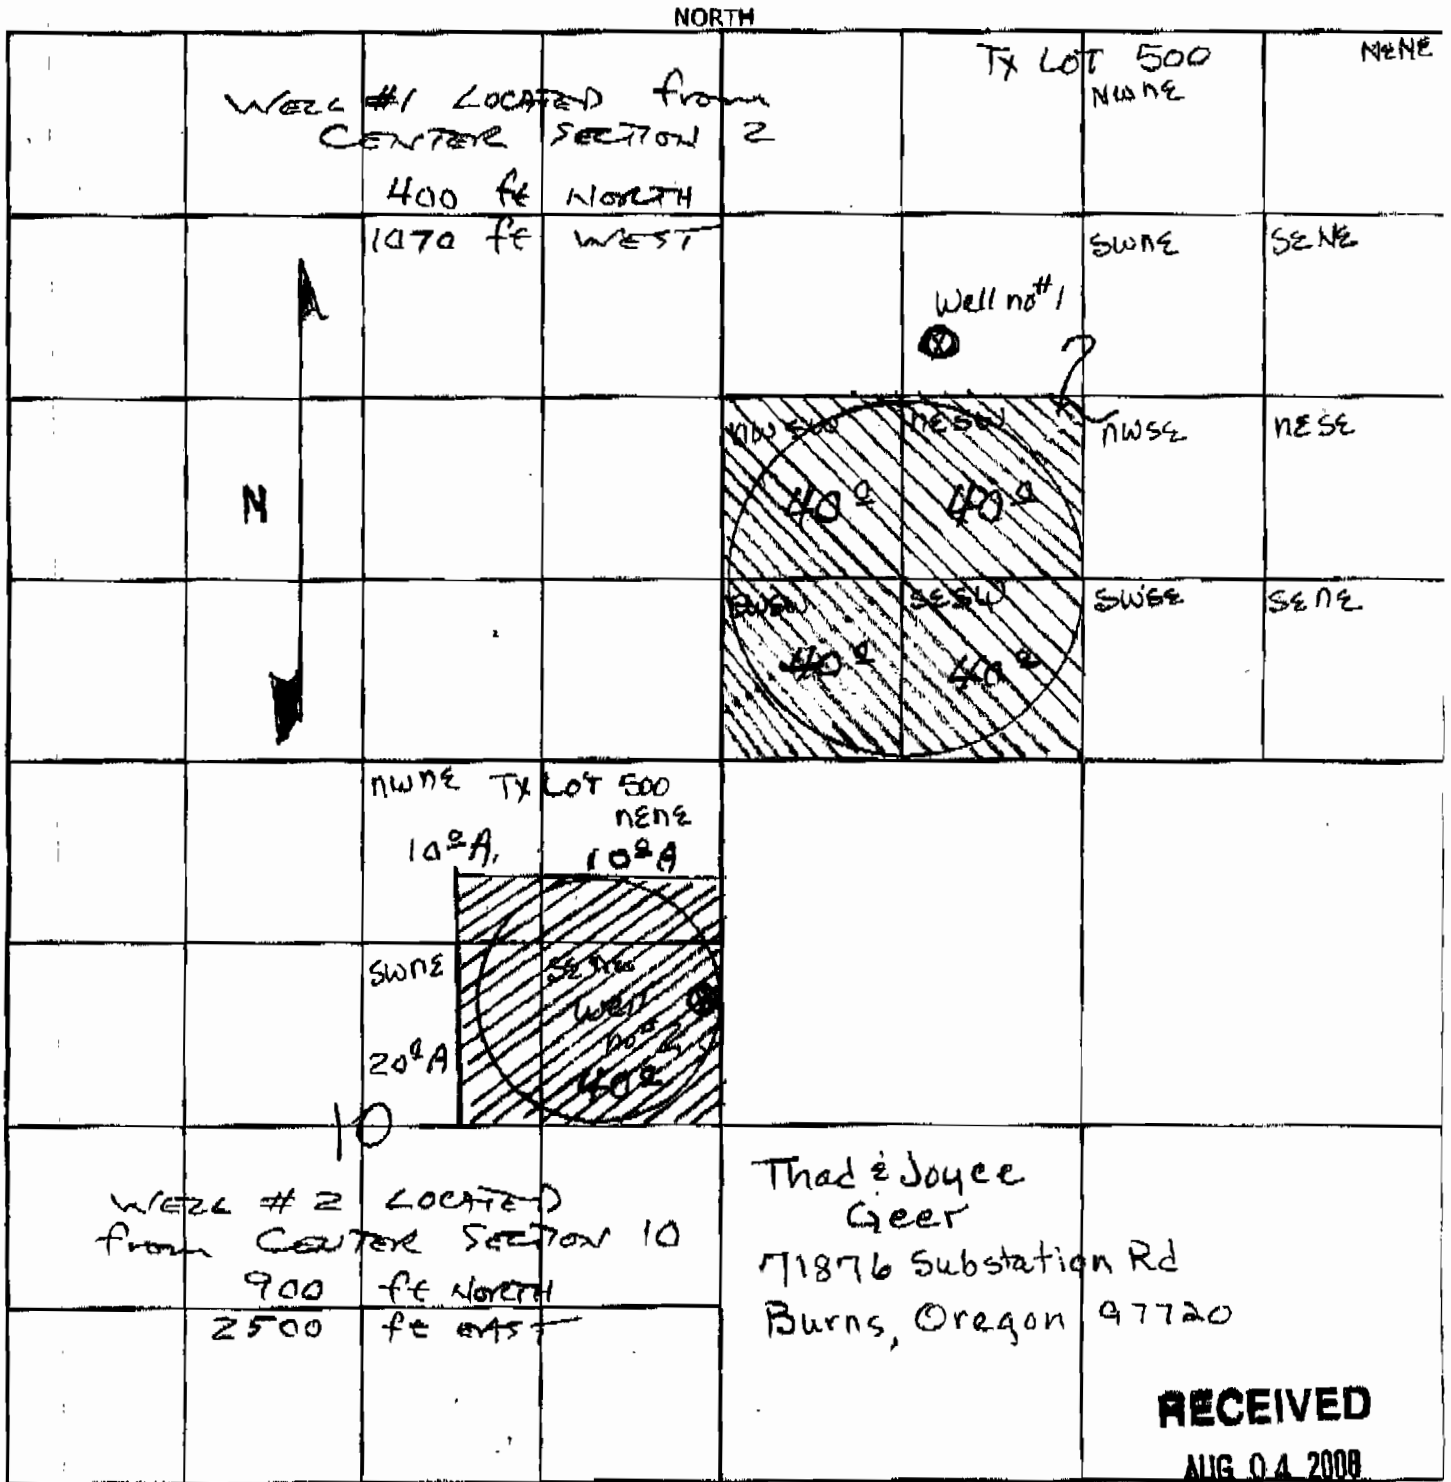

4"=1 mile

App No G17090