

SECTION PLAT

Section 34, 35


Township 23-S

Range 27-E

County of Harney

State of Oregon

NORTH

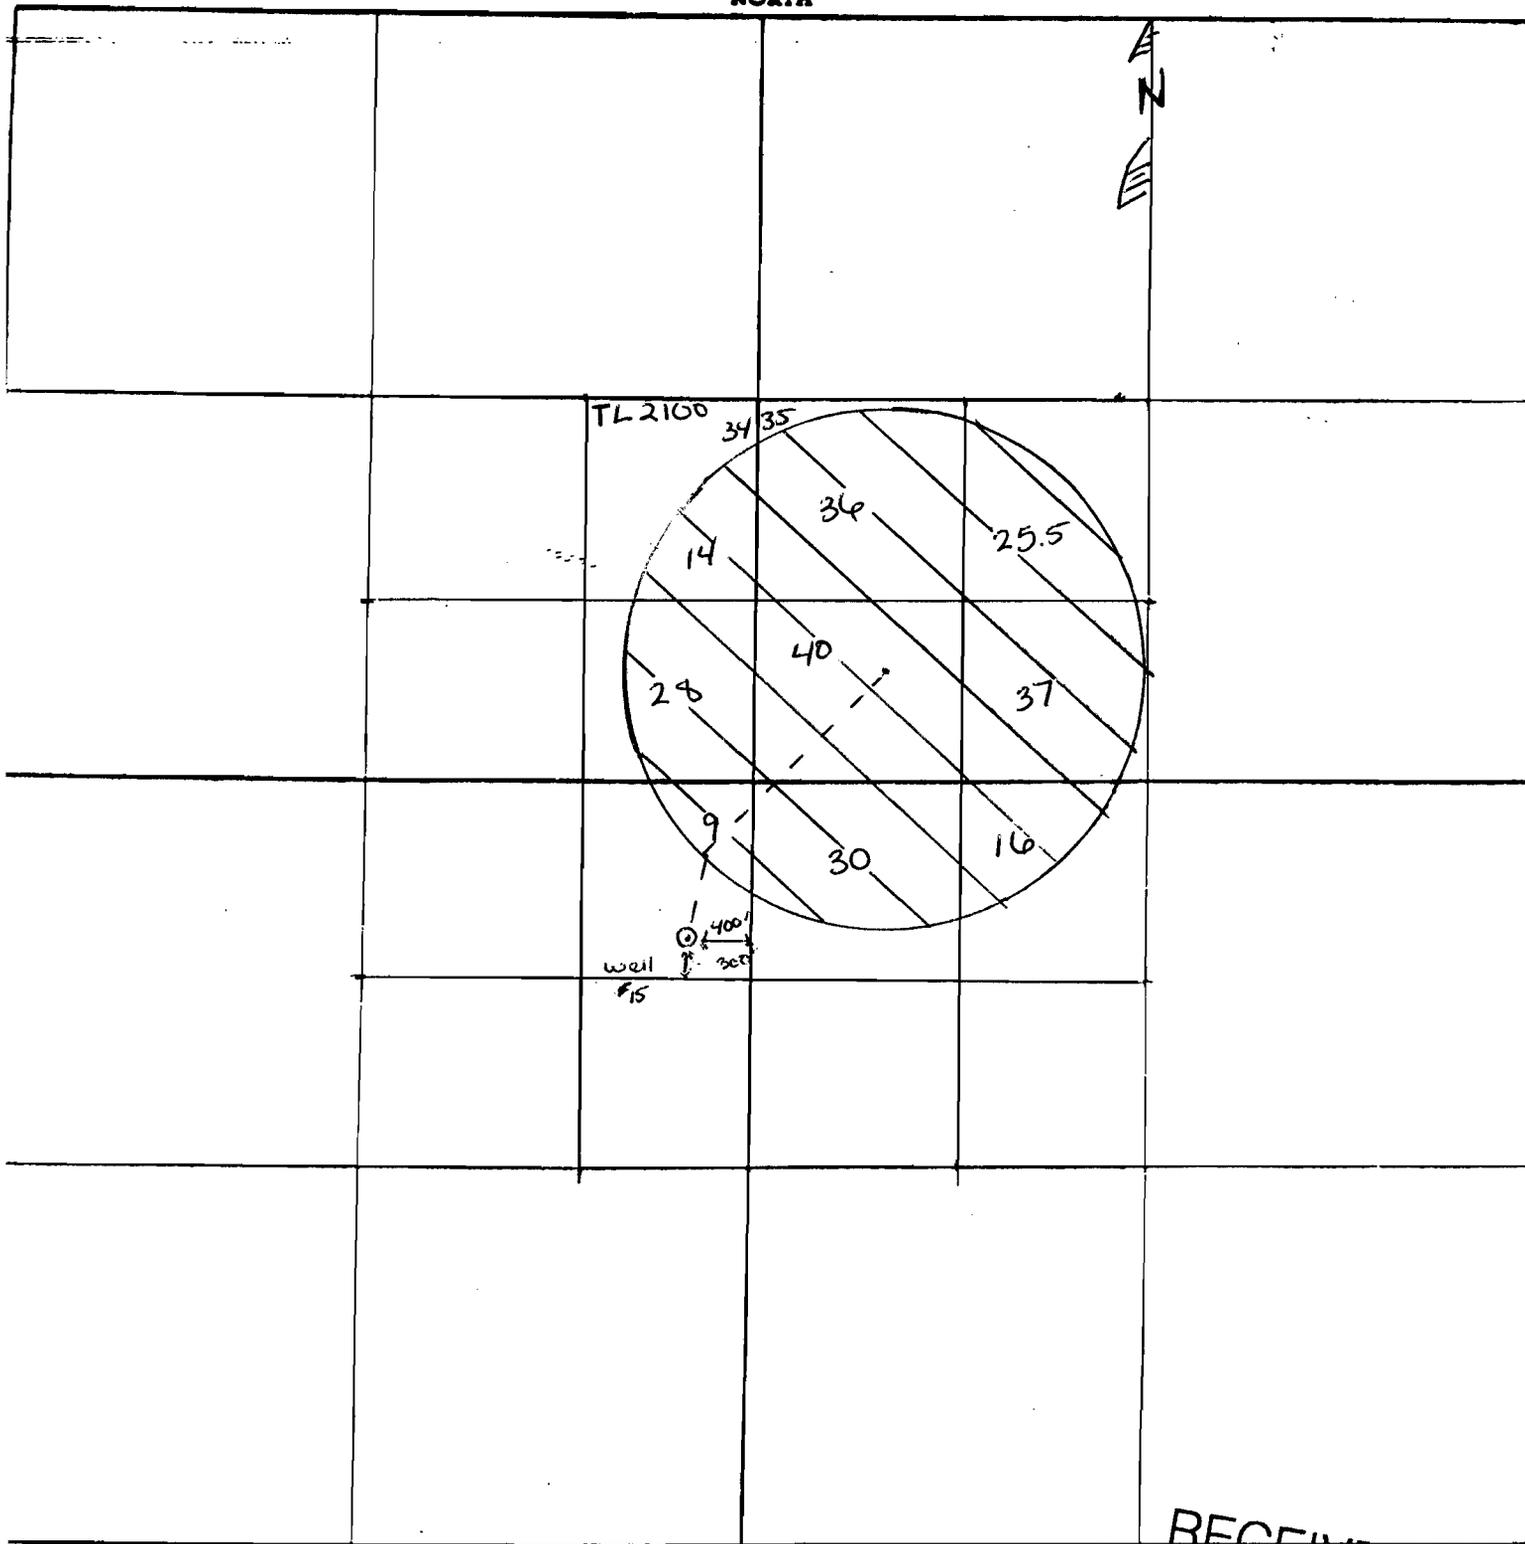

App No G-17086

RECEIVED
 JUL 21 2008
 WATER RESOURCES DEPT.
 SALEM, OREGON

WORK COPY SECTION PLAT

Section 12, 13


Township 24-S

Range 27-E

County of Harn. cy

State of Oregon

NORTH

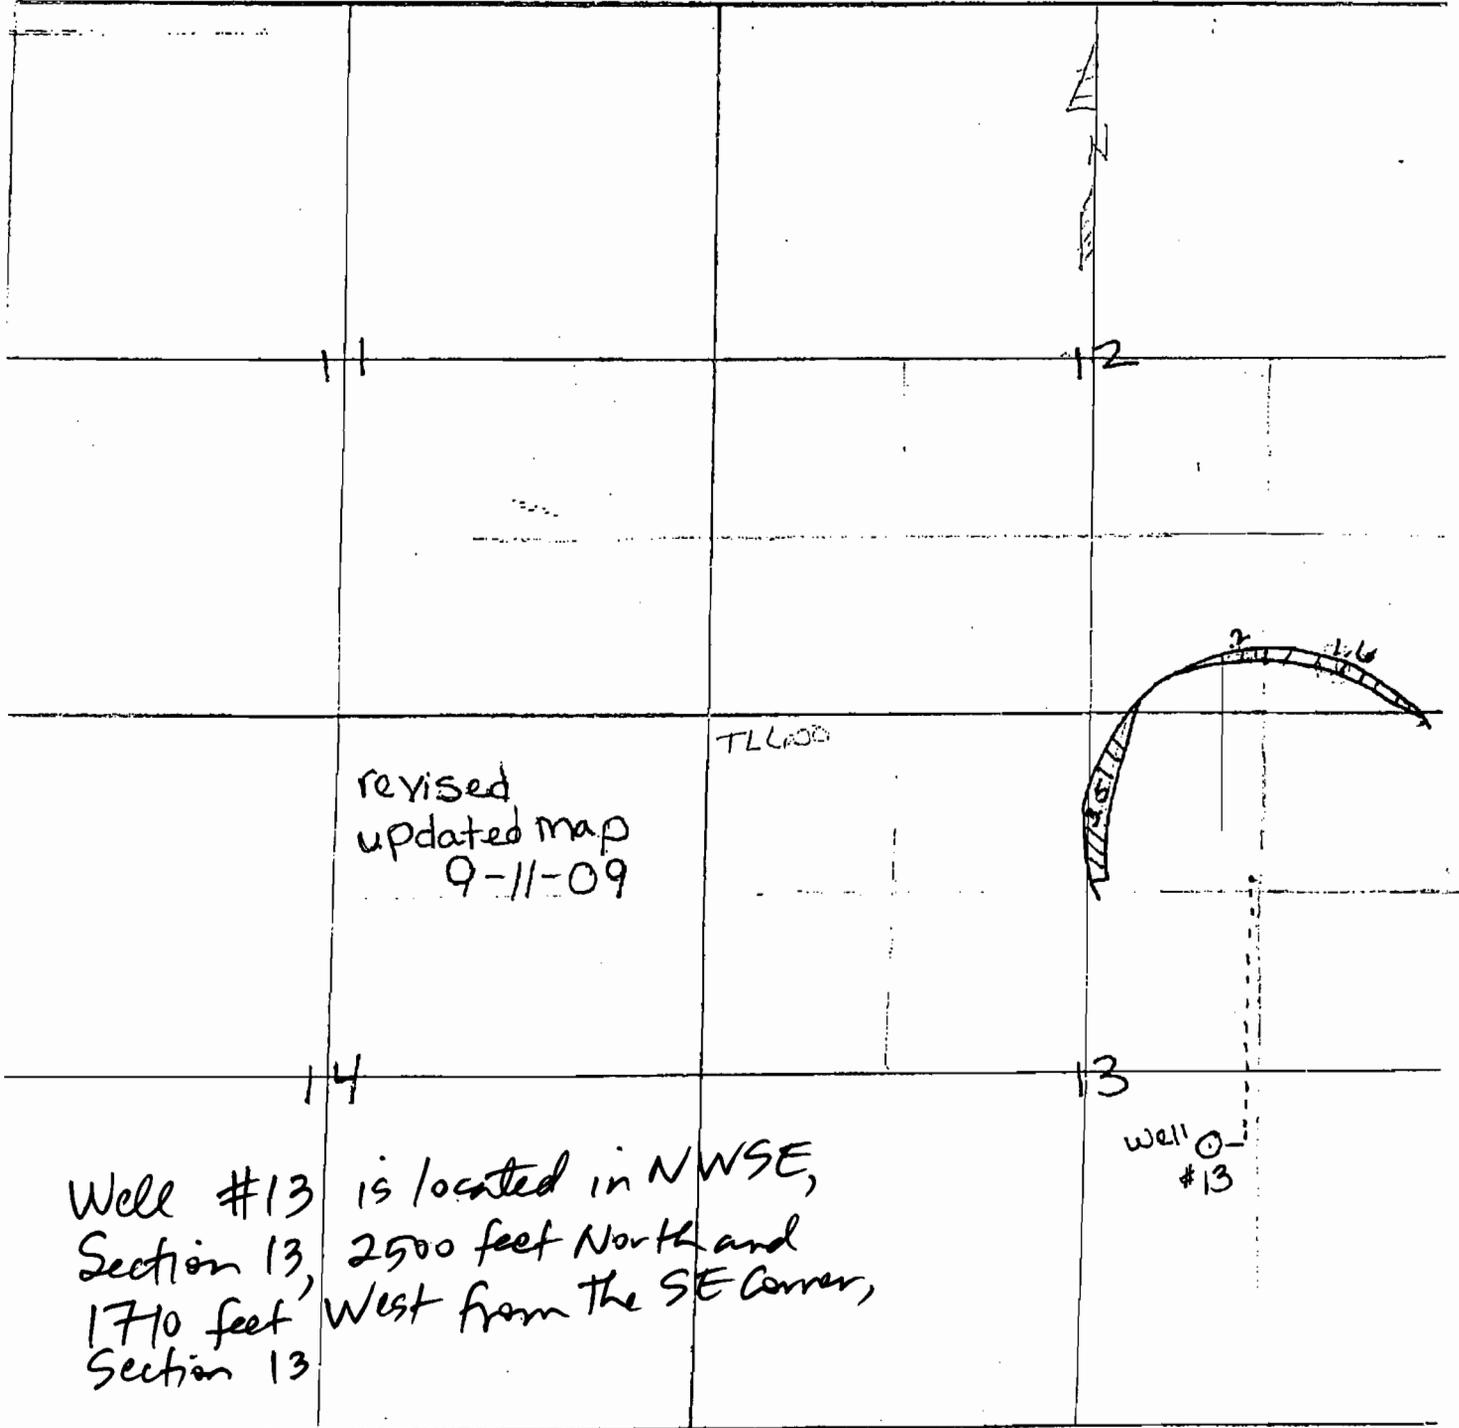

RECEIVED

SEP 14 2009

WATER RESOURCES DEPT
SALEM, OREGON

SECTION PLAT


Section 24

Township 24-S

Range 27-E

County of Harney State of Oregon

NORTH

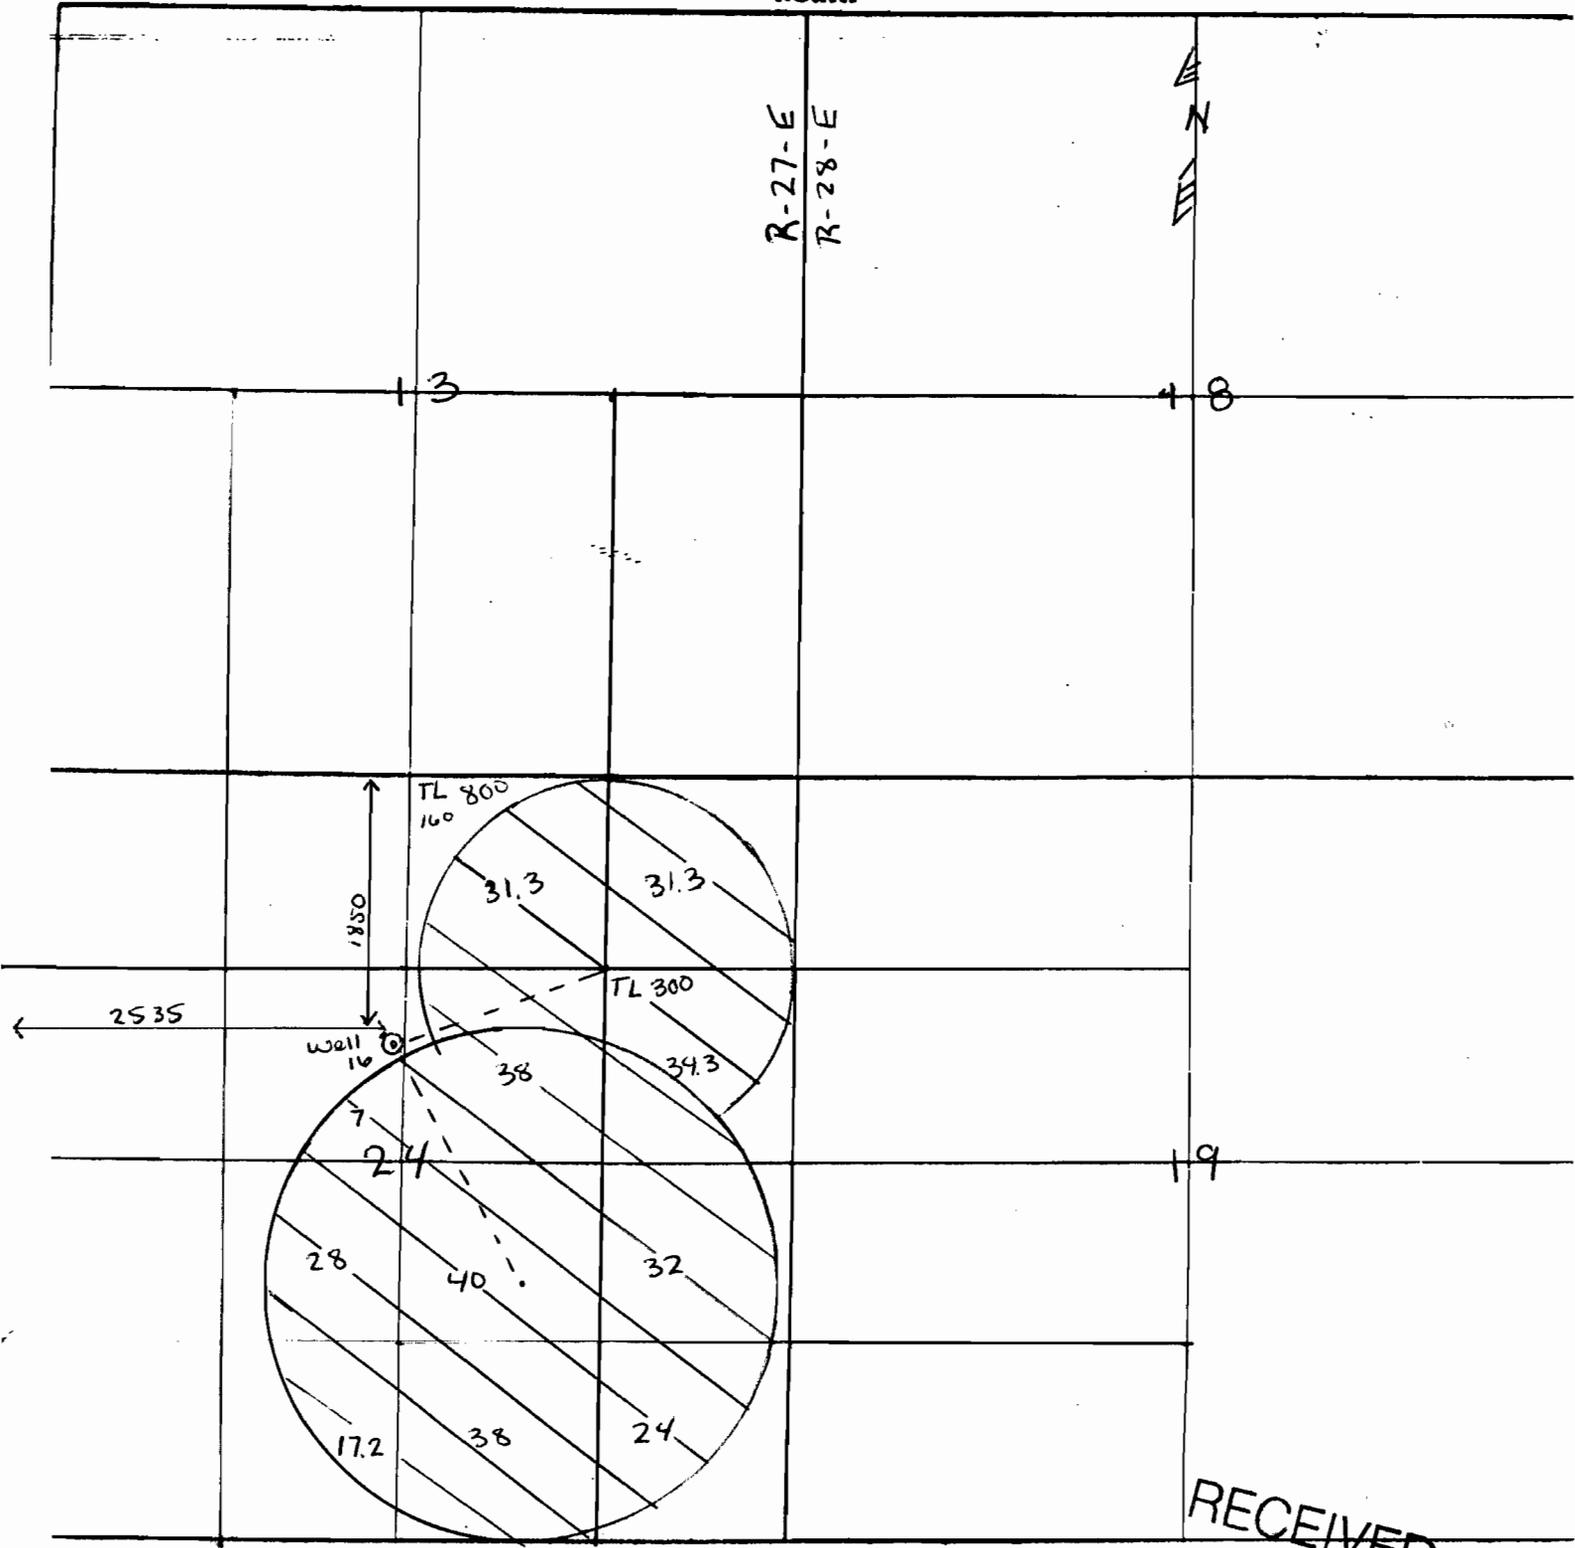

RECEIVED

JUL 21 2008
WATER RESOURCES DEPT.
SALEM, OREGON

App No G-11086