

SECTION 23 T.17S. R.11E. W.M.
DESCHUTES COUNTY

RECEIVED
APR 12 2002
WATER RESOURCES DEPT
SALEM, OR


1" = 400'

Deschutes River Basin



Subject Property:
TL 100
MAP 17 11 23
Deschutes County Oregon

17 11 23

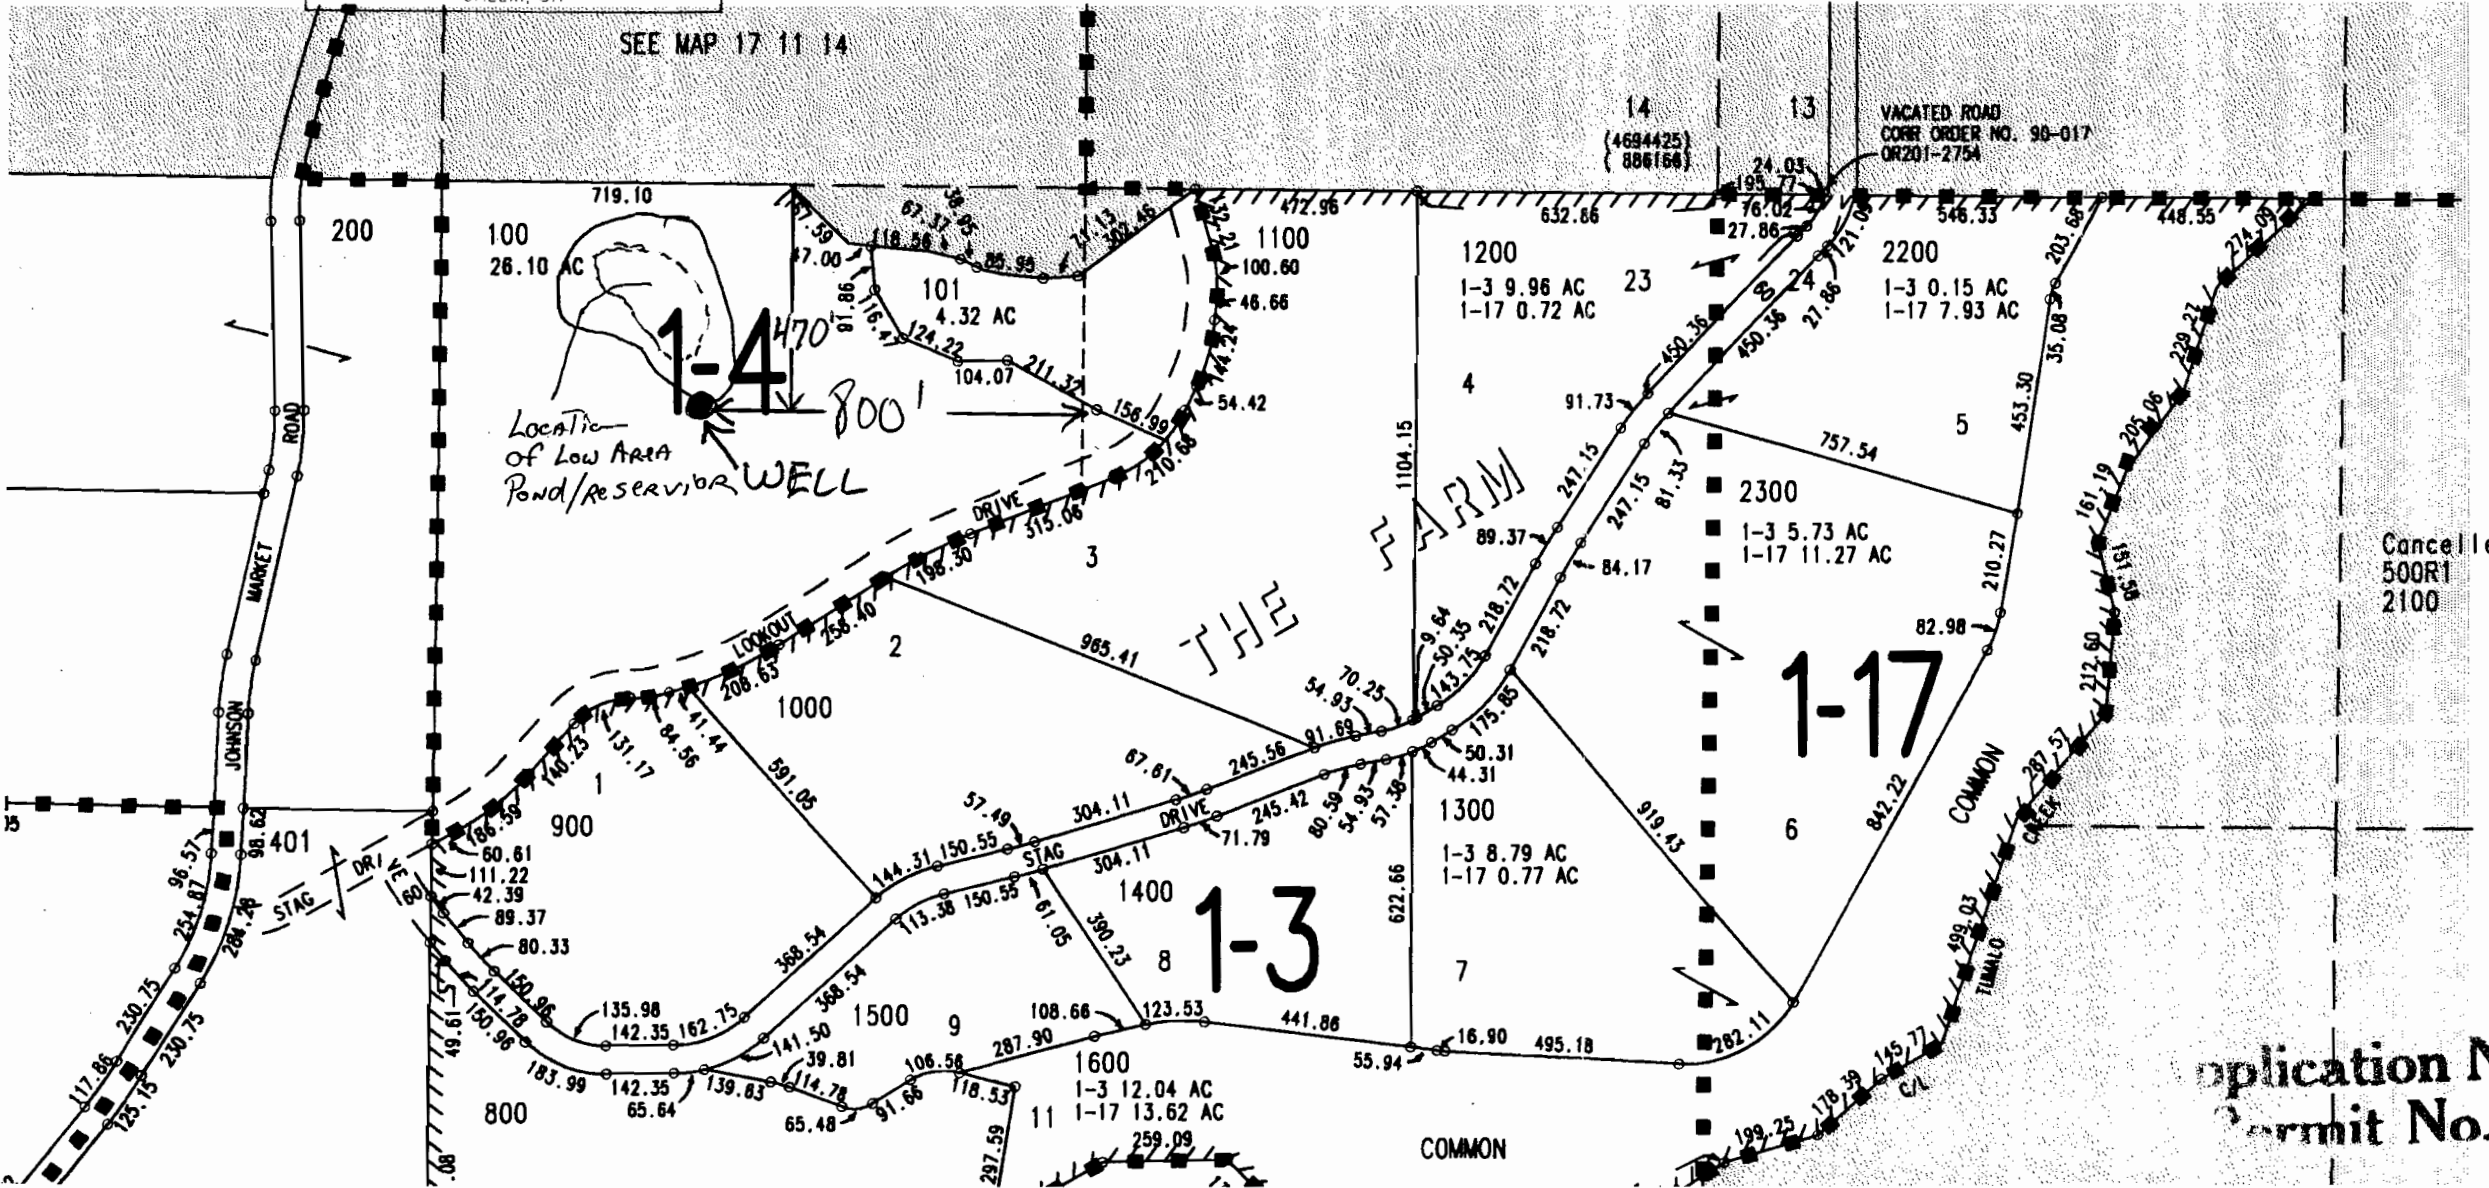

Cancelled No.s
500R1
2100

Application No. 15742
Permit No.