


APPLICATION G-16009

THIS MAP WAS PREPARED FOR
ASSESSMENT PURPOSE ONLY

SECTION 22 T.8S. R.40E. W.M.
BAKER COUNTY

1" = 400'

SEE MAP B 40 15

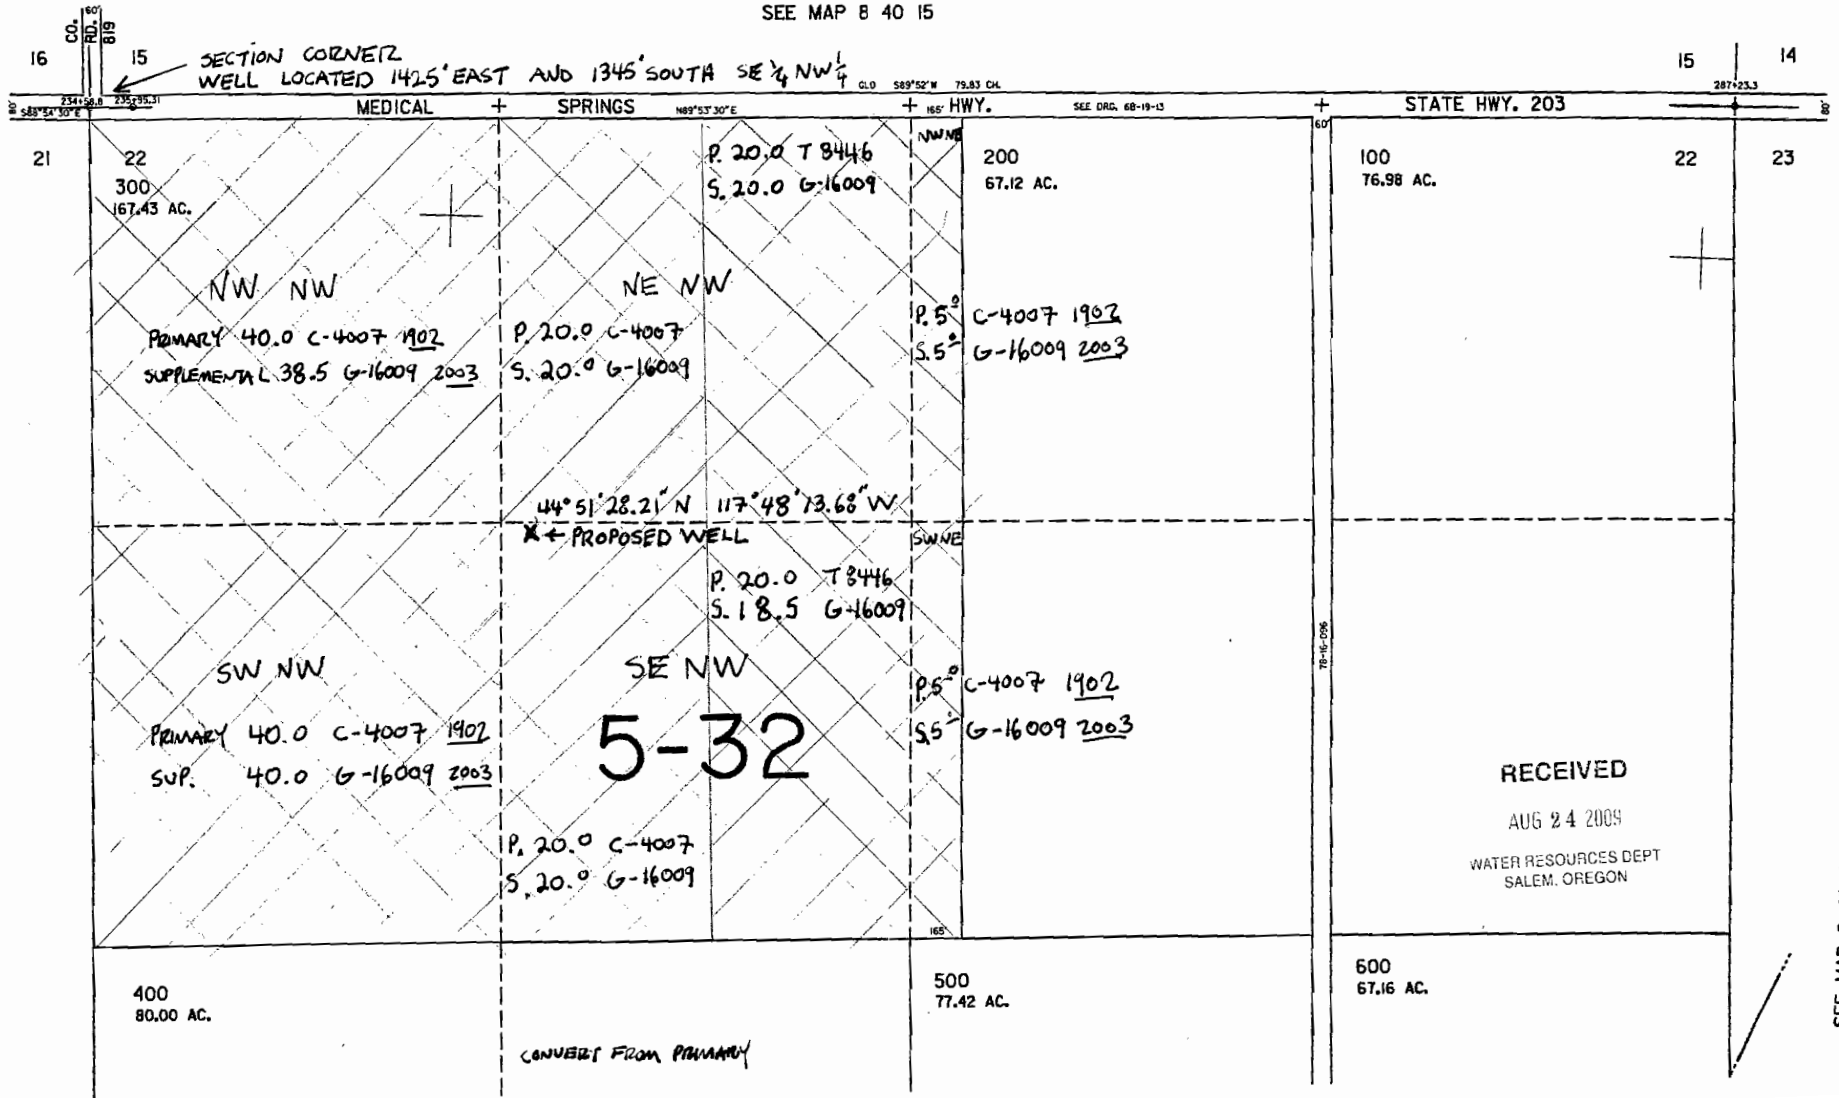

SEE MAP B 40 21

SEE MAP B 40 23