6-17151

LEGEND

LINE TYPES

TAX LOT BOUNDARY — OLD PROPERTY LINE

ROAD RIGHT-OF-WAY — VACATED RIGHT-OF-WAY

RAILROAD — RAILROAD RIGHT-OF-WAY

STREAM, LAKE, ETC. TAX LOT BOUNDARY — STREAM, LAKE, ETC. NON-BOUNDARY

SUBDIVISION BOUNDARY — PARTITION PLAT BDY.

TAX CODE BOUNDARY — EASEMENT

SYMBOL TYPES

D.L.C.

CONTROL POINTS

SURVEY MONUMENTS

G.L.O. CORNERS

SECTION — 1/4 SEC. — 1/16 SEC.

NUMBERS

TAX CODE NO.

000 00 00 0

ACREAGE - ALL ACREAGES EXCLUDE ANY PORTION THAT MAY LIE WITHIN THE INDICATED PUBLIC RIGHT OF WAYS.

TICK MARKS - WHEN A TICK MARK IS INDICATED ON THE EXTENSION OF A LINE, THEN THE DIMENSION GOES TO THE TICK MARK. GENERALLY THIS IS USED WHEN DIMENSIONS GO INTO PUBLIC RIGHT OF WAYS.

ARROWS ARE USED WITH DIMENSIONS IN AREAS OF GREATER COMPLEXITY.

NOTICE: This map was created for Assessor's Office use ONLY.
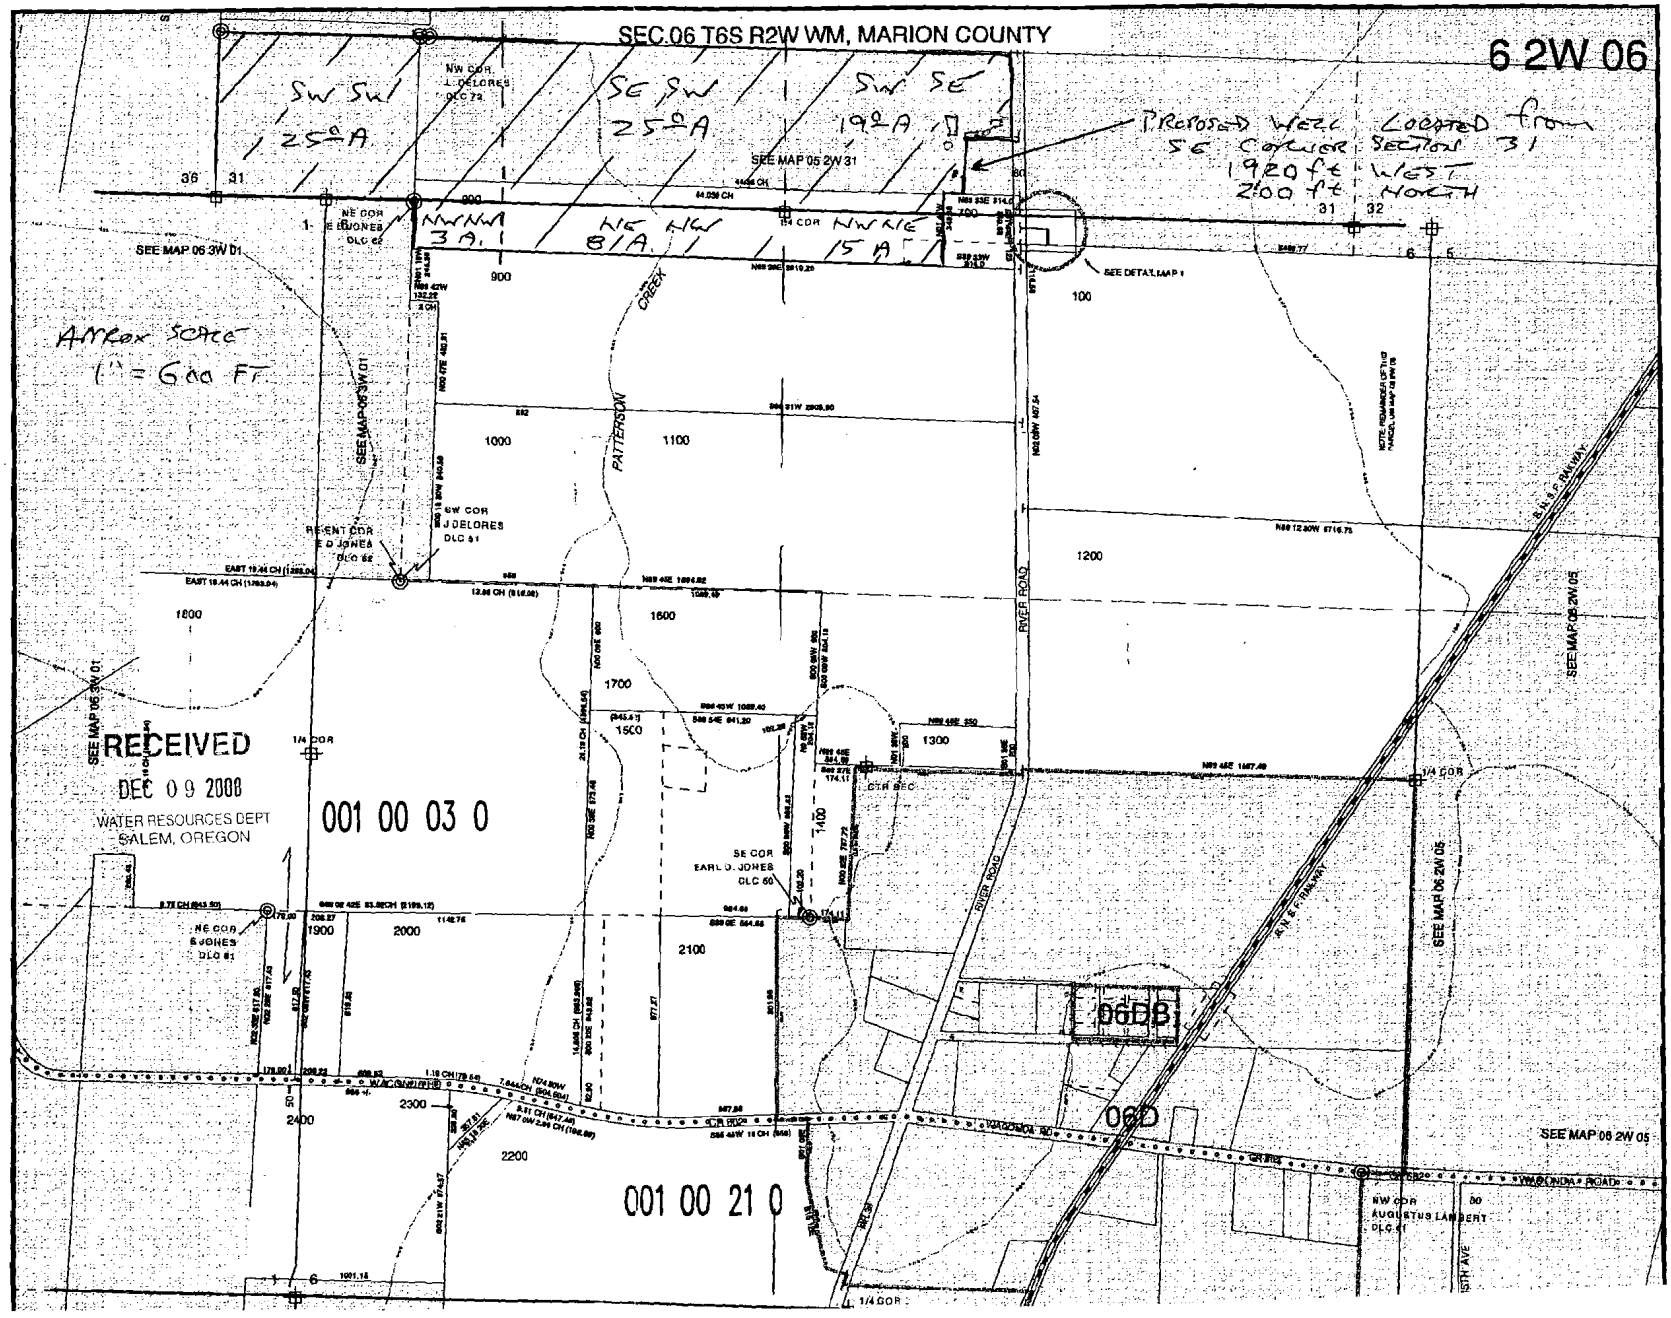
Assessor "We Care" GIS