

MAR 29 2000

Application No. G-15113 SECTION 19 T.16S. R.12E.W.M.  
Permit No. DESCHUTES COUNTY

1"=400'

Note


- 1. Irrigation Distribution
    - a. SW 1/4 of NE 1/4 - 2 acres
    - b. NW 1/4 of NE 1/4 - 0.75 acre
    - c. SE 1/4 of NE 1/4 - 0.75 acre
- 3.5 acres total

Legend

- 1. quarter-quarter boundaries are shown in
- 2. Happy Acres Water Co. boundaries shown in
- 3. Location existing houses are shown as
- 4. Each represents 1/4 acre of irrigation
- 5. Point of Diversion (Well)

WATER RESOURCES DEPT.  
SALEM, OREGON

See Map 16 12 18

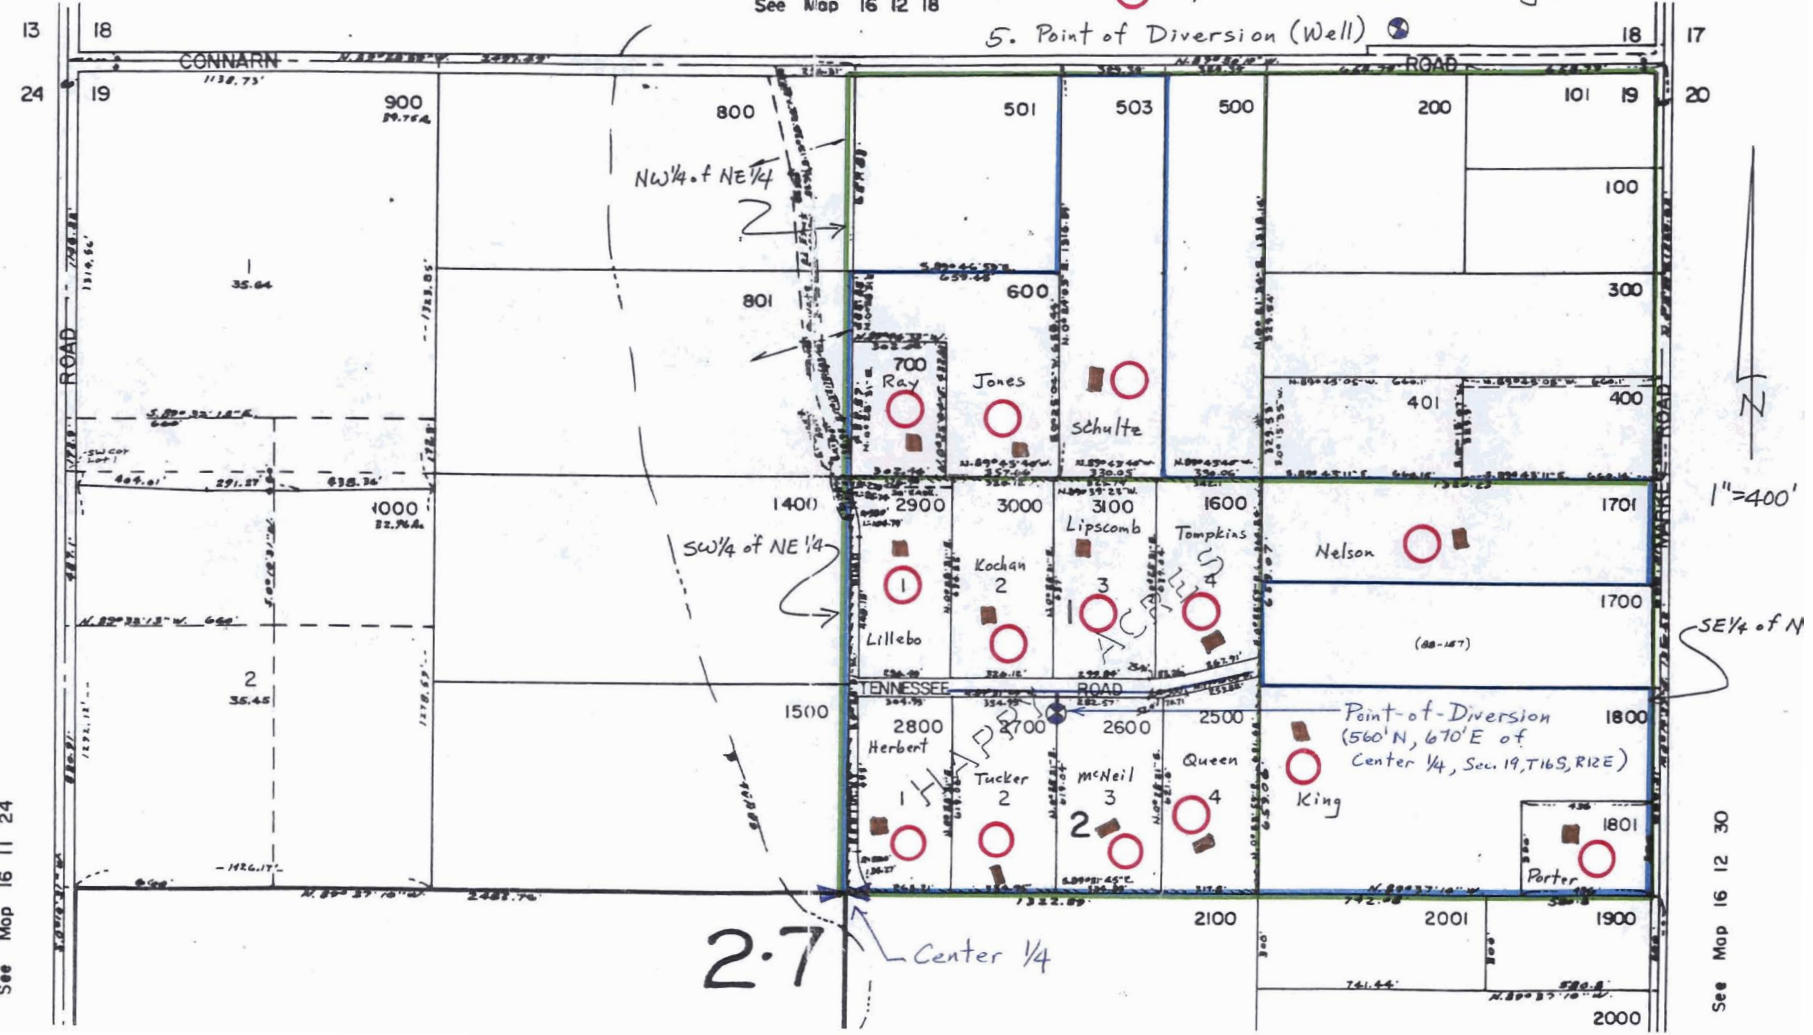

See Map 16 11 24

See Map 16 12 30

pp No G-15113  
r mit No G-16617