


SECTION PLAT

Section 5 Township 25-S Range 33-E

County of Harney State of Oregon

NORTH

G-17168

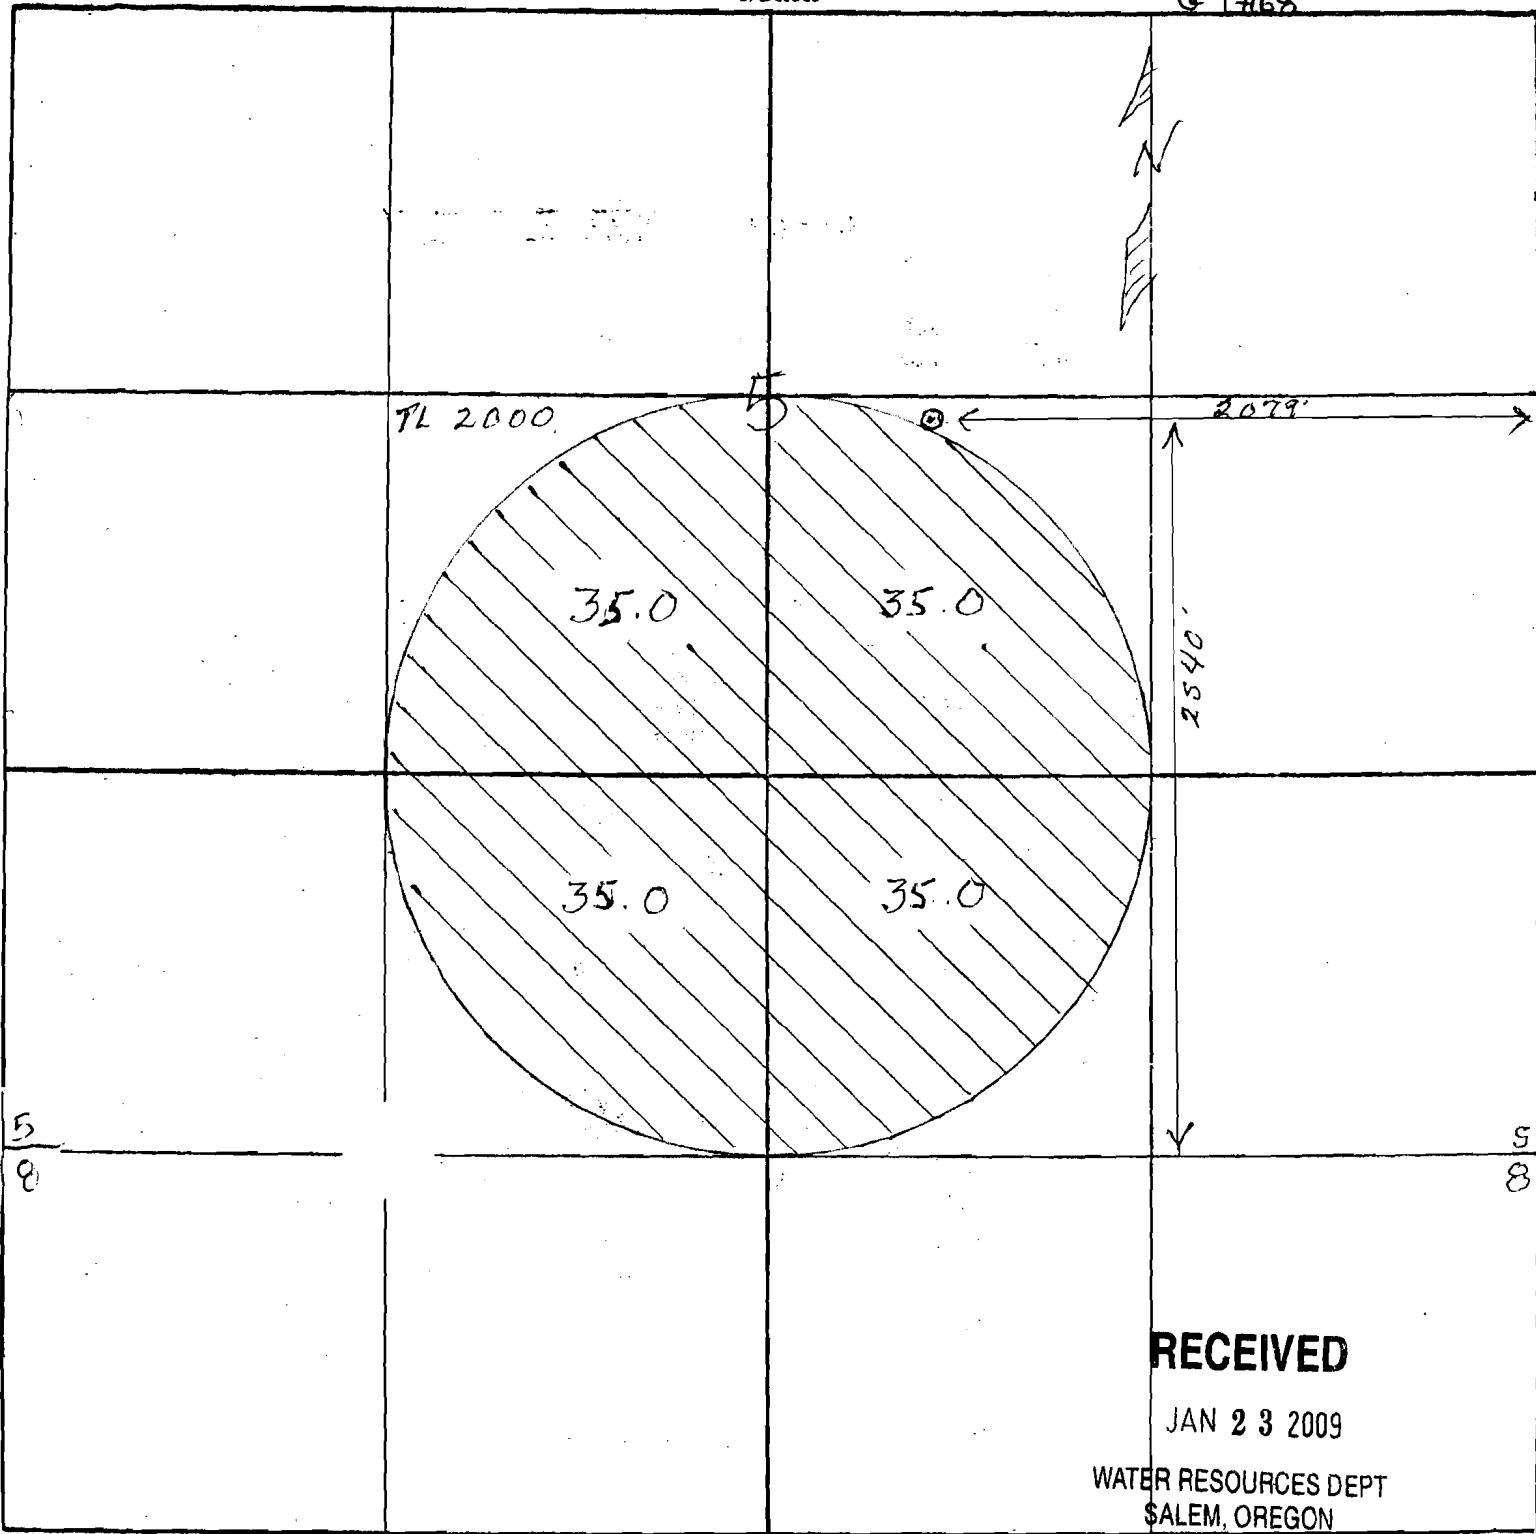

RECEIVED

JAN 23 2009

WATER RESOURCES DEPT
SALEM, OREGON

Remarks scale - 8" = 1 mile - 660' -