

MAP A

WORKS COPY

SEC.25 T6S R2W WM, MARION COUNTY

6 2W 25

- LEGEND**
- LINE TYPES**

- NUMBERS**
- TAX CODE NO.
000 00 00 0


ACCREASION - ALL ACCREASION EXCLUDES ANY PORTION THAT MAY LIE WITHIN THE UNDEVELOPED PUBLIC RIGHT OF WAY.

TICK MARKS - WHEN A TICK MARK IS DEMONSTRATED BY THE EXTENSION OF A LINE FROM THE INTERSECTION CORNER TO THE TICK MARK, GENERALLY THIS IS USED WHEN DIMENSIONS DO NOT FULFILL RIGHT OF WAY.

ARROWS ARE USED WITH DIMENSIONS IN AREAS OF GREATER COMPLEXITY.


NOTICE: This map was created for Assessor's Office use ONLY.

G-16739

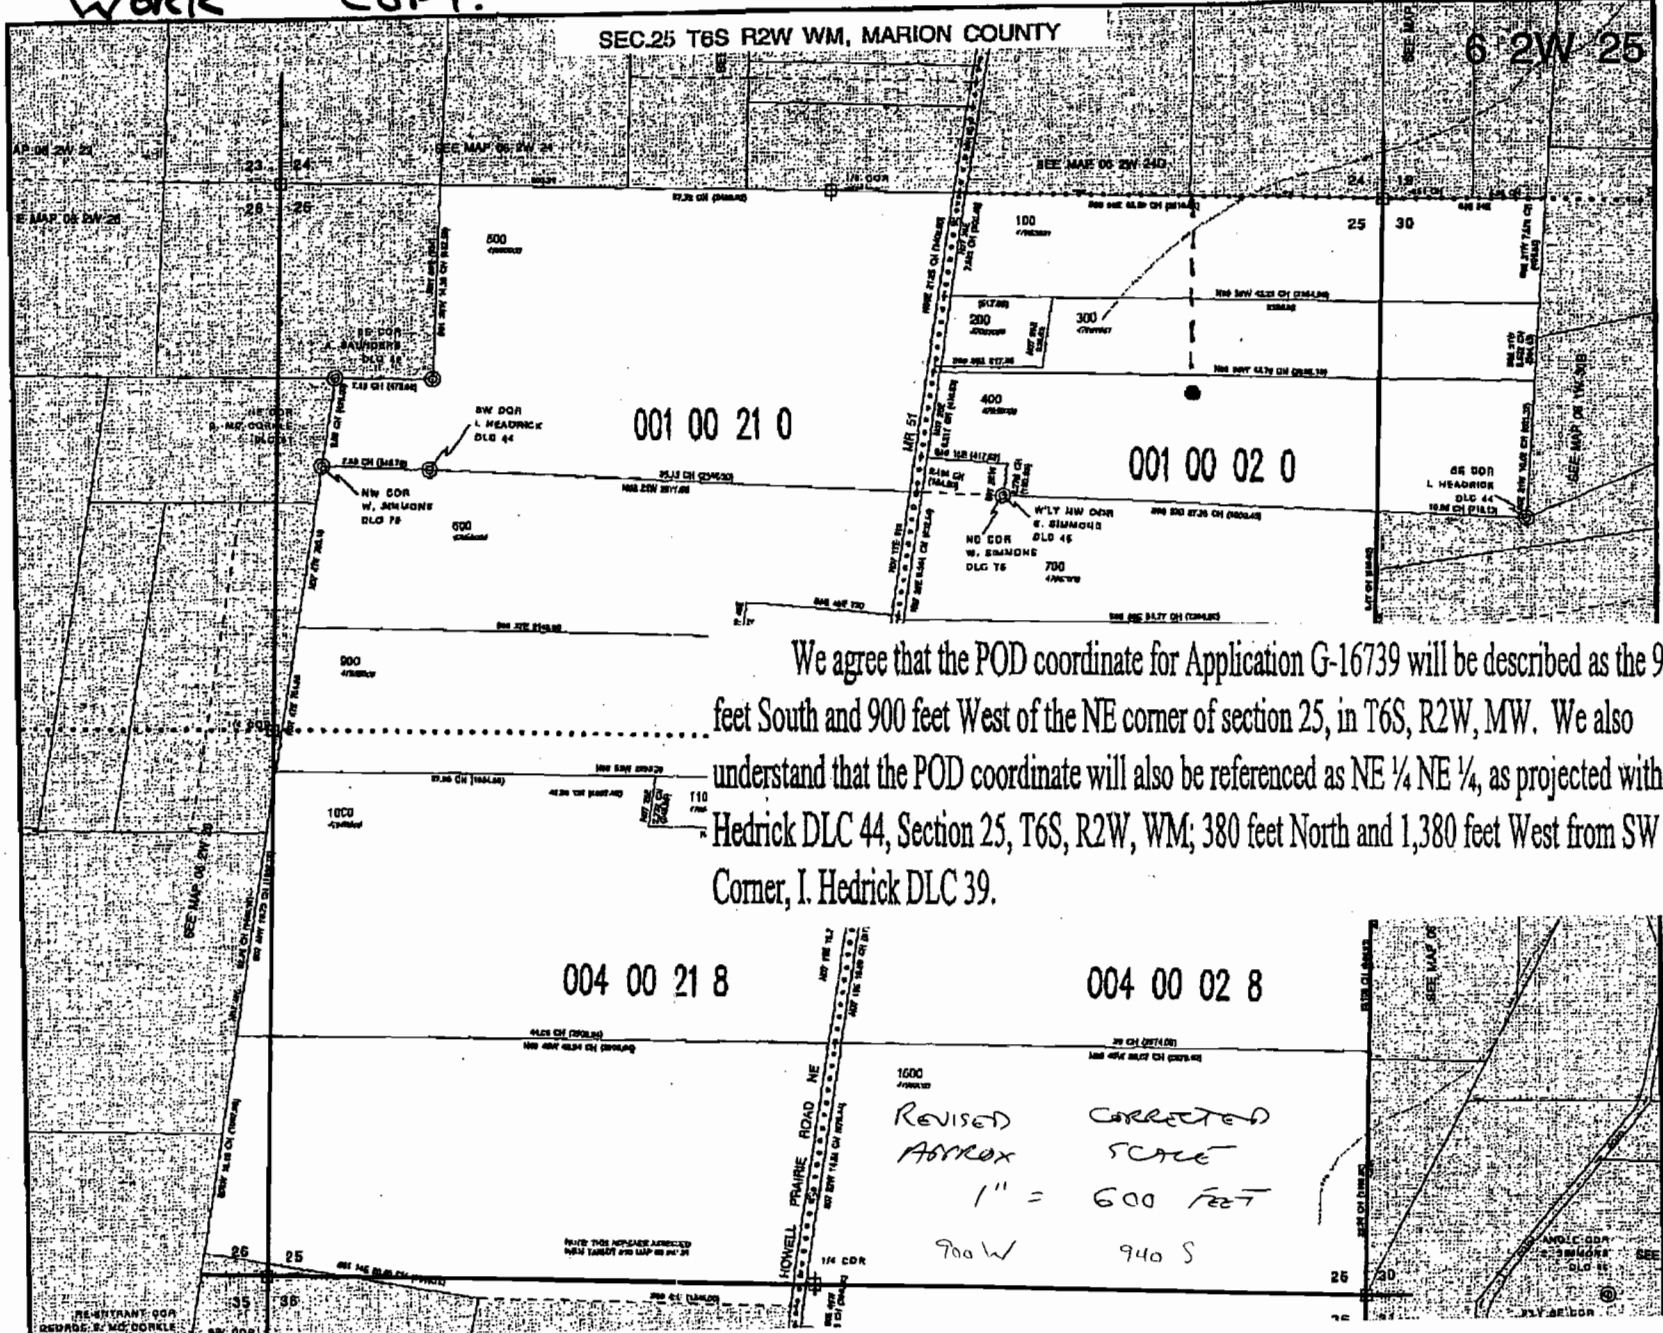

We agree that the POD coordinate for Application G-16739 will be described as the 940 feet South and 900 feet West of the NE corner of section 25, in T6S, R2W, MW. We also understand that the POD coordinate will also be referenced as NE 1/4 NE 1/4, as projected within I. Hedrick DLC 44, Section 25, T6S, R2W, WM; 380 feet North and 1,380 feet West from SW Corner, I. Hedrick DLC 39.

REVISED APPROX SCALE
CORRECTED SCALE
1" = 600 FEET
900 W
940 S

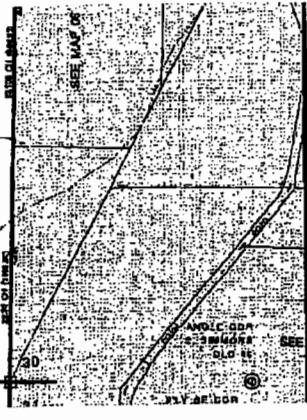

MAP B

LEGEND

LINE TYPES

- TAX LOT BOUNDARY OLD PROPERTY LINE
- ROAD RIGHT-OF-WAY VACATED RIGHT-OF-WAY
- RAILROAD RAILROAD RIGHT-OF-WAY
- STREAM, LAKE, ETC. STREAM, LAKE, ETC.
- TAX LOT BOUNDARY NON-BOUNDARY
- SUBVISION BOUNDARY PARTITION PLAT BKT.
- TAX CODE BOUNDARY KARENWAY

WORK
SYMBOL TYPES
D.L.C. **COPY**
CONTROL POINTS
SURVEY MONUMENTS
G.L.O. CORNERS

- SECTION 1/4 SEC 1/4 IN SEC
- SECTION
 - 1/4 SEC
 - 1/4 IN SEC

NUMBERS
TAX CODE NO.
000 00 00 0

ACREAGE - ALL ACREAGES EXCLUDE ANY PORTION THAT MAY LIE WITHIN THE INDICATED PUBLIC RIGHT OF WAY.

TICK MARKS - WHEN A TICK MARK IS INDICATED ON THE EXTENSION OF A LINE, THEN THE DIMENSION GOES TO THE TICK MARK. GENERALLY THIS IS USED WHEN DIMENSIONS GO INTO PUBLIC RIGHT OF WAYS.




ARROWS ARE USED WITH DIMENSIONS IN AREAS OF GREATER COMPLEXITY.

NOTICE: This map was created for Assessor's Office use ONLY.



SE1/4 SEC.24 T6S R2W WM, MARION COUNTY

6 2W 24D

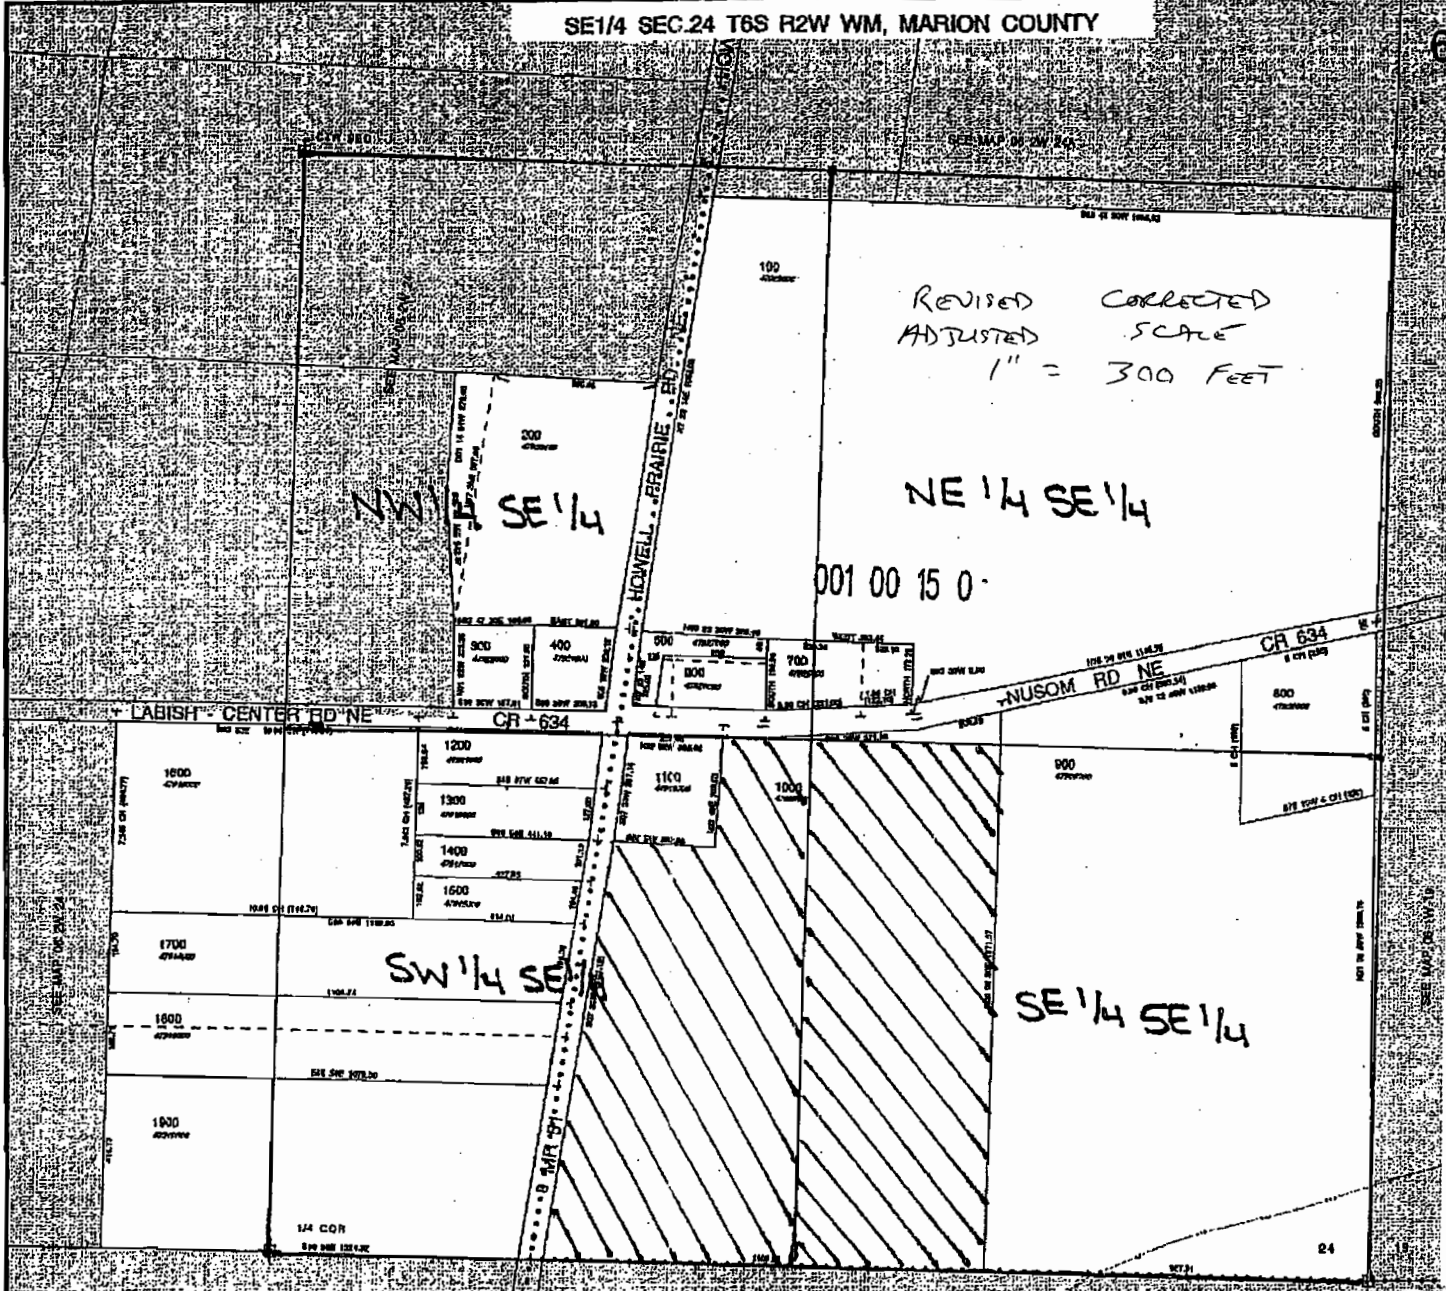

Number of acres per 1/4 1/4, if irrigation, nursery, or agriculture: 11.89 acres in the SE 1/4 SE 1/4 and 16.05 acres in the SW 1/4 SE 1/4 all in Section 24, Township 6S, Range 2W.