


Reduced Scale
copy

THIS MAP WAS PREPARED FOR
ASSESSMENT PURPOSE ONLY

SECTION 23 T.2N. R.10E. W.M.
HOOD RIVER COUNTY
1"=400'

2N 10 23

CANCELLED NO.
900
1200
1802
2000
3701
4000
4100

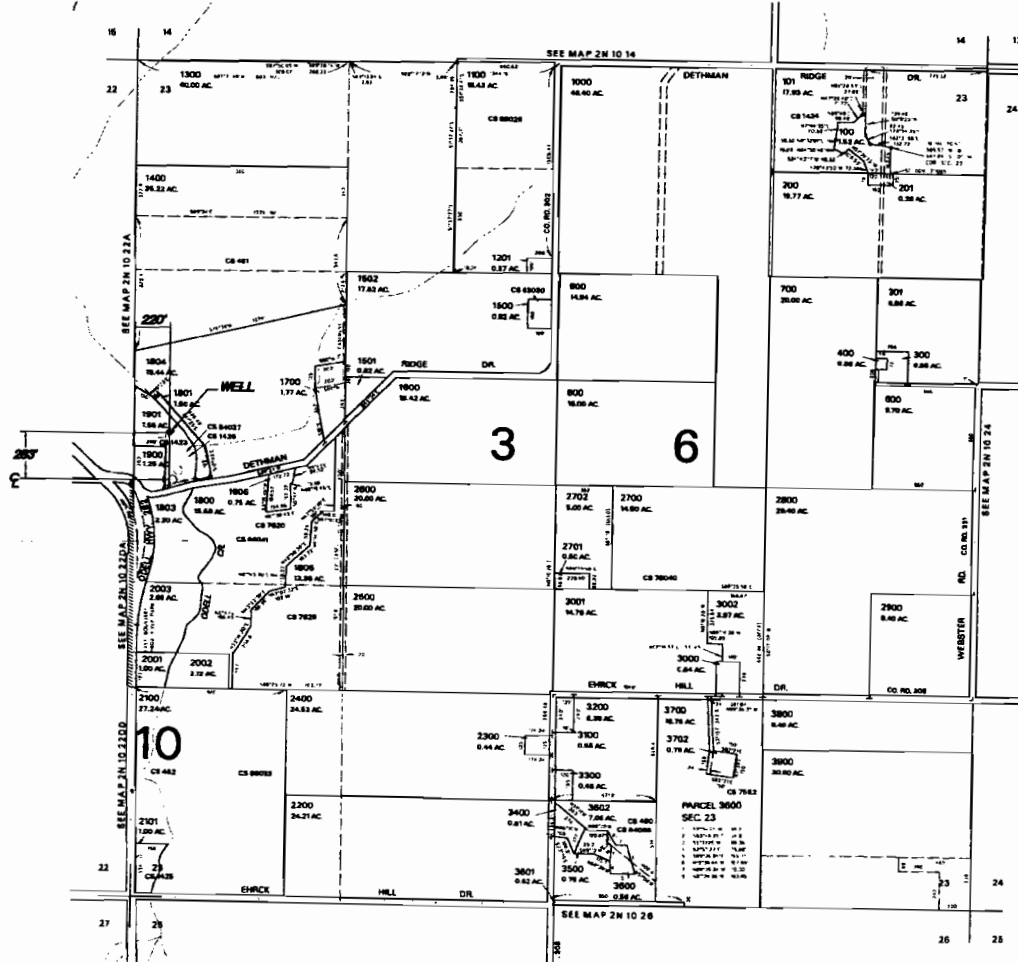

NOTE
THIS MAP IS NOT INTENDED TO
PROVIDE LEGAL DIMENSIONS OR
LOCATIONS OF PROPERTY
OWNERSHIP LINES.

REVISED: JD
11/8/02
2N 10 23



WELL LOCATION MAP
SCALE: 1" = 400'

WATERBURY CONSULTANTS
SPECIAL GROUP

Append G-16A9AS

BAR IS ONE INCH ON ORIGINAL DRAWING. ADJUST SCALE AS SHOWN ACCORDINGLY.

NO.	DESCRIPTION	DATE

REVISIONS

CURRAN-MCLEOD, INC.
CONSULTING ENGINEERS
6655 SW HAMPTON ST., SUITE 210
PORTLAND, OREGON 97223
PHONE (503) 684-3478

ODELL SANITARY DISTRICT
WELL LOCATION MAP
WASTEWATER TREATMENT FACILITY IMPROVEMENTS
HOOD RIVER COUNTY, OREGON

JULY 2007
1436
1
OF
1