


N WASHINGTON County  
15218CC SW 1/4 SW 1/4  
SCALE 1" = 100'  
TAX LOT 200

58-5

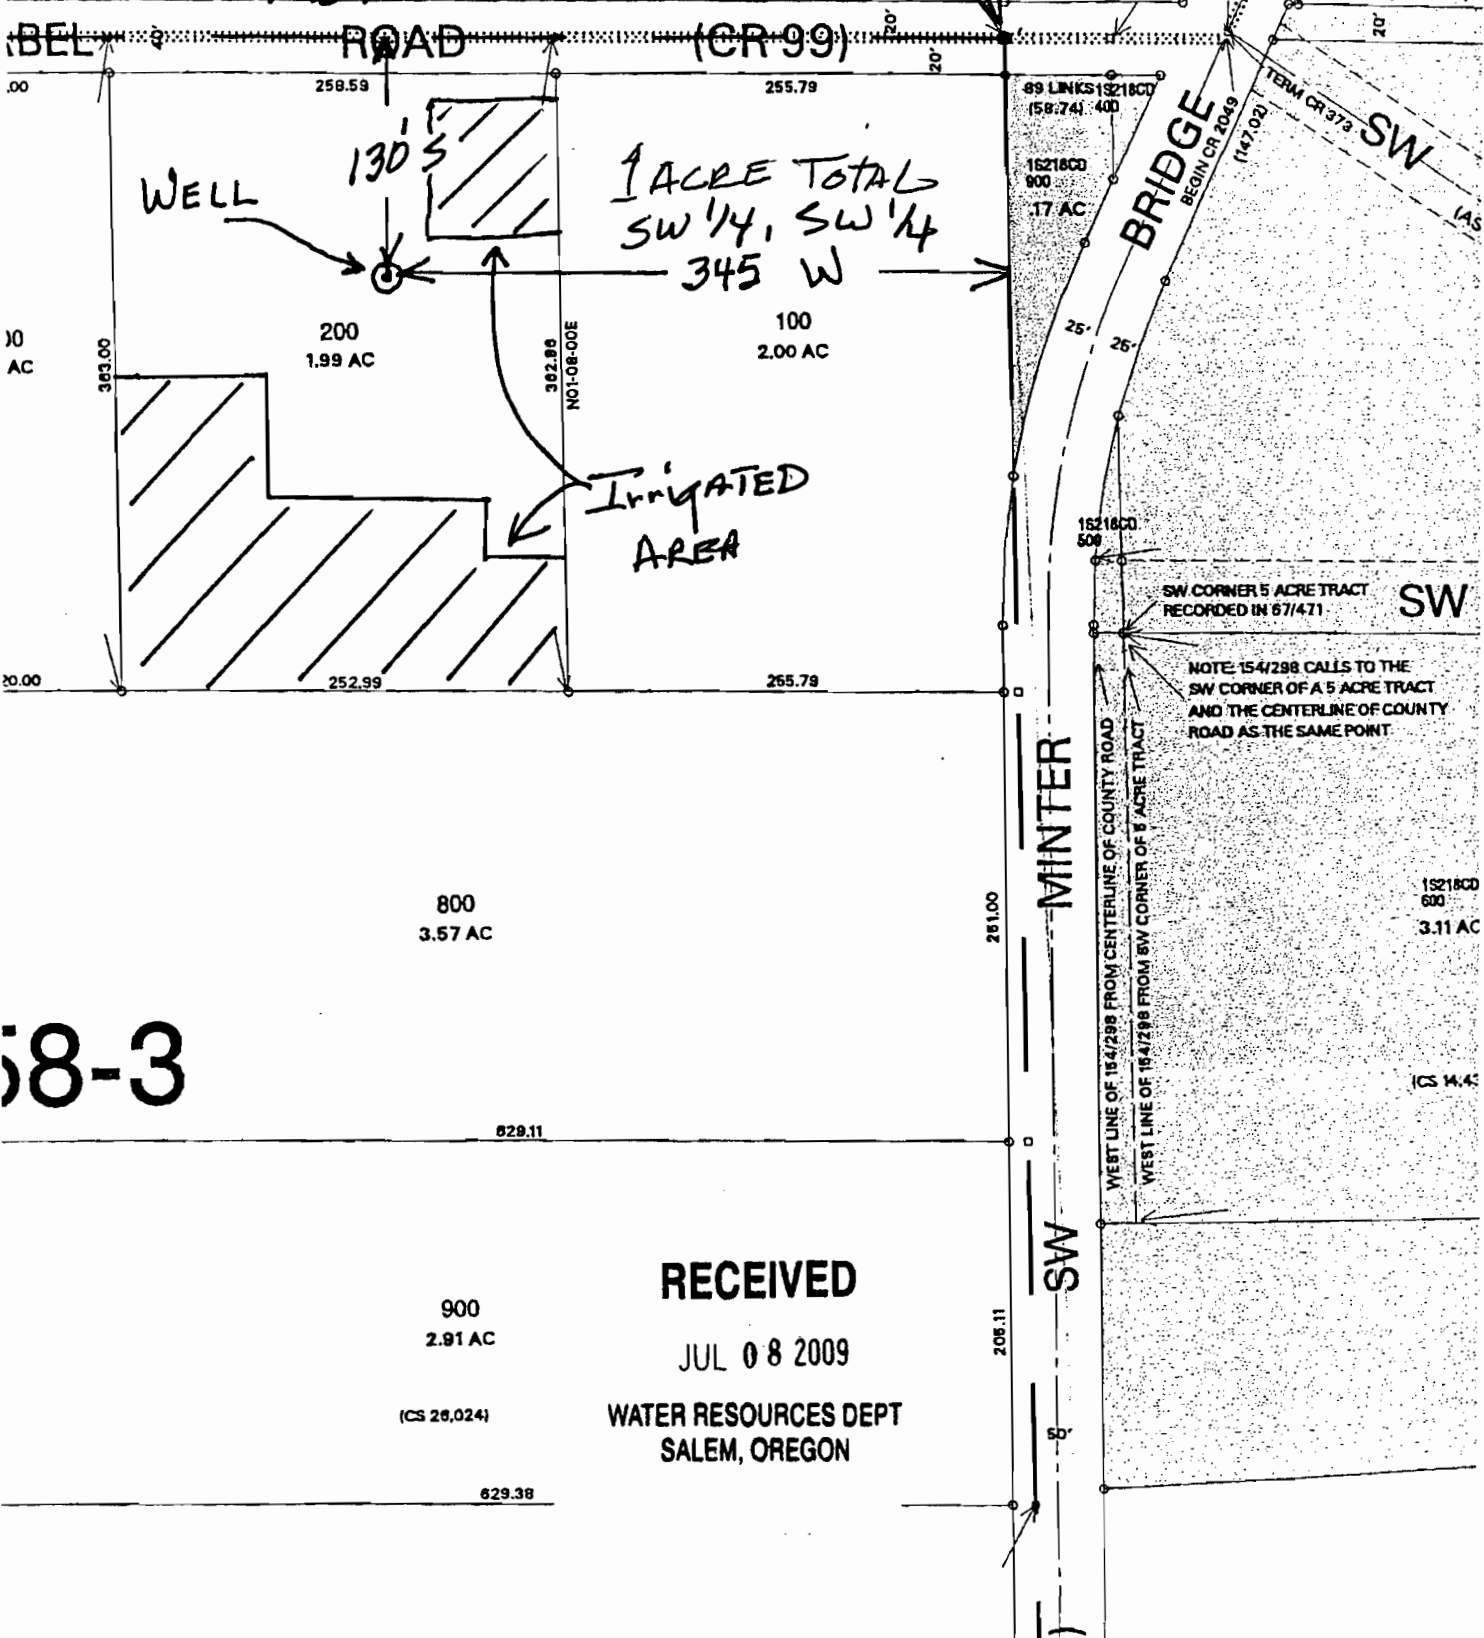

58-3


RECEIVED

JUL 08 2009

WATER RESOURCES DEPT  
SALEM, OREGON

SECTION 18 T1S R2W W.M.  
WASHINGTON COUNTY OREGON  
SCALE 1"=400'

CANCELLED THE LOTS  
181, 182, 183,1000

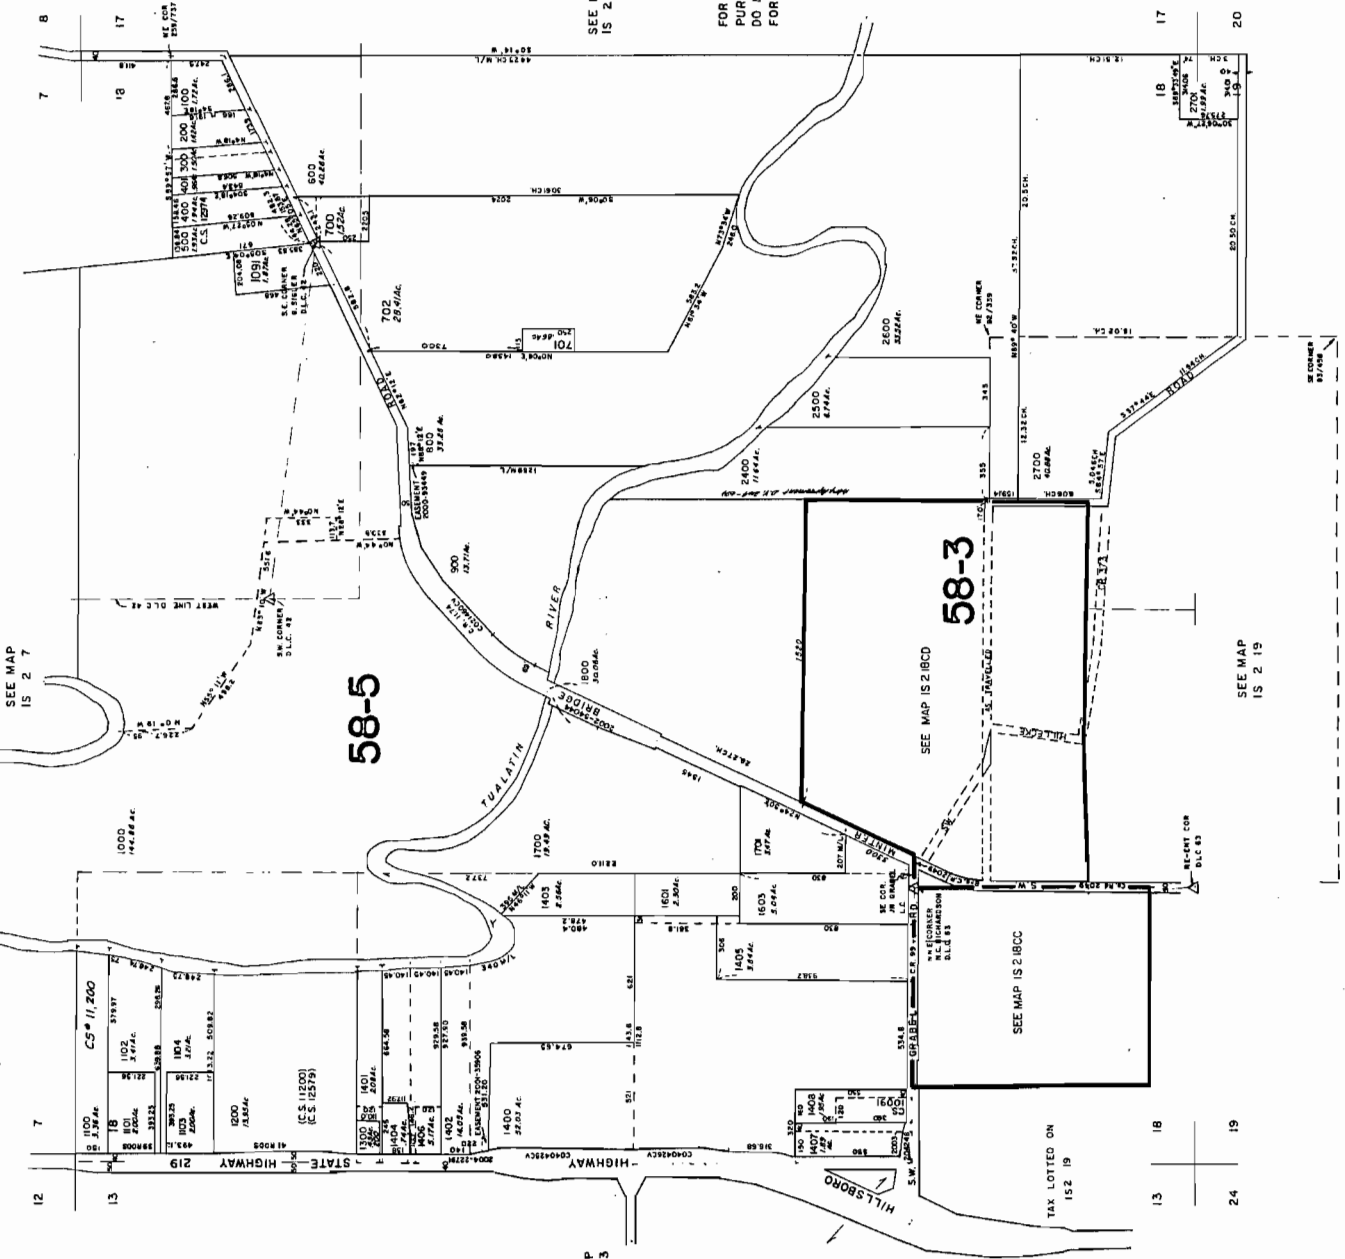


SEE MAP IS 2 7

SEE MAP IS 2 1

FOR ASSESSMENT PURPOSES ONLY DO NOT RELY ON FOR ANY OTHER USE

SEE MAP IS 3 13

SEE MAP IS 2 19

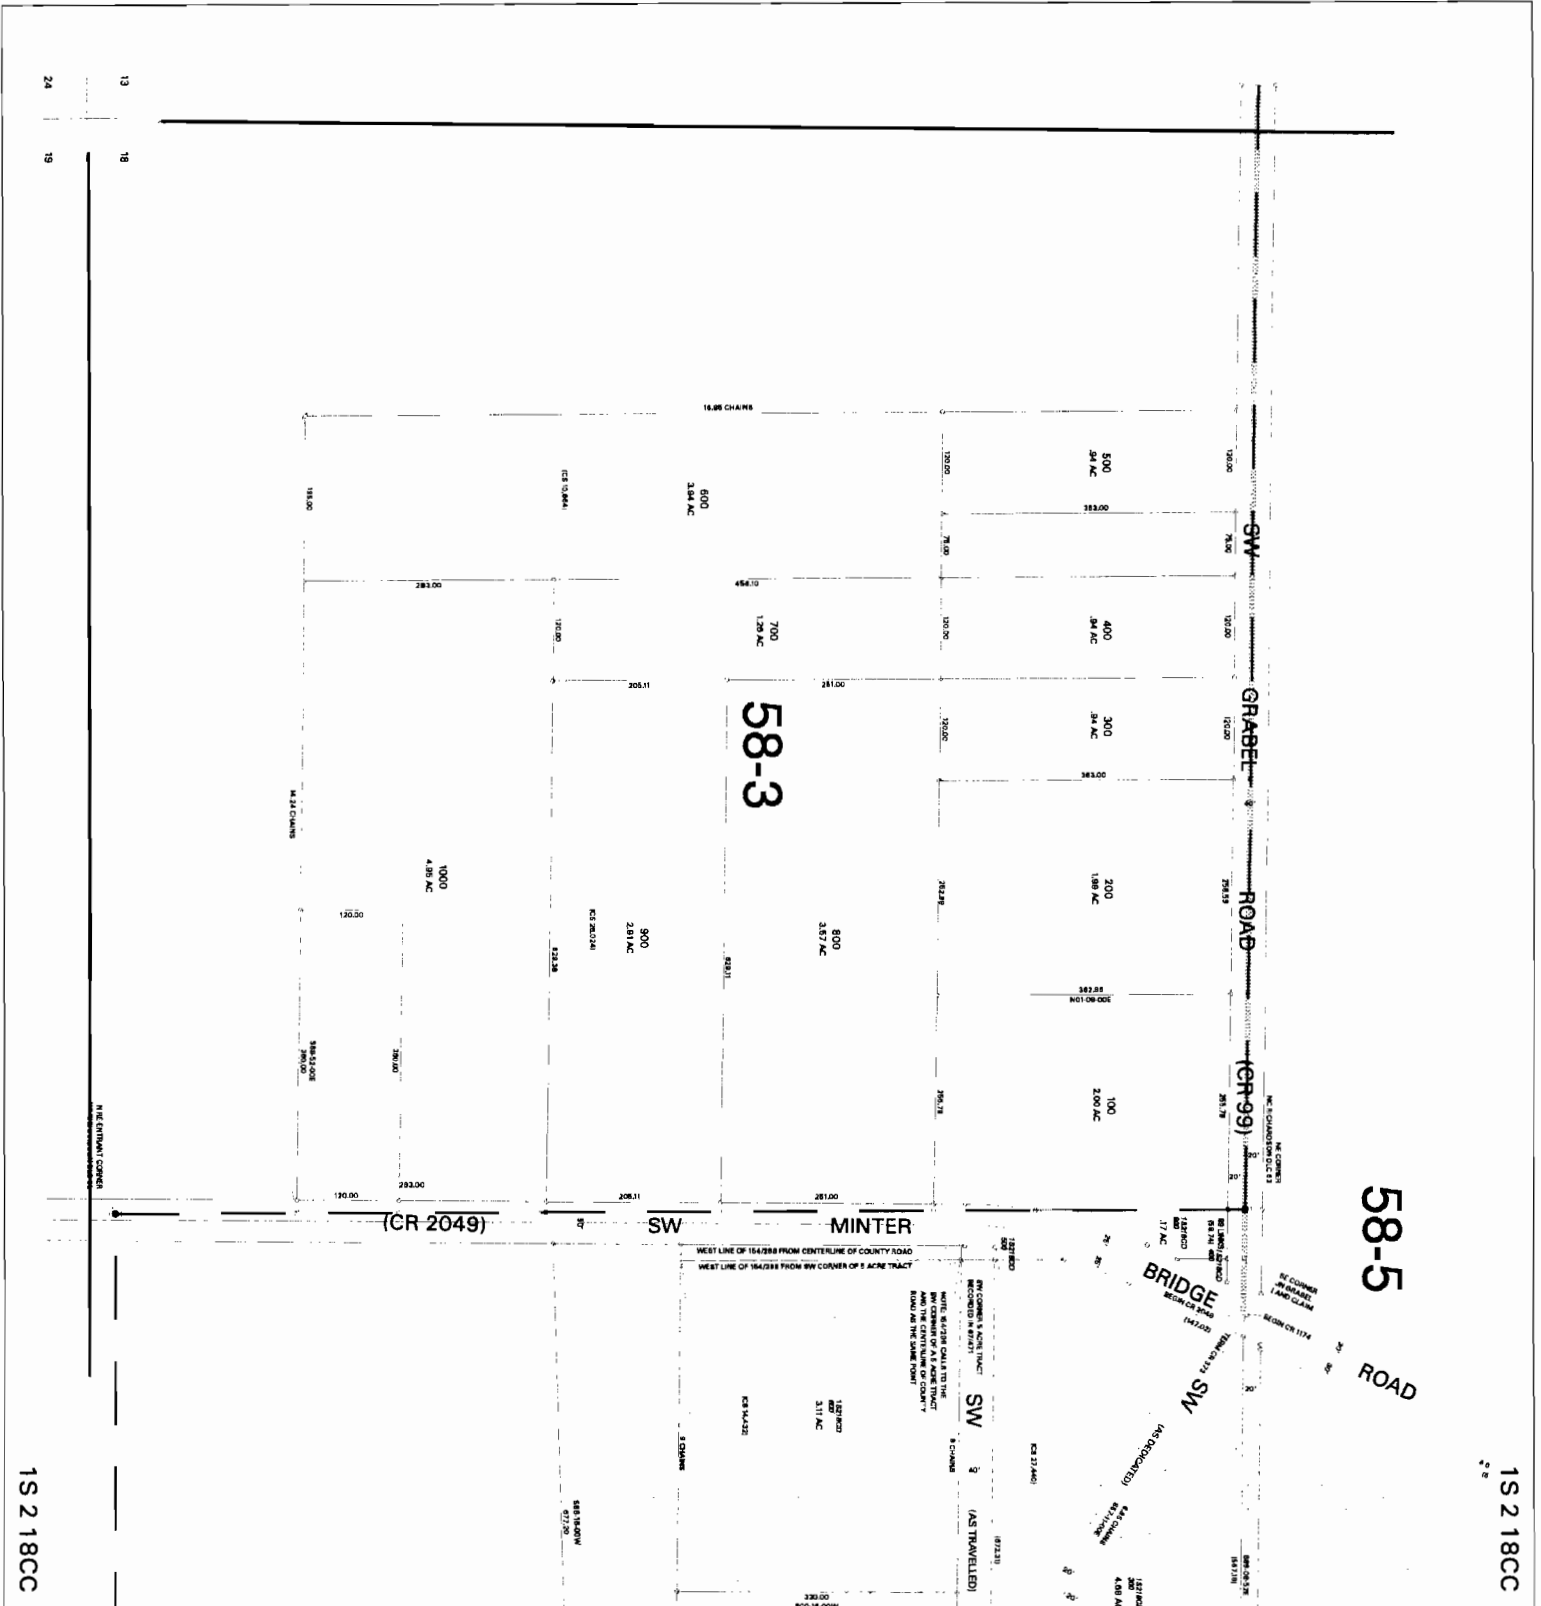

1S 2 18CC

1S 2 18CC



WASHINGTON COUNTY OREGON  
SW 1/4 SW 1/4 SECTION 18 T1S R2W W.M.  
SCALE 1" = 100'

36	31	32	33	34	35	36	31
1	6	5	4	3	2	1	6
12	7	8	9	10	11	12	7
13	18	17	16	15	14	13	18
24	19	20	21	22	23	24	19
25	30	29	28	27	26	25	30
36	31	32	33	34	35	36	31
1	6	5	4	3	2	1	6

BB	BA	AB	AA
B	A		
BC	BD	AC	AD
C	D		
CB	CA	DB	DA
C	D		
CC	CD	DC	DD
C	D		

**CARTOGRAPHY**

PLOT DATE  
January 07, 1999  
FOR ASSESSMENT PURPOSES  
ONLY - DO NOT RELY ON  
FOR OTHER USE

1S 2 18CC

1S 2 18CC