


TOWNSHIP 16 SOUTH, RANGE 22 EAST, W.M.

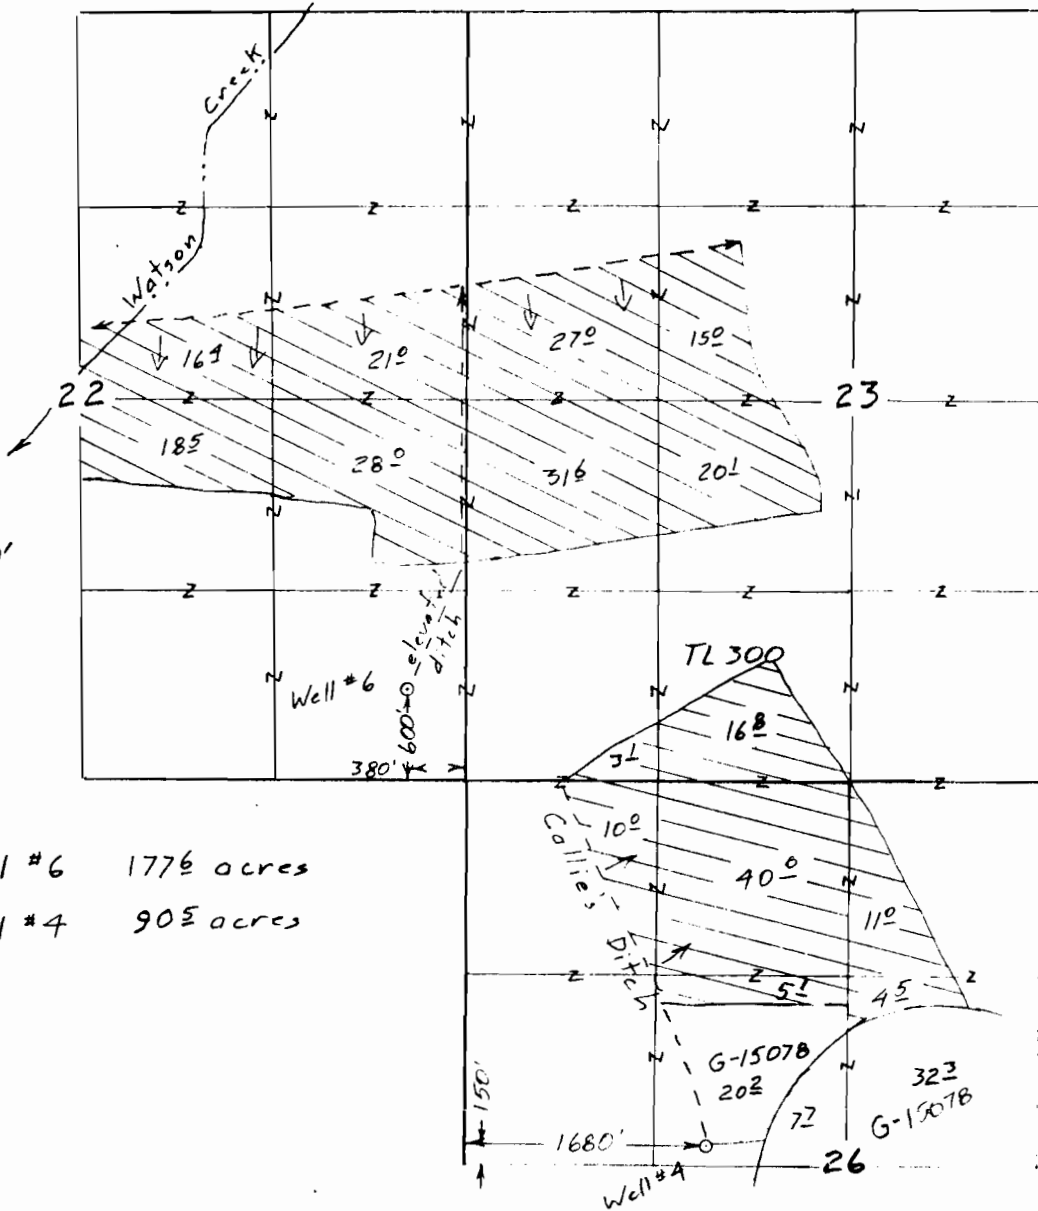


- ⊙ Well #6 1776 acres
- ⊙ Well #4 90± acres

RECEIVED

MAY 04 2009

WATER RESOURCES DEPT
SALEM, OREGON

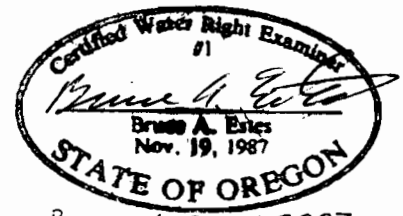

Application Map
for
Gutierrez Cattle Co

App G-16915

This map is for the purpose of locating a water right only and has no intent to provide legal dimensions or the location of property lines.

ESTES SURVEYS, LLC

PO Box 17519 Salem, OR 97306-7519 (503) 585-7593
60382 Arnold Rd Bend, OR 97702 (541) 382-7391