


# T 8 S, R 1 W, WM

MARION COUNTY

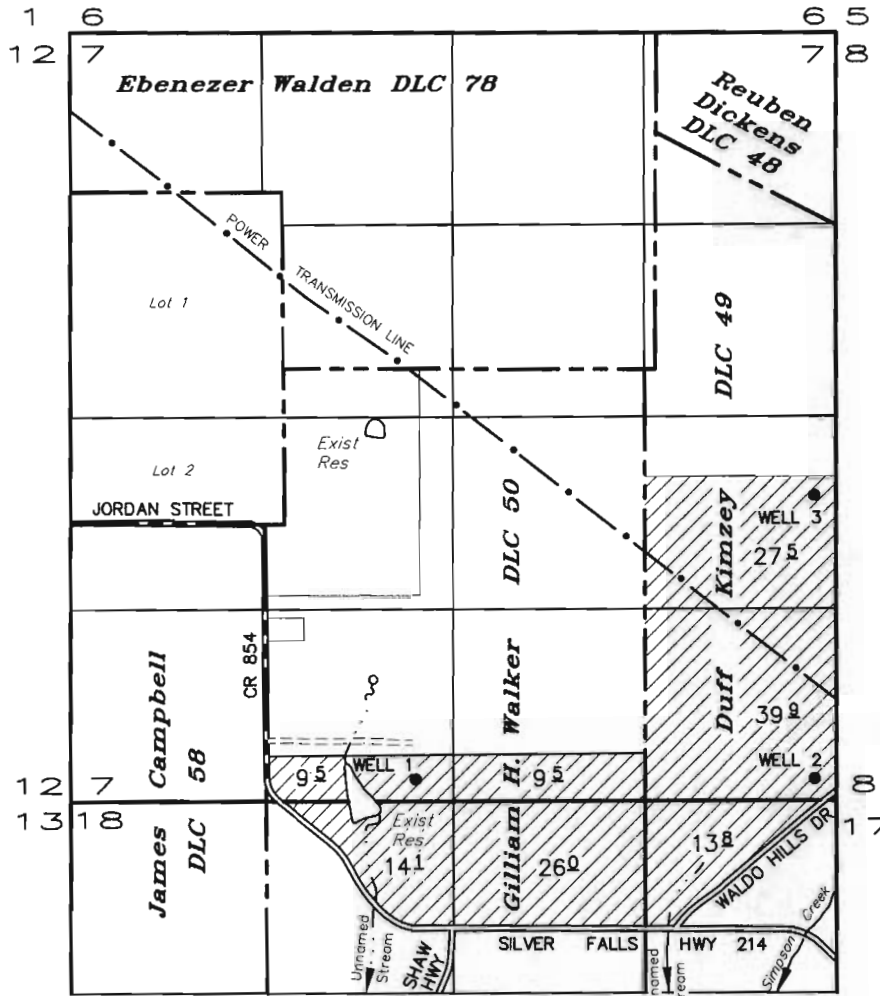

**RECEIVED**

SEP 18 2008

WATER RESOURCES DEPT  
SALEM, OREGON

TAX LOTS:

8S 1W 18 300  
8S 1W 18 301

WELL 1: 150' N & 2900' W of SE COR SEC 7  
WELL 2: 150' N & 150' W OF SE COR SEC 7  
WELL 3: 2100' N & 150' W of SE COR SEC 7

## APPLICATION TO APPROPRIATE GROUND WATER

UNDER

Application No. G-17010 Permit No. \_\_\_\_\_

IN THE NAME OF

**WIPJR1, LLC**

SCALE: 1" = 1320'

JULY 1, 2008

rev SEPTEMBER 16, 2008

NOTE: This map is for the purpose of identifying the location of water rights and has no intent to dimension or locate property ownership lines.



RENEWAL DATE 12-31-09

**LINE TYPES**

TAX LOT BOUNDARY	OLD PROPERTY LINE
ROAD RIGHT-OF-WAY	VACATED RIGHT-OF-WAY
RAILROAD	RAILROAD RIGHT-OF-WAY
STREAM, LAKE, ETC. TAX LOT BOUNDARY	STREAM, LAKE, ETC. NON-BOUNDARY
SUBDIVISION BOUNDARY	PARTITION PLAT BDY.
TAX CODE BOUNDARY	EASEMENT

**SYMBOL TYPES**


D.L.C.	
CONTROL POINTS	
SURVEY MONUMENTS	
G.L.O. CORNERS	
SECTION	
1/4 SEC	
1/16 SEC	
1/4 COR	
1/16 COR	

**NUMBERS**

TAX CODE NO.  
000 00 00 0


ACREAGE - ALL ACREAGES EXCLUDE ANY PORTION THAT MAY LIE WITHIN THE INDICATED PUBLIC RIGHT OF WAYS.

TICK MARKS - WHEN A TICK MARK IS INDICATED ON THE EXTENSION OF A LINE, THEN THE DIMENSION GOES TO THE TICK MARK. GENERALLY THIS IS USED WHEN DIMENSIONS GO INTO PUBLIC RIGHT OF WAYS.

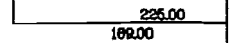

ARROWS ARE USED WITH DIMENSIONS IN AREAS OF GREATER COMPLEXITY.

**NOTICE:** This map was created for Assessor's Office use ONLY.

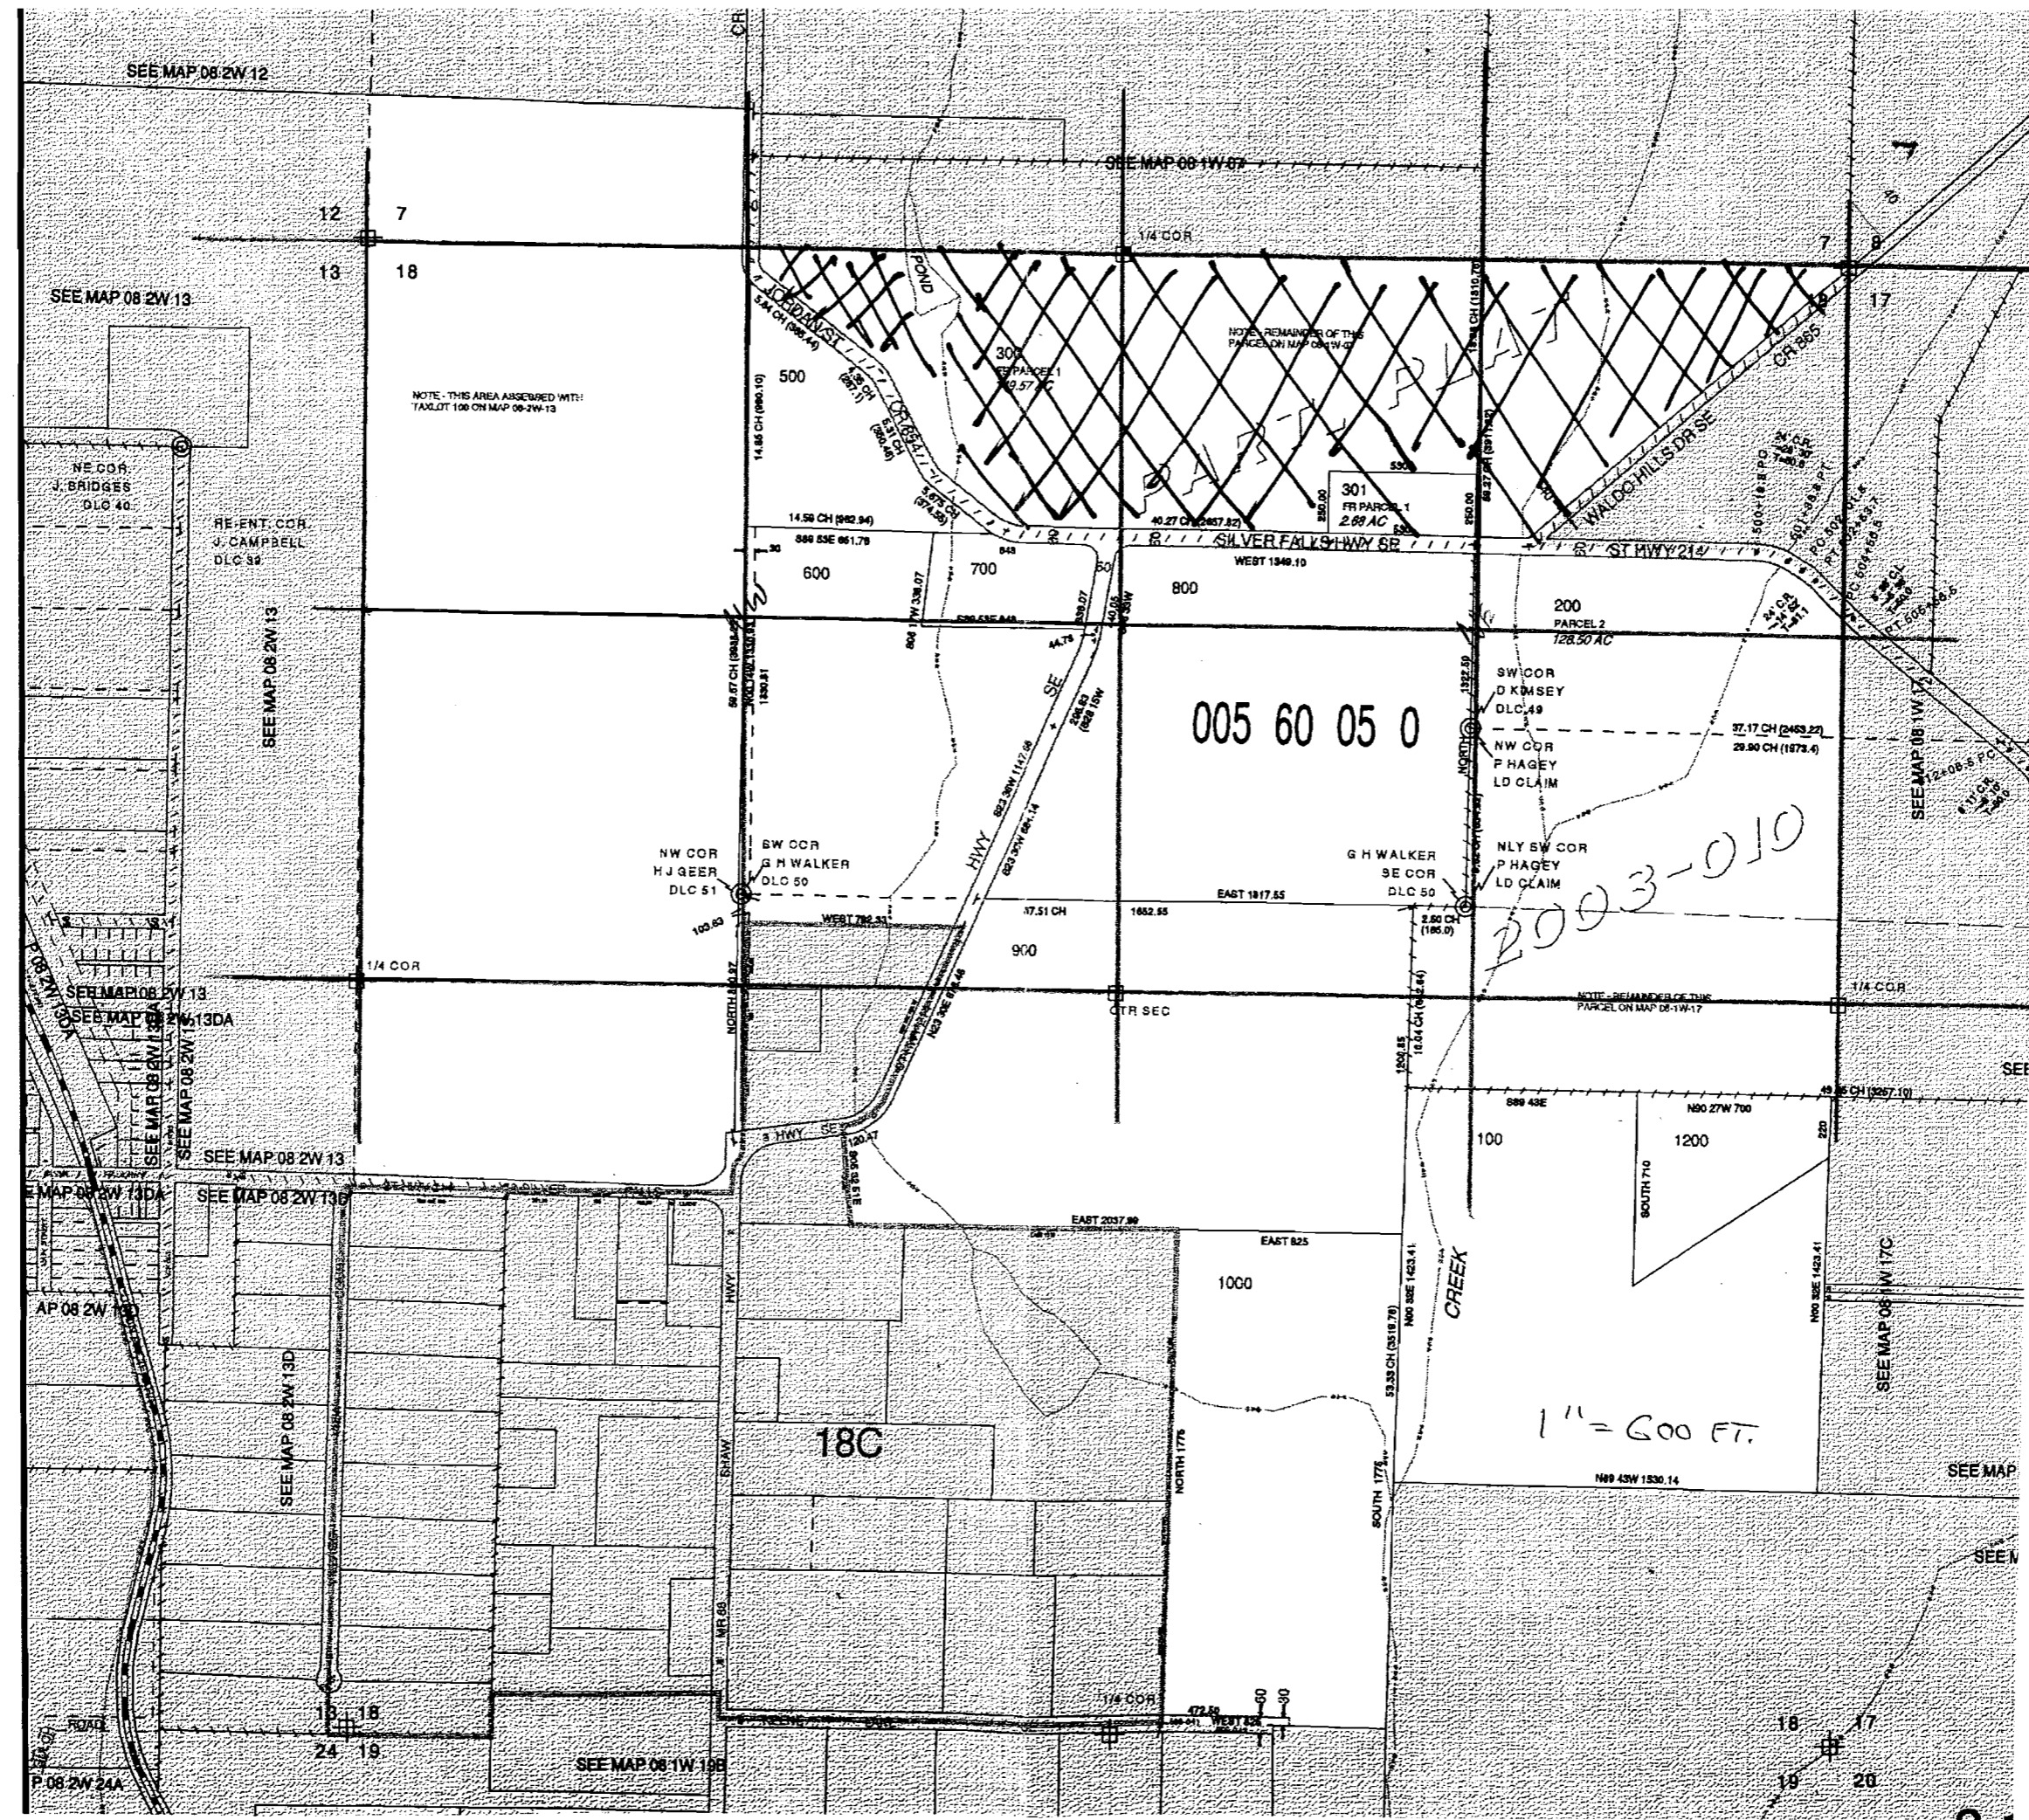

ACRES  
 NE 1/4 NW 1/4 = 14.9 ac  
 NW 1/4 NE 1/4 = 24.2 ac  
 NE 1/4 NE 1/4 = 15.5 ac  
 -----  
 54.6 ac

2003-010

RECEIVED  
 FEB 27 2008  
 WATER RESOURCES DEPT  
 SALEM, OREGON

1" = 600 FT.

**LINE TYPES**

- TAX LOT BOUNDARY    OLD PROPERTY LINE
- ROAD RIGHT-OF-WAY    VACATED RIGHT-OF-WAY
- RAILROAD    RAILROAD RIGHT-OF-WAY
- STREAM, LAKE, ETC. TAX LOT BOUNDARY    STREAM, LAKE, ETC. NON-BOUNDARY
- SUBDIVISION BOUNDARY    PARTITION PLAT BDY.
- TAX CODE BOUNDARY    EASEMENT

**SYMBOL TYPES**


- D.L.C.
- CONTROL POINTS
- SURVEY MONUMENTS
- G.L.O. CORNERS
- SECTION    1/4 SEC    1/16 SEC
- 

**NUMBERS**

TAX CODE NO.  
000.00 00 0


ACREAGE - ALL ACREAGES EXCLUDE ANY PORTION THAT MAY LIE WITHIN THE INDICATED PUBLIC RIGHT OF WAYS.

TICK MARKS - WHEN A TICK MARK IS INDICATED ON THE EXTENSION OF A LINE, THEN THE DIMENSION GOES TO THE TICK MARK. GENERALLY THIS IS USED WHEN DIMENSIONS GO INTO PUBLIC RIGHT OF WAYS.

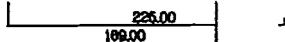

ARROWS ARE USED WITH DIMENSIONS IN AREAS OF GREATER COMPLEXITY.

**NOTICE:** This map was created for Assessor's Office use ONLY.

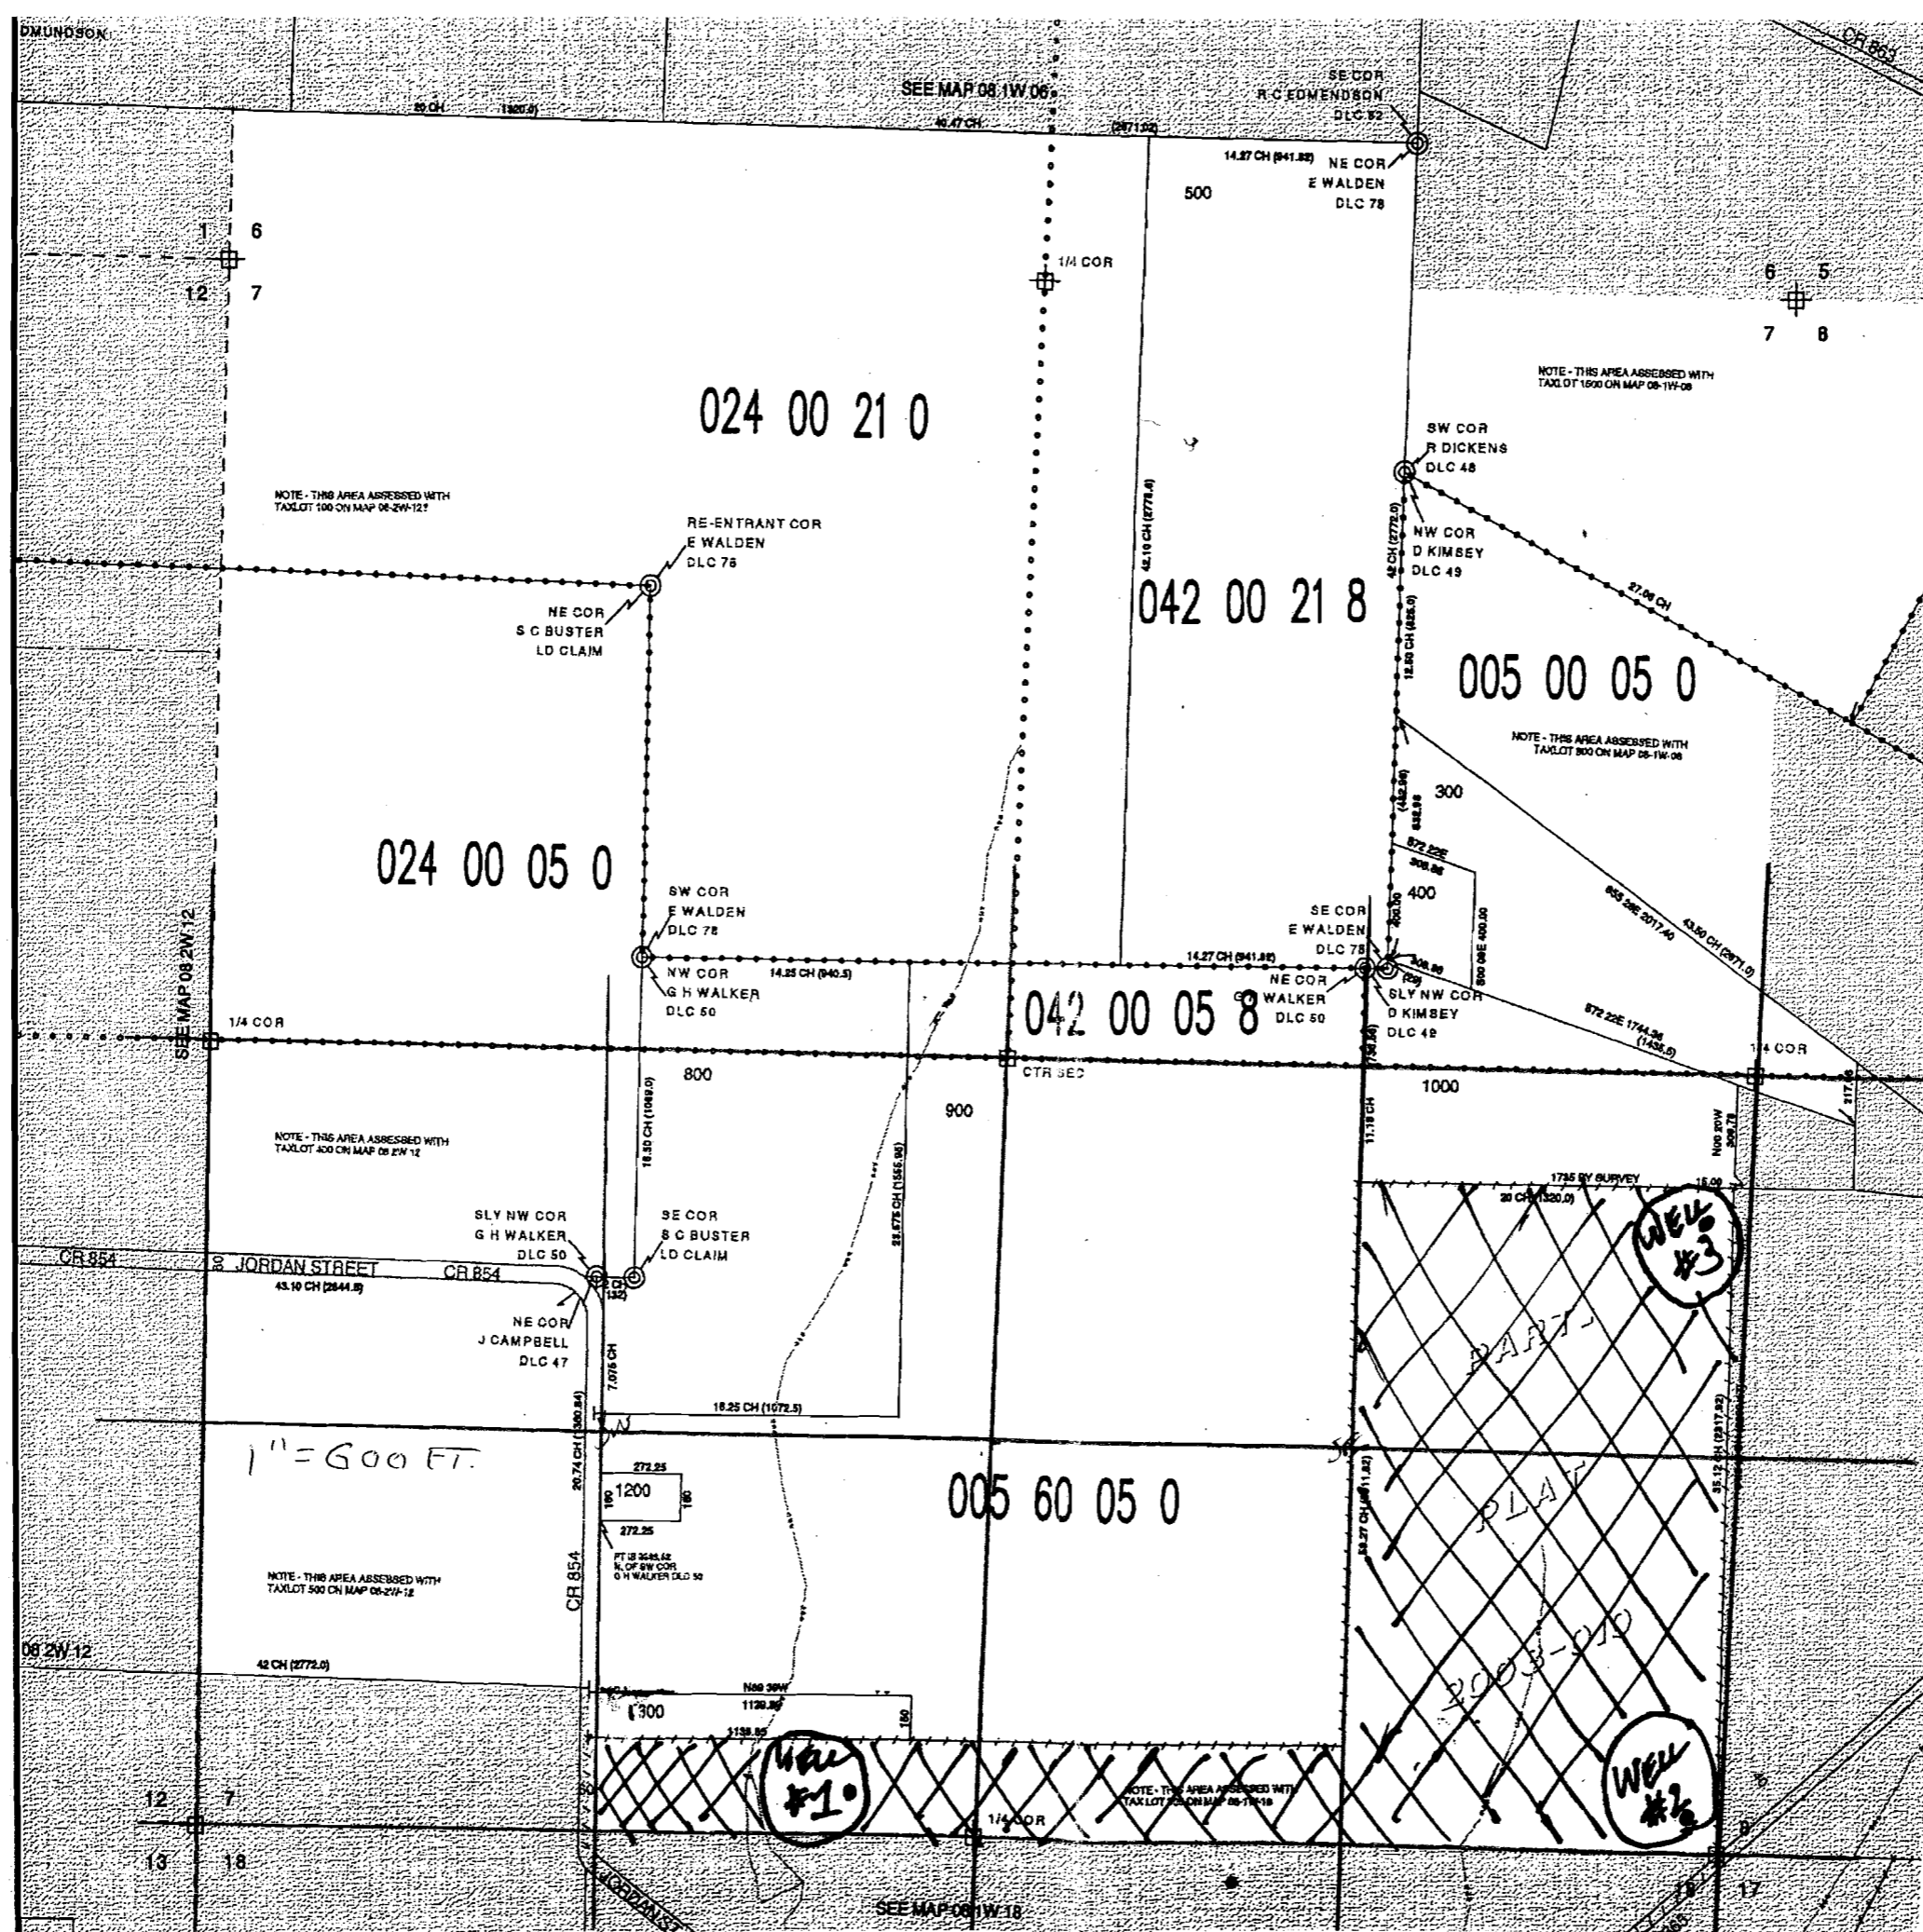

-Town-Range-Section  
NOT NEAR CLEAR ON MAP.

-LAND IN SEC 18 IN TOWN  
SECURITY GNLA O.  
WELLS VERY CLOSE.

WELL LOCATIONS:

WELL #1  
2900' W, 150' N OF SE CORNER  
OB 1W SEC 7

WELL #2  
150' W, 150' N OF SE CORNER  
OB 1W SEC 7

WELL #3  
150' W, 2100' N OF SE CORNER  
OB 1W SEC 7

ACRES  
NE 1/4 SE 1/4 = 26.4 ac  
SE 1/4 SE 1/4 = 40.0 ac  
SW 1/4 SE 1/4 = 9.5 ac  
SE 1/4 SW 1/4 = 9.5 ac  

---

85.4 ac

**LEGEND**

**LINE TYPES**

TAX LOT BOUNDARY	OLD PROPERTY LINE
ROAD RIGHT-OF-WAY	VACATED RIGHT-OF-WAY
RAILROAD	RAILROAD RIGHT-OF-WAY
STREAM, LAKE, ETC. TAX LOT BOUNDARY	STREAM, LAKE, ETC. NON-BOUNDARY
SUBDIVISION BOUNDARY	PARTITION PLAT BOY.
TAX CODE BOUNDARY	EASEMENT

**SYMBOL TYPES**


D.L.C.		
CONTROL POINTS		
SURVEY MONUMENTS		
C.L.G. CORNERS		
SECTION	1/4 SEC	1/16 SEC

**NUMBERS**

TAX CODE NO.  
000 00 00 0

ACREAGE - ALL ACREAGES EXCLUDE ANY PORTION THAT MAY LIE WITHIN THE INDICATED PUBLIC RIGHT OF WAYS.

TICK MARKS - WHEN A TICK MARK IS INDICATED ON THE EXTENSION OF A LINE, THEN THE DIMENSION GOES TO THE TICK MARK. GENERALLY THIS IS USED WHEN DIMENSIONS GO INTO PUBLIC RIGHT OF WAYS.

 


ARROWS ARE USED WITH DIMENSIONS IN AREAS OF GREATER COMPLEXITY.

**NOTICE: This map was created for Assessor's Office use ONLY.**



SCALE 1" = 400'  
or 1:4800

Plot file created: August 10, 2004  
Asst. Asst. 081w07.01 w/boster

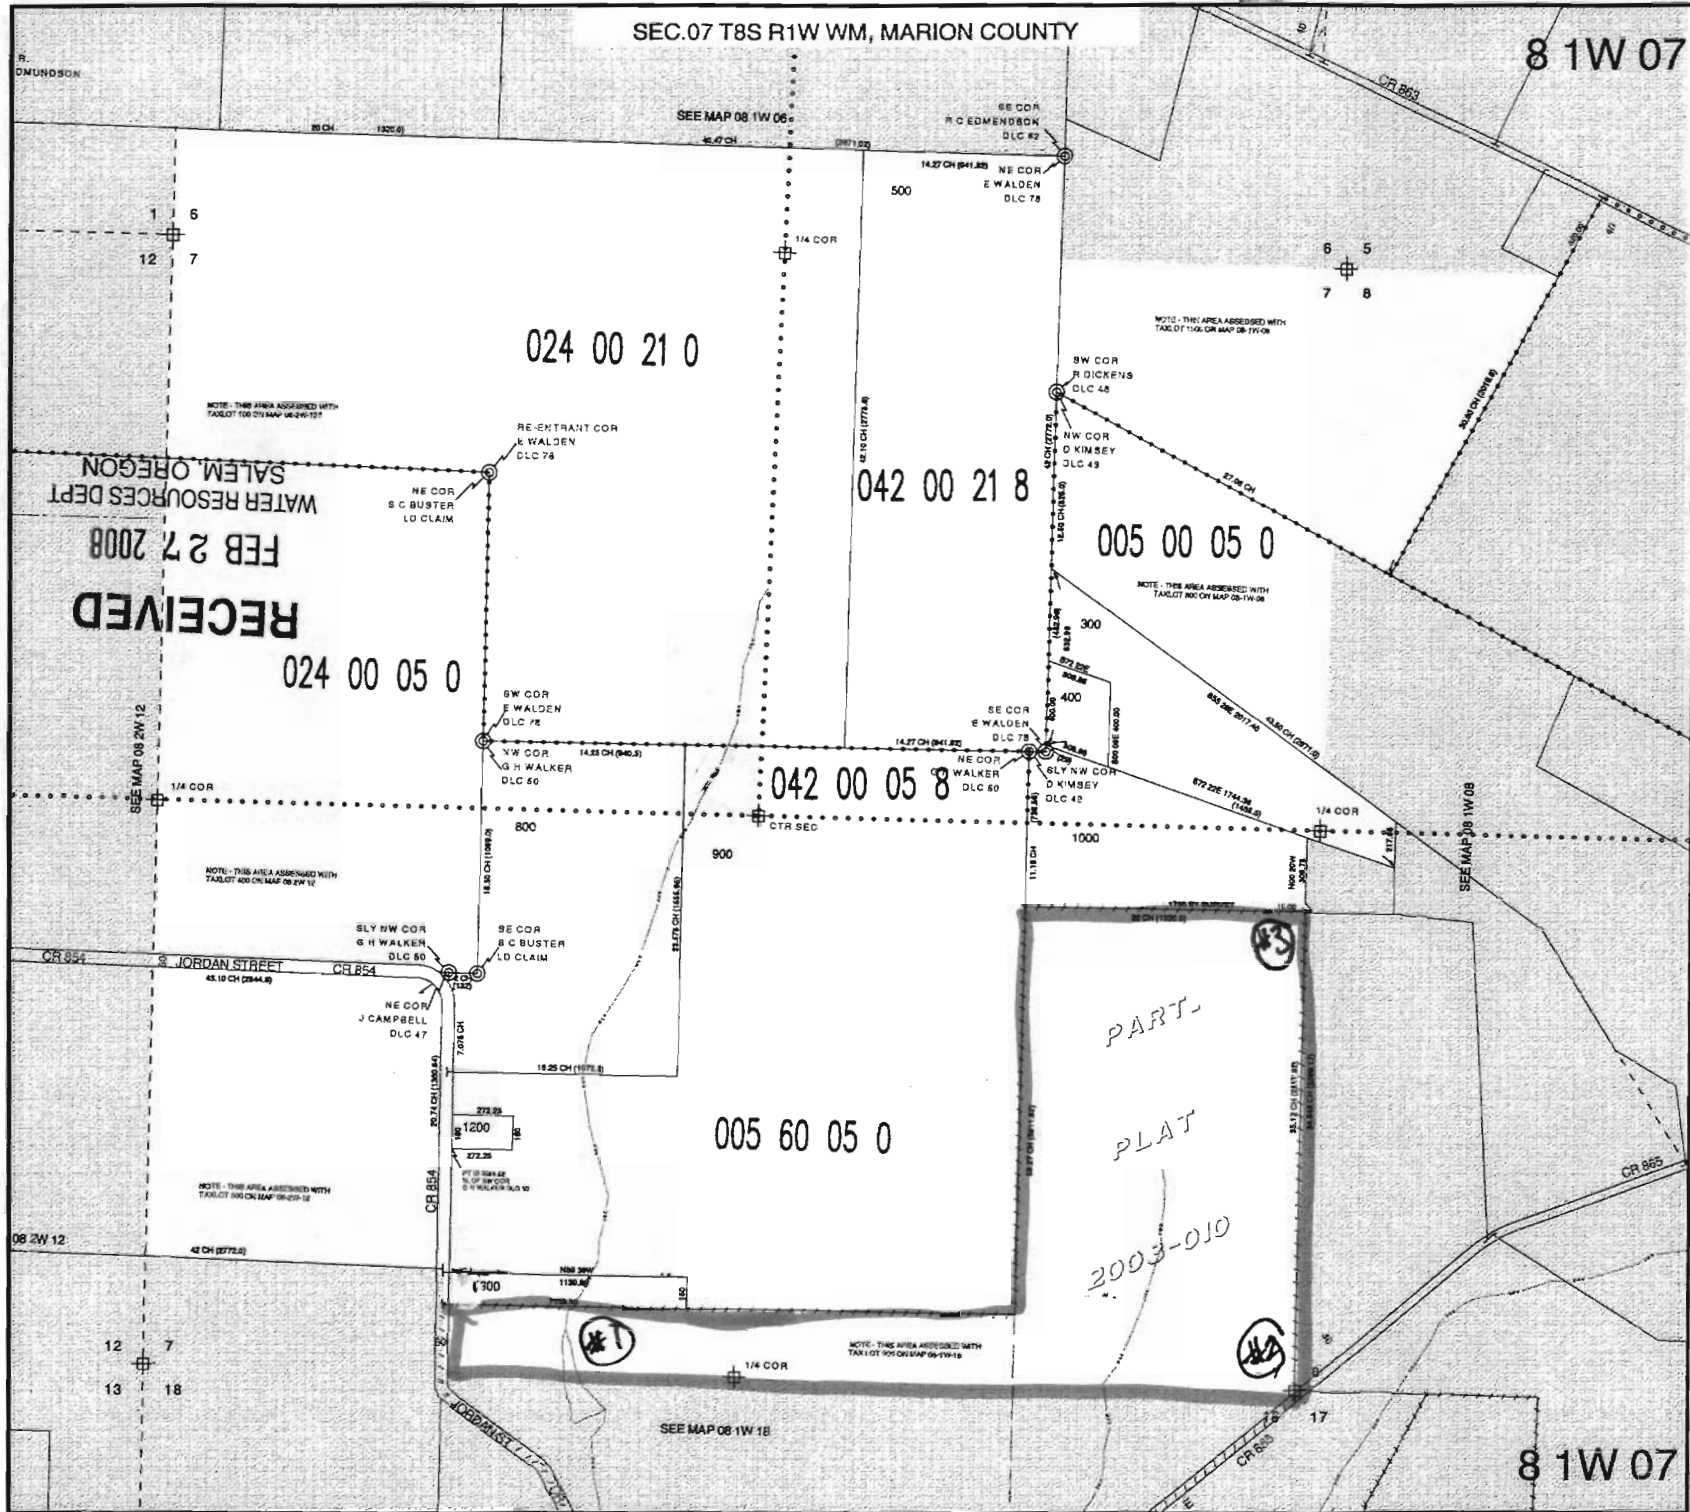

**LEGEND**

**LINE TYPES**

- TAX LOT BOUNDARY      OLD PROPERTY LINE
- ROAD RIGHT-OF-WAY      VACATED RIGHT-OF-WAY
- RAILROAD      RAILROAD RIGHT-OF-WAY
- STREAM, LAKE, ETC. TAX LOT BOUNDARY      STREAM, LAKE, ETC. NON-BOUNDARY
- SUBDIVISION BOUNDARY      PARTITION PLAT B.O.Y.
- TAX CODE BOUNDARY      EASEMENT

**SYMBOL TYPES**


- D.L.C.
- CONTROL POINTS
- SURVEY MONUMENTS
- C.L.O. CORNERS
- SECTION      1/4 SEC      1/16 SEC

**NUMBERS**

TAX CODE NO.  
000 00 00 0

ACREAGE - ALL ACREAGES EXCLUDE ANY PORTION THAT MAY LIE WITHIN THE INDICATED PUBLIC RIGHT OF WAYS.

TICK MARKS - WHEN A TICK MARK IS INDICATED ON THE EXTENSION OF A LINE, THEN THE DIMENSION GOES TO THE TICK MARK. GENERALLY THIS IS USED WHEN DIMENSIONS GO INTO PUBLIC RIGHT OF WAYS.

 


ARROWS ARE USED WITH DIMENSIONS IN AREAS OF GREATER COMPLEXITY.

**NOTICE:** This map was created for Assessor's Office use ONLY.



SCALE 1" = 400'  
or 1:4800

Plot file created: June 21, 2004  
/s:/maps/081w18.dwg

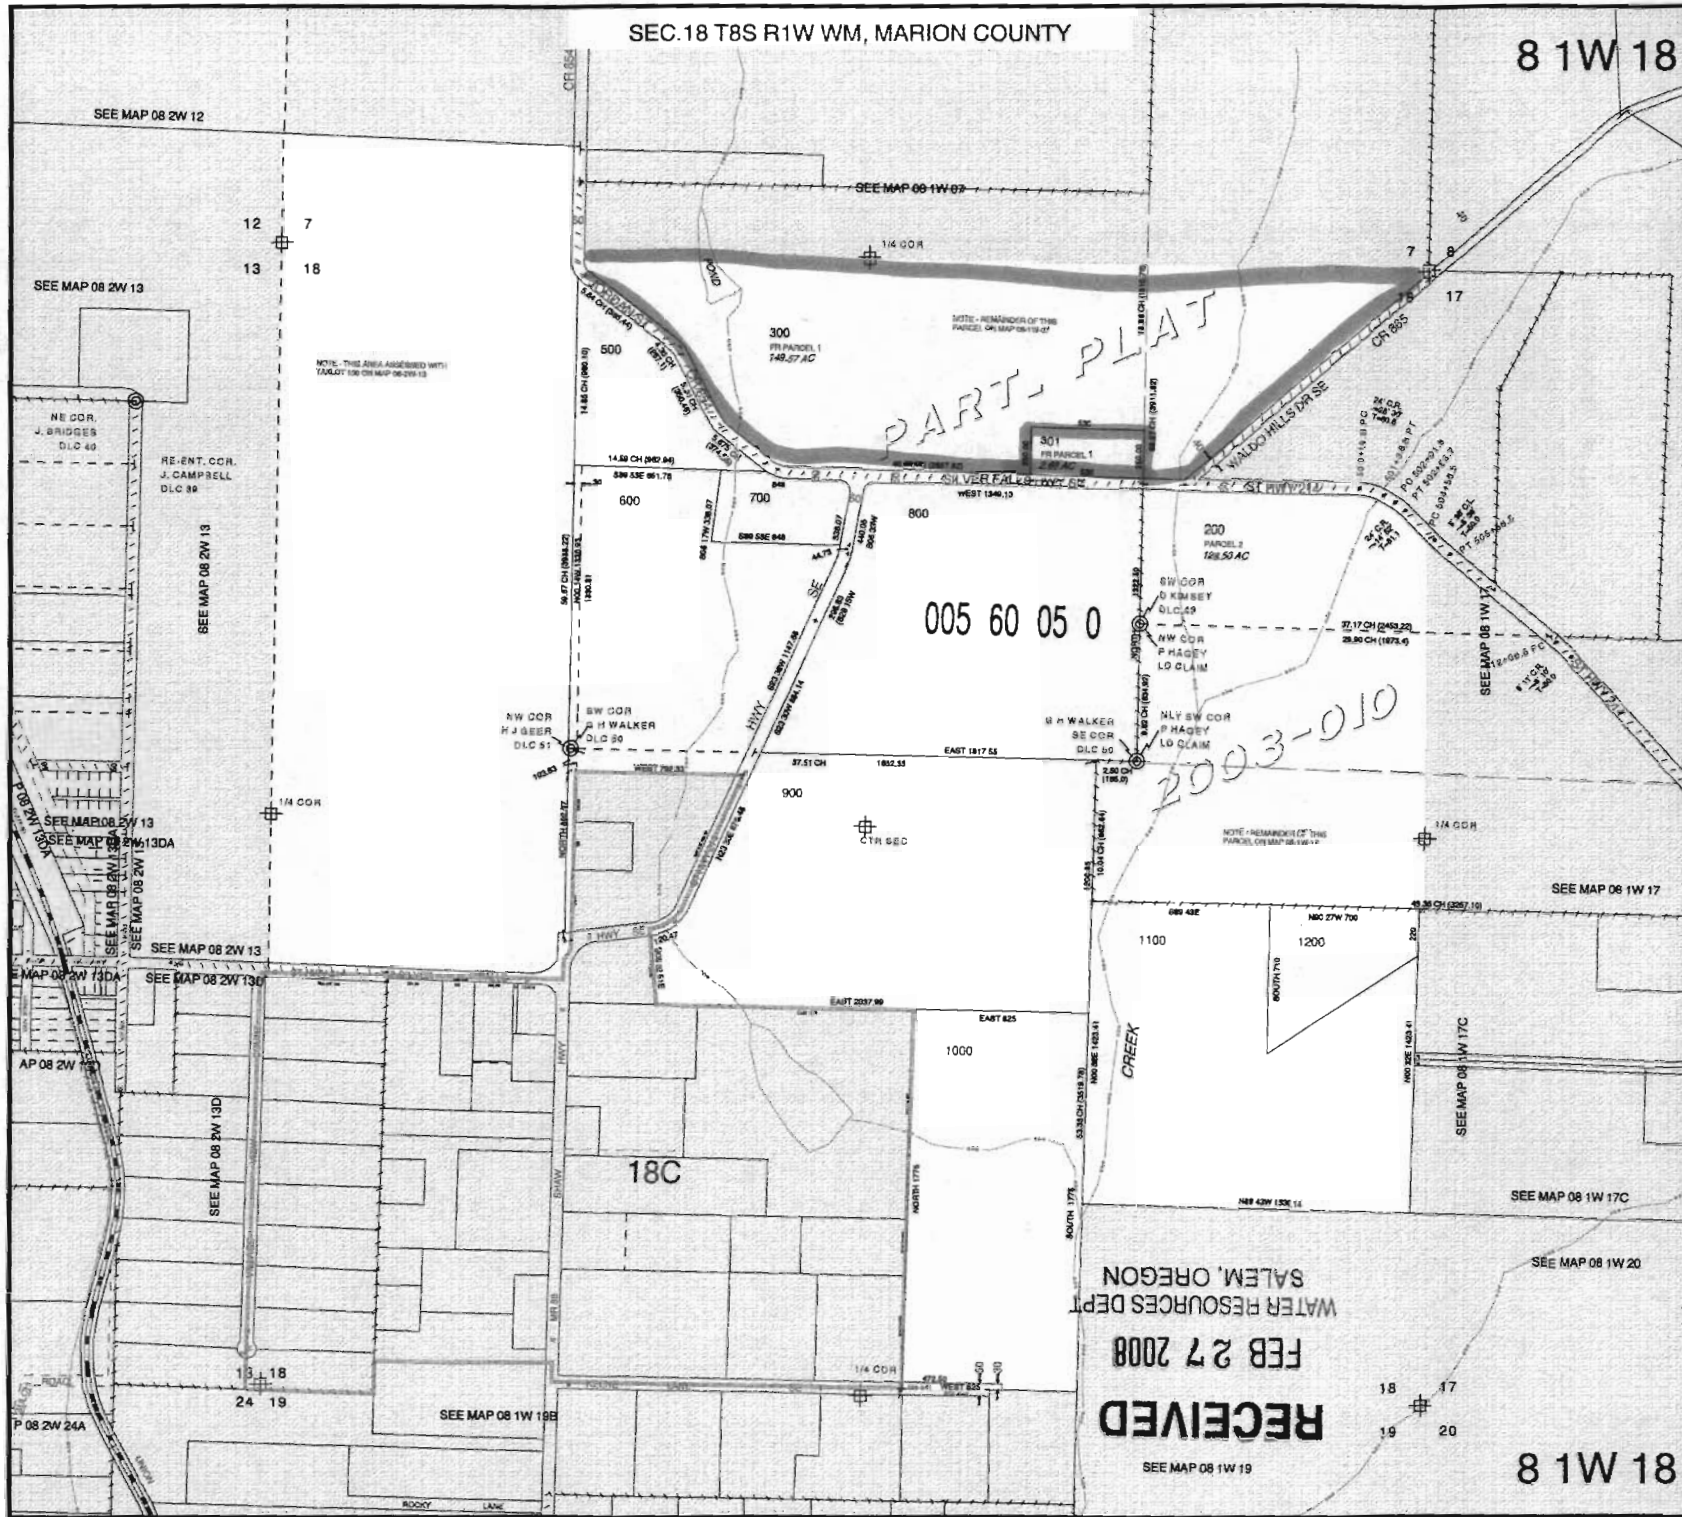

RECEIVED  
FEB 27 2008  
WATER RESOURCES DEPT  
SALEM, OREGON

8 1 W 18

8 1 W 18