


Amended map for well proposed location
August 2009

T 39 S, R 19 E, WM
SECTION 15

Application G-17124

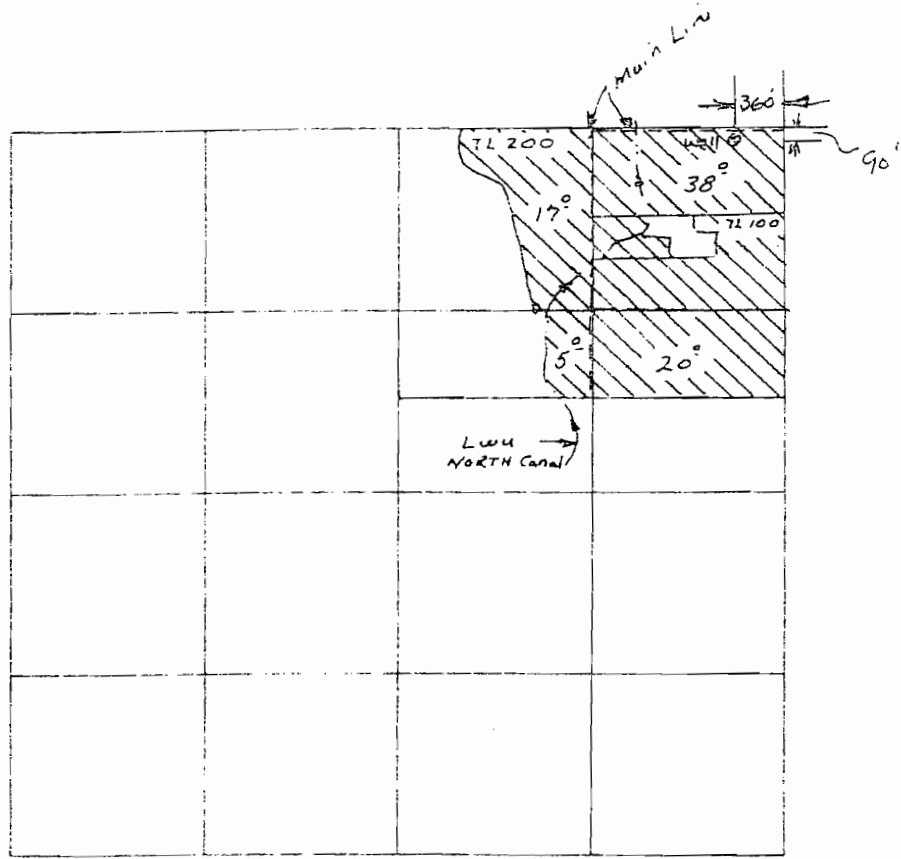

Well Located 90' S, 360' W from the NE' Corner
SEC 15.

SCALE 1" = 1320'

RECEIVED

SEP 02 2009

WATER RESOURCES DEPT
SALEM, OREGON