


TOWNSHIP 6 SOUTH, RANGE 3 WEST, W.M.
SECTION 12

01050

Application No. G-12672
Permit No.

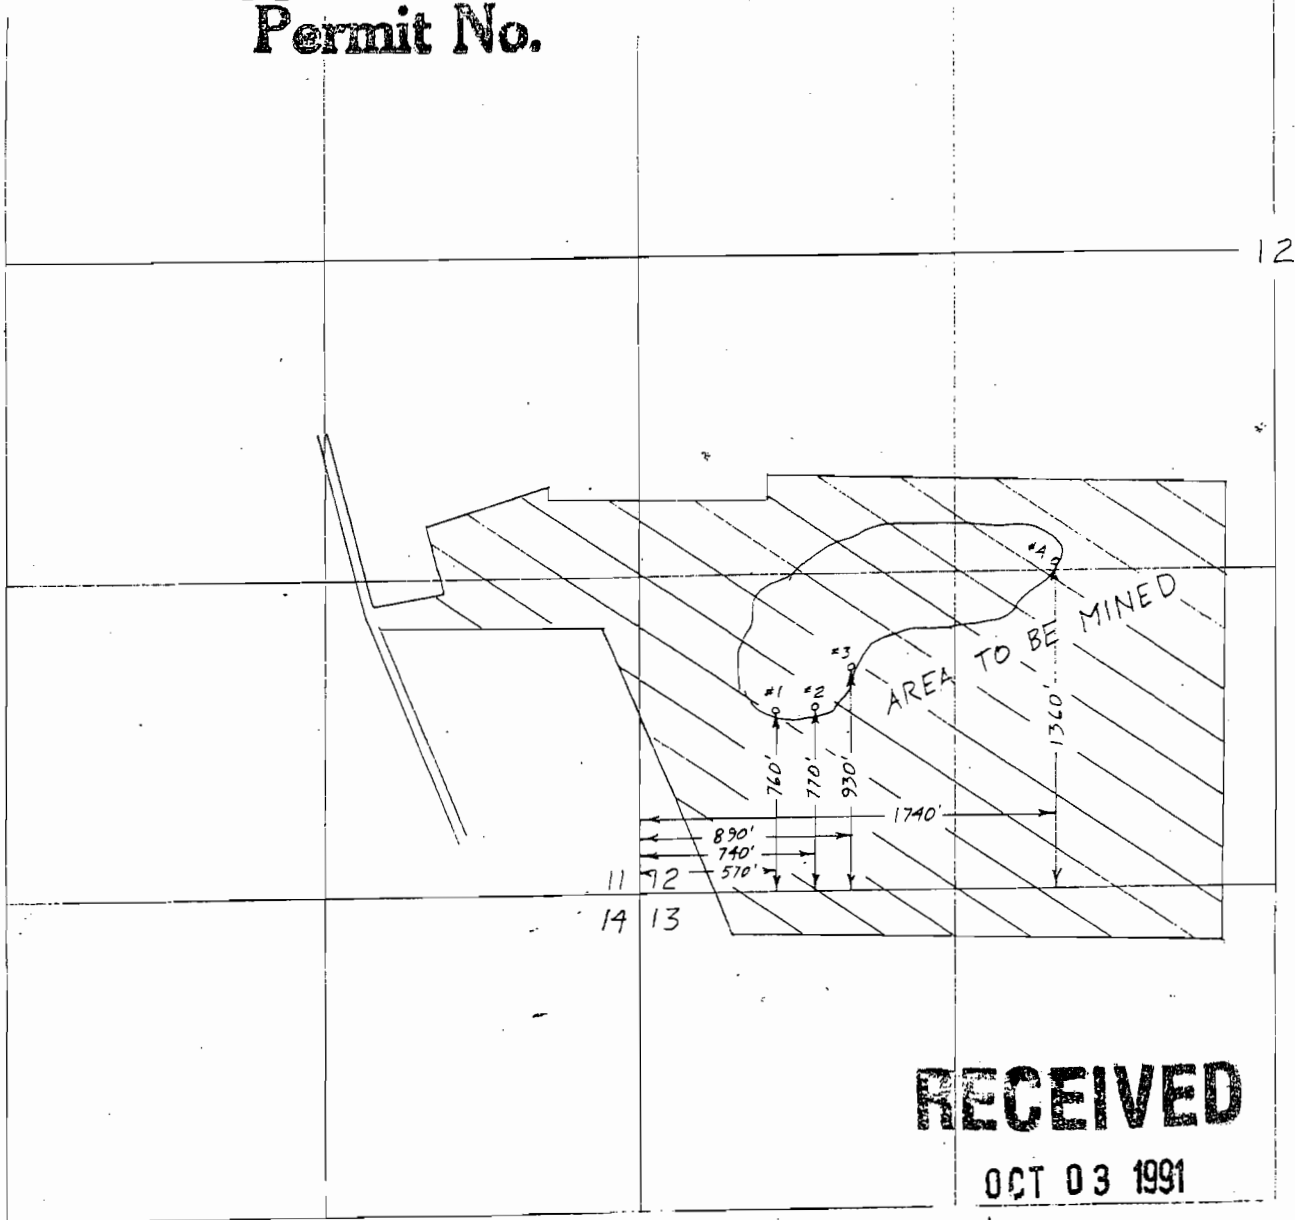


RECEIVED

OCT 03 1991

WATER RESOURCES DEPT.
SALEM, OREGON

Water Right Application Map
for
MORSE BROS., INC

(Reed Pit)

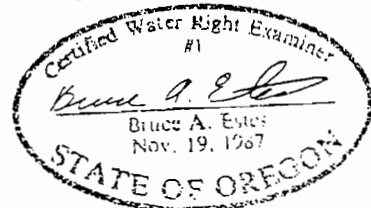

This map is for the purpose of locating a water right only and has no intent to provide legal dimensions or the location of property lines.