G-17297

RECEIVED
JAN 05 2010
WATER RESOURCES DEPT
SALEM, OREGON

T.4&5S.R.2&3W.W.M.

New Acres

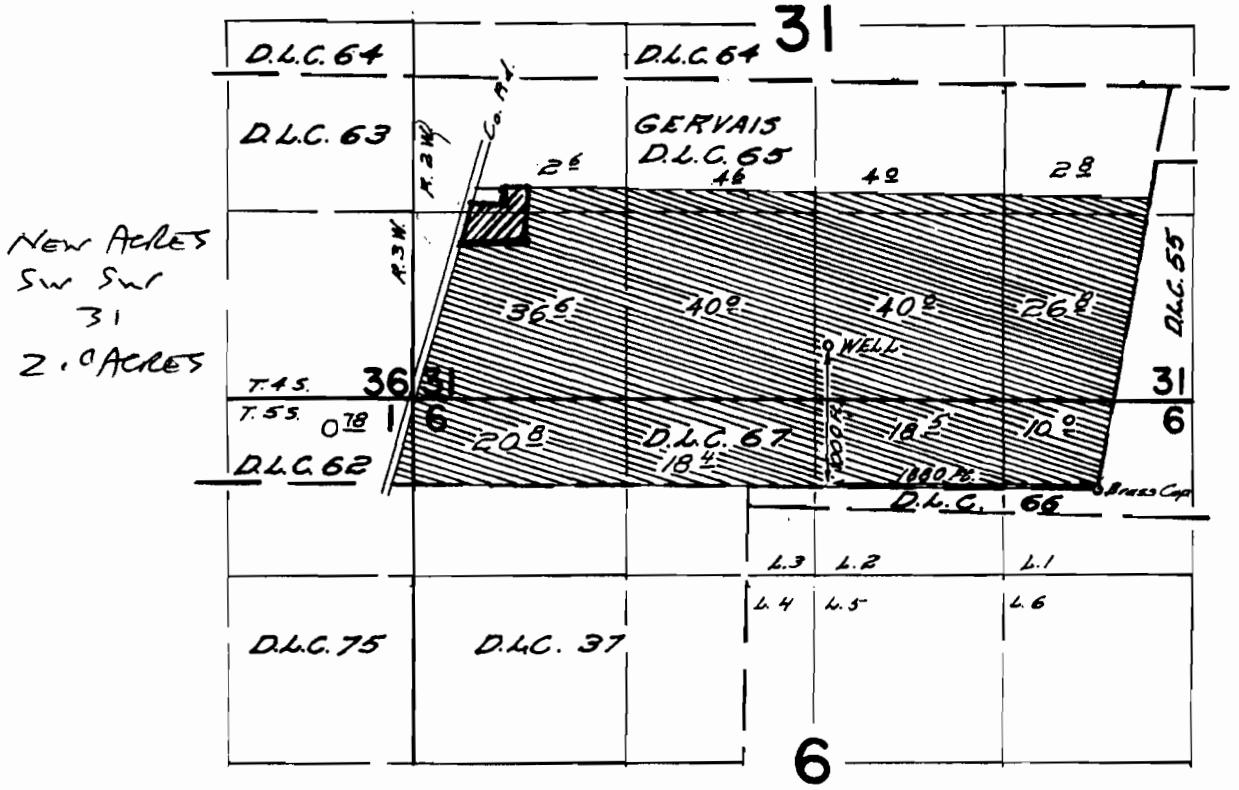

1" = 1320 ft.

1/16" = 82.5'

FINAL PROOF SURVEY
UNDER

Application No. G-3544 Permit No. G-3479
IN NAME OF

RALPH A. CASE

Surveyed April 12 1968, by V.J. Ruppert

1968-J.