

8-3

WORK COPY

SCALE REMAINS APPROX ORIGINAL  
 1" = 200 FEET

CORRECTED DISTANCES FROM EAST 1/4 CORNER  
 690 FE WEST & 130 FE NORTH

NOTES 35

1992-20  
 PARCEL 1  
 PARCEL 2

JOY LANE

See Map 5N 28 35D


Initial & Date  
 Jm 3-30-10



5N 28 35A

See Map 5N 28 35B

EAST 1/4 Cor.

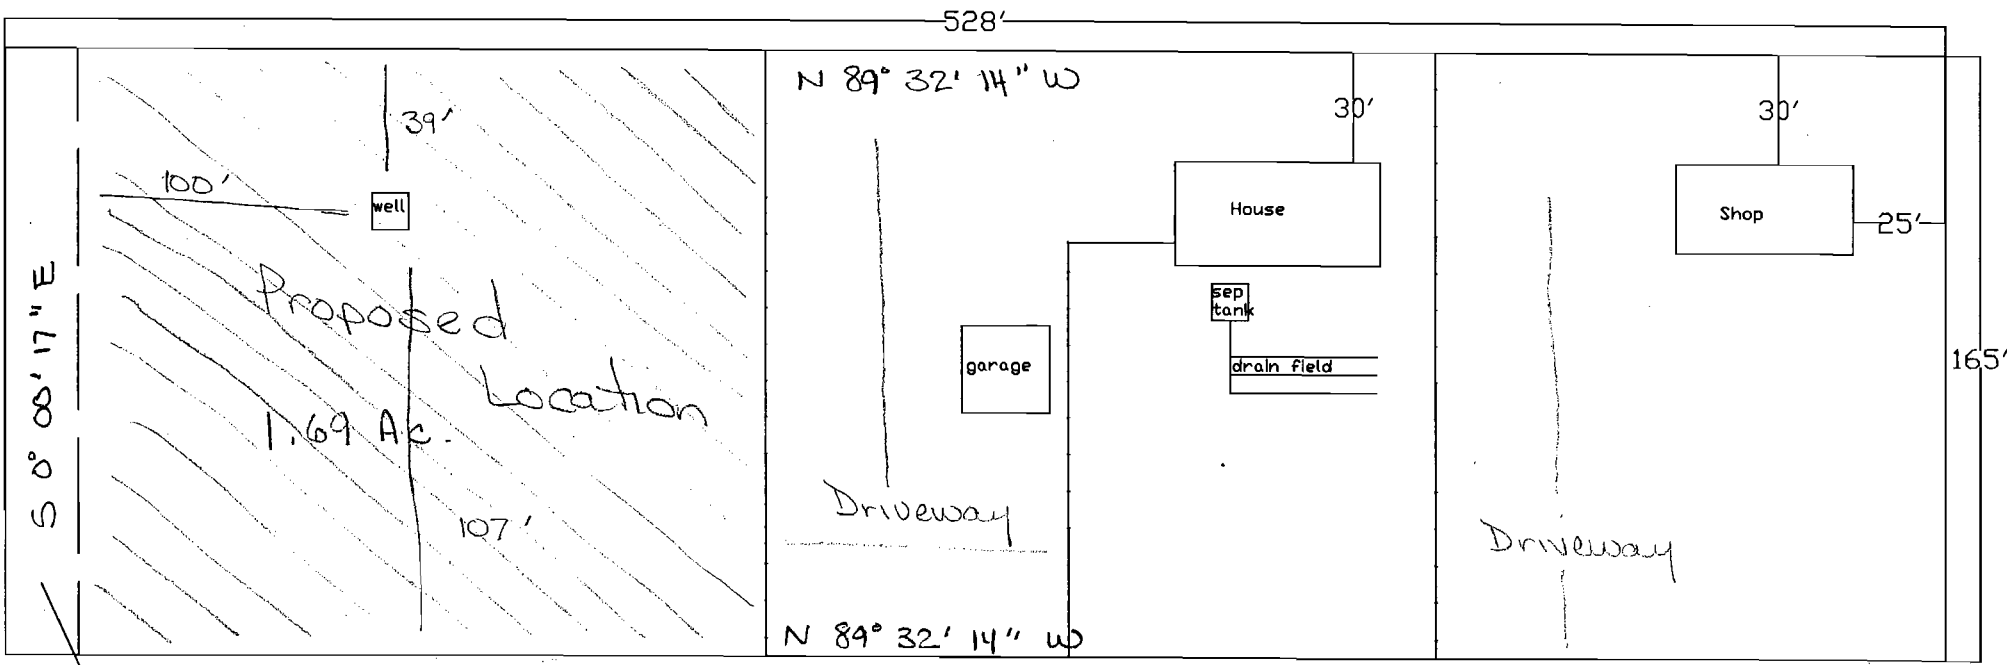

S 0° 08' 17" E

20' easement



5N 28 35 A 304 8-3

**RECEIVED**  
 MAR 29 2010  
 WATER RESOURCES DEPT  
 SALEM, OREGON