

# SECTION PLAT

G-17489

Section 17 & 18


Township 26-5

Range 30-E

County of Harney

State of OR

NORTH

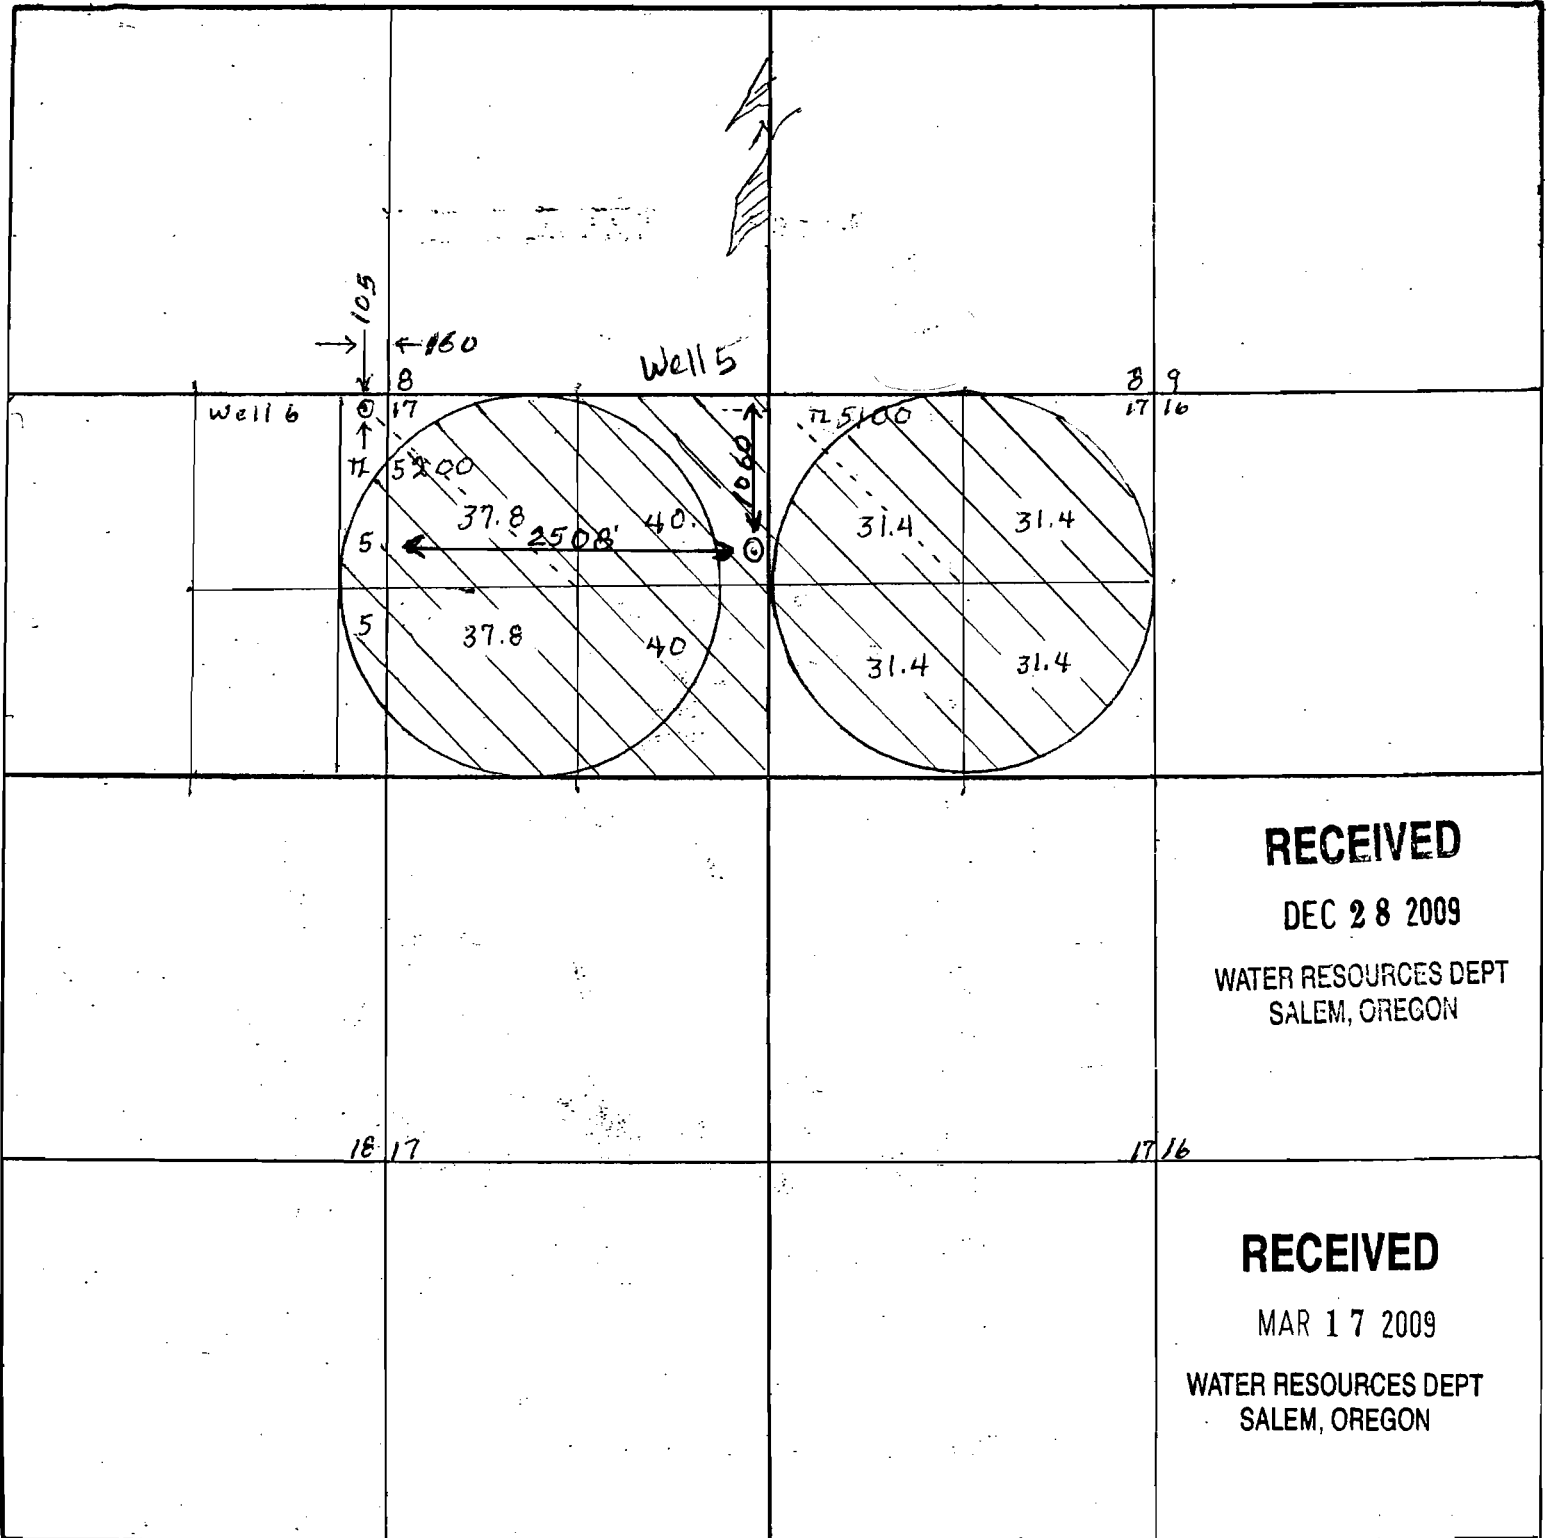

**RECEIVED**

DEC 28 2009

WATER RESOURCES DEPT  
SALEM, OREGON

**RECEIVED**

MAR 17 2009

WATER RESOURCES DEPT  
SALEM, OREGON

Remarks scale -  $\frac{4}{8}'' = 1 \text{ mile} - 660'$  -